

GEODETTIC SURVEY OF N.S.W.

CENTRAL MAPPING AUTHORITY

GEODETTIC STATION RECONNAISSANCE and MAINTENANCE REPORT

STATION: *6644* No.: *6644*

MAP SHEET SCALE 1:250 000

INSPECTED BY: *P. BERTS* DATE: *30.9.80*

AUTHORITY: *C.M.A.* FIELD BOOK: *1810*


- Description: *260*
- Note: *Cross out word or words which do not apply*
- Cleared by lanes bearing..... from Trig. Mast
 - Mast & Vanes have been painted white & black respectively. ✓
 - The ~~station~~/pillar was ~~unplaced~~/~~not~~ ~~drilled~~/~~constructed~~ on.....*3-9*.....*19*..... dimensions now being: Description of mark *1/5* ~~stone~~ ~~base~~ should be explicit, e.g., S/Steel Pillar Plate, Steel plug, Brass plug, Bolt, G.I. Pipe
 - Height of mark.....*1.375*.....m. above ~~rock~~/~~concrete~~; Mark is *1.535*.....m. above G.L.
 - Height of Top Vanes to Top ~~Mark~~/Pillar plate *1.465*.....m. Diameter of Vanes (vertical) *0.750*.....m.
 - Height of Cairn.....m. Diameter of Cairn.....m. Name Plate ~~found~~/~~missing~~/~~placed~~.
 - Length of Mast.....m. (approximate if not unpled)
 - A. *Copper Nail*.....set in ~~stone~~/~~rock~~ has been placed/~~found~~, bearing.....*289*°M from ~~Mast~~/~~Plug~~/~~Pillar~~
 - A. *Brass Trig. Plate*.....set in ~~stone~~/~~rock~~ has been placed/~~found~~, bearing.....*45*°M from ~~Mast~~/~~Plug~~/~~Pillar~~
 - A. *Old Conc. Pillar*.....set in ~~conc~~/~~rock~~ has been placed/~~found~~, bearing.....*2*°M from ~~Mast~~/~~Plug~~/~~Pillar~~
 - A.....set in ~~conc~~/~~rock~~ has been placed/~~found~~, bearing.....°M from ~~Mast~~/~~Plug~~/~~Pillar~~
 - Action required: *NOTE: Old Conc. Pillar DESTROYED 30.9.80*

STANDPOINT: *CONC OBS PILLAR (REAR)*

Mark	Direction	Horiz. Distance	Height Difference	Mark	Direction	Horiz. Distance	Height Difference
			above standpt. / below standpt.				above standpt. / below standpt.
<i>DIRECTIONAL (S)</i>	<i>0 00 00</i>		above standpt.	<i>DIRECTIONAL (S)</i>	<i>0 00 00</i>		above standpt.
<i>Copper Nail</i>	<i>109 40 20</i>	<i>4.027</i>	above standpt.	<i>CONC OBS PILLAR (FR)</i>	<i>96 45 00</i>	<i>4.230</i>	above standpt.
<i>OLD PILLAR SPIGOT</i>	<i>238 07 20</i>	<i>2.980</i>	below standpt.	<i>Copper Nail</i>	<i>121 01 00</i>	<i>7.353</i>	above standpt.
<i>BRASS TRIG PLATE</i>	<i>274 46 20</i>	<i>4.235</i>	below standpt.	<i>OLD PILLAR SPIGOT</i>	<i>121 37 00</i>	<i>7.723</i>	above standpt.
<i>CONC OBS</i>	<i>283 07 00</i>		below standpt.	<i>CONC OBS</i>	<i>283 05 40</i>		above standpt.
			above standpt. / below standpt.				above standpt. / below standpt.

Prepared by: *P. BERTS* 30.9.80

Checked: *P. BERTS* 30.9.80

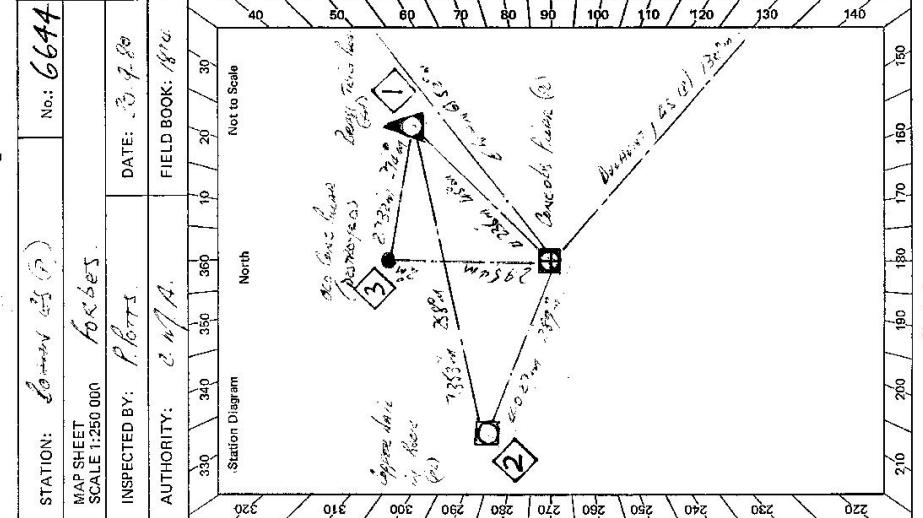

Not to Scale

Station Diagram

North

40 50 60 70 80 90 100 110 120 130 140

320 310 300 290 280 270 260 250 240 230

330 340 350 360 370 380 390

210 200 190 180 170 160 150

Checked

Noted on U.T.M. Card

et:2735-2 D. West, Government Printer

STATION Station 6644

Owner's Name: THE RESERVE Current Occupant: RAMSAY COMPANY

Address: ROUNGE LANE, BERRARD, NIUE Address: 110 CONWAY STREET, THE CITY, OCEAN GROVE

Phone: Phone:

ACCESS

Access Report of 30/9/1980 was found suitable/unsuitable.

1 KM. FEATURE

000 RAILWAY HOTEL - HOTEL OCEAN GROVE, AT INTERSECTION

APPROX - 600000000 - TRUCKLE REGION - UNUSUAL ROAD

200 MET BOUNDS ON RIGHT, CROSS RAILWAY LINE & TURN LEFT

200 CROSSWAY INTERSECTION

350 TURN RIGHT

380 TURN RIGHT - IRON GATE & THEN TURN RIGHT ALONG

800 TRACK ALONG FENCE LINE

900 DOUBLE IRON GATES FOR LEFT, THEN KICKY ALONG

1000 TOP OF CONTOUR BANK

1000 NINE GATES, THEN LEFT & ALONG ALONG CONTOUR


1070 BANK TO WIDE GATE AT FENCE CORNER.

1100 CROSS CONTOUR BANK, WIDE GATE & THEN TURN RIGHT,

1490 IRON GATE ALONG FENCE

1490 TURN LEFT AT GATE & FOLLOW ROAD TRACK TO TOP OF HILL

1490 OCEAN GROVE STATION

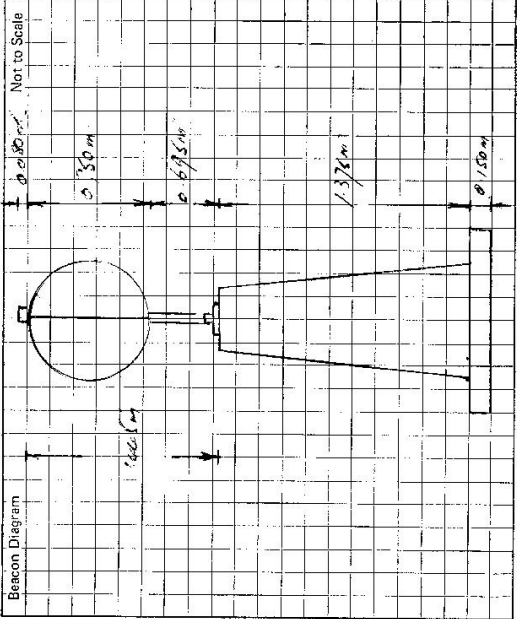

This section to be completed by officer constructing pillar.

Original station mark found/~~not found~~.

Description of mark: Rock Trig Pole

Original beacon found/~~not found~~.

Description of beacon: Box, Pole & Disc

Height Top of Vanes to Top Mark 3.165 m.

Height of mark 0.95 m. above below rock/corn above G.L. below

Diameter of Vanes 0.95 m. Height of Cairn 1.325 m.

Original Beacon has/~~has not~~ been destroyed by me.

Date	Record of Station

CENTRAL MAPPING AUTHORITY

GEODETIC SURVEY OF M.S.F.

GEODETIC STATION RECONNAISSANCE and MAINTENANCE REPORT

Description:

1. Cleared by lanes bearing. $275^{\circ} 6.6'$ $127^{\circ} 14.0'$ - $135^{\circ} 14.0'$ - 195° from Trig. Mast
 Note: Cross out word or words which do not apply

2. Mast & Vanes have been painted white & black respectively. ✓

3. The station/pillar was unpiled/not unpiled/constructed on..... 19....., dimensions now being:

Description of mark..... should be explicit, e.g. S/Steel Pillar Plate, Steel plug, Brass plug, Bolt, G.I. Pipe

Height of mark..... m. ^{above} rock/concrete; Mark is..... m. ^{above} G.L.

Height of Top Vanes to Top Mark/Pillar plate..... m. Diameter of Vanes (vertical)..... m.

Height of Cairn..... m. Diameter of Cairn..... m. Name Plate found/~~not found~~/placed.

Length of Mast..... m. (approximate if not unpiled)

4. A..... ~~COPPER~~ ~~NAH~~..... set in conc/rock has been placed/found, bearing..... °M from Mast/Plug/Pillar

5. A..... ~~BRASS~~ ~~TRIG~~ ~~PLATE~~..... set in conc/rock has been placed/found, bearing..... °M from Mast/Plug/Pillar

6. A..... set in conc/rock has been placed/found, bearing..... °M from Mast/Plug/Pillar

7. A..... set in conc/rock has been placed/found, bearing..... °M from Mast/Plug/Pillar

8. Action required: ~~S.M. TRIG. PLATE~~ ~~CONC. ROCK~~ ~~TO BE SET IN ROCK~~.....

STANDPOINT:

STANDPOINT:

Mark	Direction	Horiz. Distance	Height Difference	Mark	Direction	Horiz. Distance	Height Difference
			above standpt.				above standpt.
			below				below
			above standpt.				above standpt.
			below				below
Prepared by: *[Signature]* 19/05/2022

Checked: *[Signature]*

Checked

Noted on U.T.M. Card

St 2733-1

STATION: *BOGAN GS.* No.: *6644*

MAP SHEET SCALE 1:250 000

INSPECTED BY: *G.L. FORD* DATE: *4/9/89*

AUTHORITY: *A.I.C.* FIELD BOOK: *---*

Station Diagram

GS 24

STATION BOGAN GS (P) 6644	<p>Owner's Name: J R Address: REMYN CHURCH L.B.D. Phone:</p> <p>Current Occupant: PERMISSIVE OCCUPANCY Address: MR. ERWIN THIEL Phone: "THE GLEN" BOGAN GATE</p> <p style="text-align: center;"><u>ACCESS</u></p> <p>Access Report of...../1980⁸⁰ was found suitable/unsuitable.</p> <p style="text-align: center;">MR. THIEL LIVES IN BOGAN GATE IN LAKELAN ST NEXT TO THE UNITED CHURCH [POLLUTION OVER ROAD FROM CHURCH] MRS. THIEL SOME TIMES WORKS AT LOCAL STORE</p>
Beacon Diagram Net to Scale	
This section to be completed by officer constructing pillar. Original station mark found/not found. Description of mark: Original beacon found/not found. Description of beacon: Height Top of Vanes to Top Mark.....m. Height of mark.....m. above rock/conc.....m. below G.L. Diameter of Vanes.....m. Height of Cairn.....m. Original Beacon has/not been destroyed by me.	
Date	Record of Station

BOA - 6644

GEODETTIC SURVEY OF A.S.M.

LAND INFORMATION CENTRE

GEODETTIC STATION: RECONNAISSANCE and MAINTENANCE REPORT

STATION: BOGAN No.: 6644

MAP SHEET SCALE 1:250 000 FORBES

INSPECTED BY: A. Sivertsen DATE: 18.7.94

AUTHORITY: LIC FIELD BOOK: -

Description: *Note: Cross out word or words which do not apply*

1. Cleared by lanes bearing **Ok for GPS** (In future **substituting will be required**) from Trig. Mast

2. Mast & Vanes have been painted white & black respectively.

3. The station/pillar was unpiled/not unpiled/constructed on.....19....., dimensions now being:

Description of mark..... should be explicit, e.g., S/Steel Pillar Plate, Steel plug, Brass plug, Bolt, G.I. Pipe

Height of mark.....m. above rock/concrete; Mark is.....m. above G.L. below

Height of Top Vanes to Top Mark/Pillar plate.....m. Diameter of Vanes (vertical).....m.

Height of Cairn.....m. Diameter of Cairn.....m. Name Plate found/not found/placed.

Length of Mast.....m. (approximate if not unpiled)

4. A.....set in conc/rock has been placed/found, bearing.....°M from Mast/Plug/Pillar

5. A.....set in conc/rock has been placed/found, bearing.....°M from Mast/Plug/Pillar

6. A.....set in conc/rock has been placed/found, bearing.....°M from Mast/Plug/Pillar

7. A.....set in conc/rock has been placed/found, bearing.....°M from Mast/Plug/Pillar

8. Action required:.....

STANDPOINT:

STANDPOINT:

Mark	Direction	Horiz. Distance	Height Difference	Mark	Direction	Horiz. Distance	Height Difference
			above standpt.				above standpt.
			below				below
			above standpt.				above standpt.
			below				below
Prepared by: *A. Sivertsen*

Checked: *A. Sivertsen*

Noted on U.T.M. Card

Checked

