


STATION AFTERLEE T.S. 6655

Owners Name MR. JOHN MILLEN

Current Occupant GRANIER

Address See Address Report

Station Diagram Not to Scale

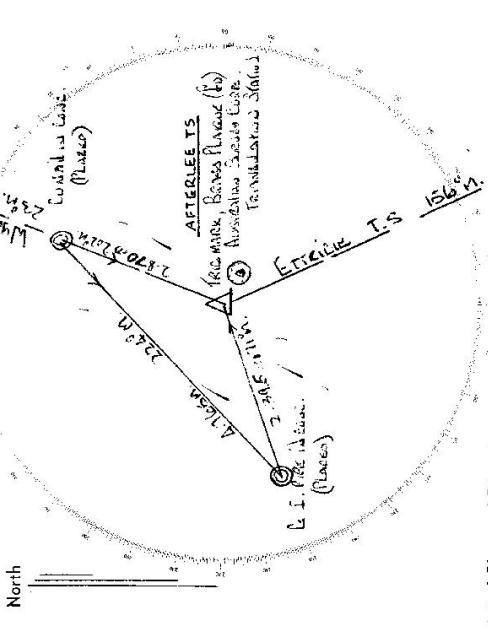

List of Observed Directions:-

Station	Direction	Station	Direction
BEERICK T.S.	237 53 60	WATER TOWER	237 53 60
WATER TOWER	227 40 45	WATER TOWER	227 40 45
CO MAIL	224 45	WATER TOWER	224 45
SILVER	21 11	BEERICK T.S.	21 11
SIP IN CASE			
WATER TOWER	237 53 60	WATER TOWER	237 53 60
COPPER MAIL	21 48	WATER TOWER	21 48
WATER TOWER	237 53 60	WATER TOWER	237 53 60
ELECTRIC T.S.	156 17 58	WATER TOWER	156 17 58

Access 31-5-75 Access to Afterlee T.S.
 At Afterlee Public School c. 0.5 miles, travel toward Kneale along gravel road
 1.00 MILEAGE
 * T Junction, take gravel road to your left.
 Widen road map of the area on your right.
 1.50 Pass house of owner of land on which T.S. is situated Mr John Miller.
 (Pink house on right)
 3.00 Take gravel road to your right, sign, 'Wolcott Road', follow main gravel road.
 4.25 At cream box, take right fork through iron gate.
 4.40 Through iron gate, round of old house on your left, bend right along fence along southern edge of hill.
 4.80 Pass through old gate opening in fence, follow fence through Lantana bushes.
 5.00 Through barbed wire gate. Can walk to take area here, 10 minutes steep.
 5.05 At western end of hill leave vehicle walk in a northerly direction up stone and along ridge to T.S.
 Walking time from this point about 15 minutes with light load.

68

CENTRAL MAPPING AUTHORITY

GEODETIC SURVEY OF N.S.W.

GEODETIC STATION RECONNAISSANCE and MAINTENANCE REPORT

Description:

- Cleared by lanes bearing **Trigs along ridge 60-89° G.I.D.** *Note: Cross out word or words which do not apply*
- Mast & Vanes have been painted white & black respectively.** *rest is suckers set 1/2 day clearing*
- The station **pillar was unpiled/constructed on** **19** dimensions now being:

Description of mark: **above** rock/concrete; **below** G.L.

Height of mark: **above** rock/concrete; **below** G.L.

Height of Top Vanes to Top Mark/Pillar plate: **1.01** m. Diameter of Vanes (vertical): **1.01** m.

Height of Cairn: **3** m. Diameter of Cairn: **3** m. Name Plate found/not found/placed.

Length of Mast: **3** m. (approximate if not unpiled) **Mast secured by guy wires**

4. **A. Cu. Nail** set in conc/rock has been placed/found, bearing **22**°, **2.8** m from Mast/Plug/Pillar at **2.8** m

5. **A. G.I. Pipe** set in conc/rock has been placed/found, bearing **251**°, **2.4** m from Mast/Plug/Pillar at **2.4** m

6. **A.** set in conc/rock has been placed/found, bearing: ° M from Mast/Plug/Pillar

7. **A.** set in conc/rock has been placed/found, bearing: ° M from Mast/Plug/Pillar

8. Action required: **Place rooftop pillar if possible 1/2 day clearing suckers & 1/2 day clear cleaning fallen timber so that horse riders & cattle have access to hill top**


STANDPOINT:

Mark	Direction	Horiz. Distance	Height Difference	Mark	Direction	Horiz. Distance	Height Difference
WYNEDEN EDM 34 07	GRP	M & V	above standpt.	HELMET	57 35	M & V	above standpt.
SWAMP CK EDM 101 15	M & V	M & V	above standpt.	FAIRMOUNT	97 42	M & V	above standpt.
ETTRICK EDM 166 26	M & V	M & V	above standpt.	BENTLEY	121 09	M & V	above standpt.
TOONUMBAR EDM 274 49	Profile OK	Profile OK	above standpt.	NAMODNA	144 10	Pillar	above standpt.
OTHERS				THERESA	189 45	M & V	above standpt.
LION	38 25	Hill	above standpt.	DYRABABA	207 21	Pillar	above standpt.
BOORABEE	98 20	M & V	above standpt.	EDEN	127 13	M & V	above standpt.

Prepared by: **A. Swanton** 24-6-80 Checked: **Edwards** Noted on U.T.M. Card

SI 2733-1

STATION: **AFTERLEE** No: **6655**
 MAP SHEET SCALE 1:250 000 **WARWICK** (Afterlee 1:25,000)
 INSPECTED BY: **A. Sivertsen** DATE: **17-6-80**
 AUTHORITY: **C M A** FIELD BOOK: **1848**

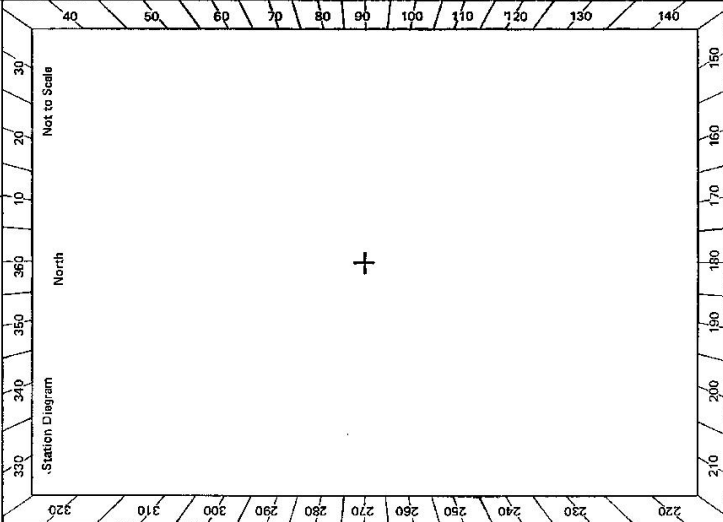

Checked

Edwards 13/1/80

STATION **AFTERLEE MOUNT 6655**


Owner's Name: **Mr. Frank Millar**
 Address: **Garrahan Road**
 Phone: **333-1AA**
 Current Occupant: **OWNER**
 Address: **OWNER**
 Phone: **OWNER**

ACCESS

Access Report of 17/1/1988 was found suitable/unavailable.

FEATURES
 10.00 ROAD TO TRAVEL TOWARDS WOODS BANK.
 0.50 TURN LEFT AT SALEWAYS SIGN AFTERLEE, TOWARDS DAM.
 3.50 TAKE RIGHT FORK TOWARDS TOWNHALL DAM.
 4.00 PASS SIGN ON LEFT
 15.50 EDEN CREEK BRIDGE
 17.00 SWAIN'S CREEK BRIDGE
 19.70 GOLF-COURSE DRIVE
 20.70 TAKE RIGHT ON LEFT - OWNER MR MILLAR TURNED ON
 21.60 PASS ON LEFT
 22.00 TURN LEFT THROUGH IRON GATE
 22.72 TURN LEFT SENSITIVE AROUND BOUNDARY
 23.40 LOCKED WHITE GATE OPEN OPPOSITE END
 23.75 LET DOWN FENCE
 24.00 GEODESIC STATION

NOTE FROM 23.55 VERN STREET DEVIABLE IS DOWN BOUNDARY ONLY

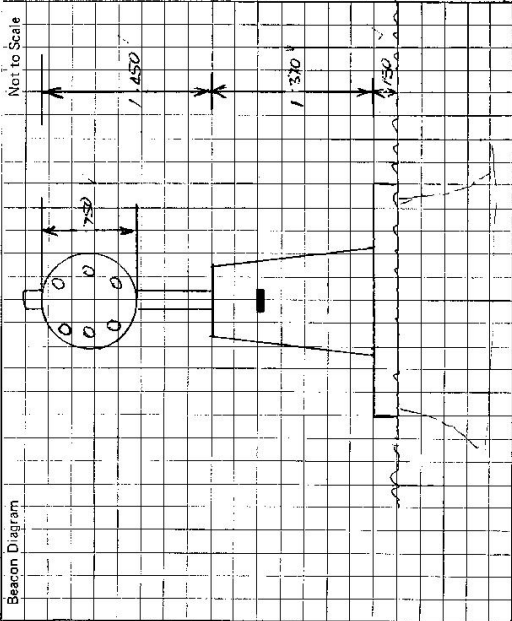

This section to be completed by officer constructing pillar.

Original station mark found/~~not found~~.

Description of mark: **Iron Gate**

Original beacon found/~~not found~~.

Description of beacon: **Iron Gate**

Height Top of Vanes to Top Mark: **1.370** m.

Height of mark: **1.450** m. above G.L. / **0.080** m. below

Diameter of Vanes: **1.450** m. Height of Cairn: **0.080** m.

Original Beacon has ~~been~~ been destroyed by me.

Date

Record of Station