

7-6-03

Department of Lands

Integrative Survey of N.S.W.

RECONNAISSANCE and MAINTENANCE REPORT

STATION **AWABA**

This Trig. Station has been:-

Note: Cross out word or words which do not apply

1. ~~Completely cleared to permit 360° vision to surrounding Trigs.~~
2. Cleared by lanes bearing 225° & 40° M. from Trig. Mast
3. Trig. Mast & Vanes have been painted white & black respectively.
4. The Trig. was unpiled/~~not completely~~ dimensions now being:

Description of mark: Concrete pillar should be explicit, e.g. Steel plug, Brass plug, Bolt, Concrete Pillar

Height of mark: 1.27 m above rock/concrete 1.27 m above G.L.

Height of Top Vanes to ~~Top Mast~~ Top pillar plate: 1.46 m Diameter of Vanes (vertical): 0.155 m.

Height of Cairn: m. Diameter of Cairn: m.

Length of Mast: m. (approximate if not unpiled)

5. A Old trig plug set in conc/~~rock~~ has been placed/fd S:205 m. bearing 246°M from Trig. ~~Mast~~/pillar
6. A SSM set in conc/~~soil~~ has been placed/fd S:245 m. bearing 218°M from Trig. ~~Mast~~/pillar
7. A set in conc/~~soil~~ has been placed/fd m. bearing°M from Trig. ~~Mast~~/pillar
8. A set in conc/~~rock~~ has been placed/fd m. bearing°M from Trig. ~~Mast~~/pillar

9. Connection Trig. plug to SSM : 2.540 m. bearing 146°M

10. Connection to m. bearing°M

11. Connection to m. bearing°M

12. Connection to m. bearing°M

13. Diff. Ht. Trig. plug is 1.335 m. above Pillar plate

14. Diff. Ht. SSM is 1.215 m. above Pillar plate

15. Diff. Ht. S is m. above

16. Diff. Ht. S is m. below

Prepared by: MS

Checked: MS 7/17


Co: **NORTHUMBERLAND** Ph: **AWABA**

Map Sheet: **LAVE MCQUARIE** No: **404**

Inspected by: **K. WOODHEAD, J. MOORE** Date: **15/1/14**

Authority: **CMA** Field Book: **AS-1350**

Beacon Diagram Not to Scale

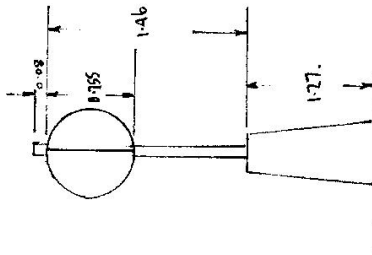

Date	Record of Station
7/2/15	New mast by H. Border, dimensions as above.


STATION | **AWABA 666**

Owners Name..... Current Occupant.....

Address..... Address.....

Access 2ND in day AND in wet. 1-12-76
 AT Awaba Railway station, towards State Mine.
 kms 00 Bridge (near station)
 0-8 State mine on right.
 1-2 Take track on left just before cutting
 Follow this track along ridge to TS at 2.4kms.
 (1967 access still applicable now).

Station Diagram Not to Scale

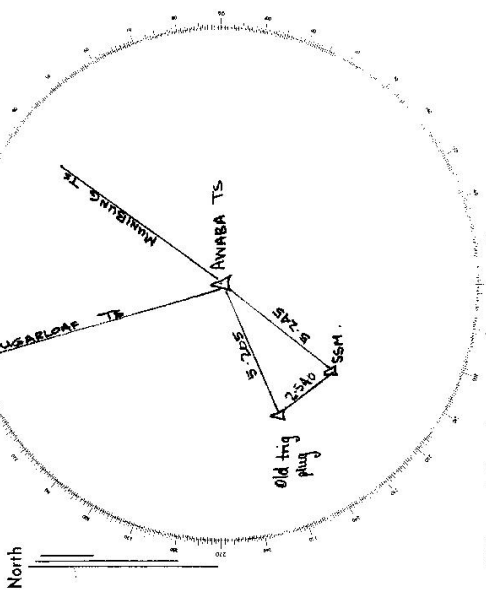

List of Observed Directions:-

Standpoint: R1147		Standpoint: TR66 PLUS6.	
Station	Direction	Station	Direction
Sugarloaf (P) TS	0° 00' 00"	SUGARLOAF (P) TS	0° 00' 00"
Mumbung TS	54° 23' 45"	Mumbung TS	54° 23' 20"
SSM in cent.	235° 30' 30"	Pillar	83° 38' 30"
TR66 Plus6.	263° 40' 30"	SSM	160° 26"
Station	Direction	Station	Direction

STATION ANVA PILLAR TS 666

Owners Name: Current Occupant:


Address: Address:

Access

Vehicle

0-0. Toronto Travel south along Toronto - Highway Rd.
 4-0. Turn Right - sign "Carnock"
 6-1. Turn Right onto gravel track and follow to Trig
 7-3. TRIG.

Actual drive vehicle recommended.

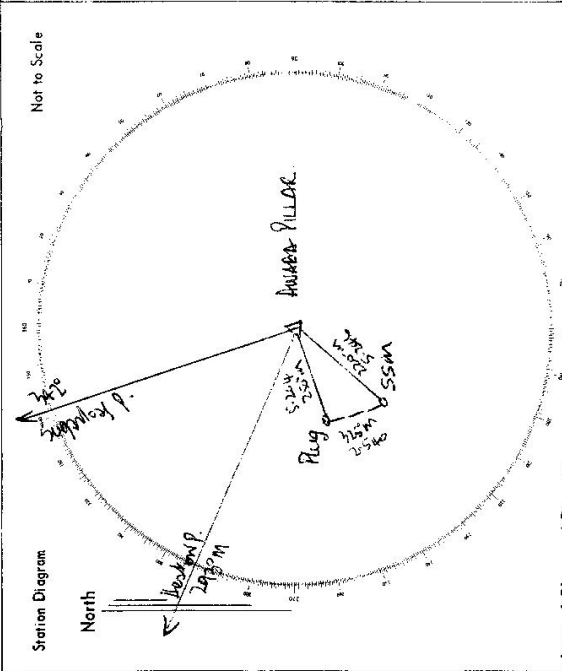


List of Observed Directions: -

Standpoint: <u>ANVLA PILLAR</u>		Standpoint: <u>Plug</u>	
Station	Direction	Station	Direction
Heathrow Pillar	0° 00' 00"	Heathrow Pillar	6° 08' 08"
Sussex Pillar	50° 37' 31"	Sussex Pillar	50° 37' 25"
SSM	286° 08' 01"	ANVLA PILLAR	134° 15' 54"
Plug	318° 10' 22"	SSM	211° 15' 26"
Station	Direction	Station	Direction


STATION T.S. 666 AWABA (P)

Owners Name.....
 Address.....
 Current Occupant.....
 Address.....

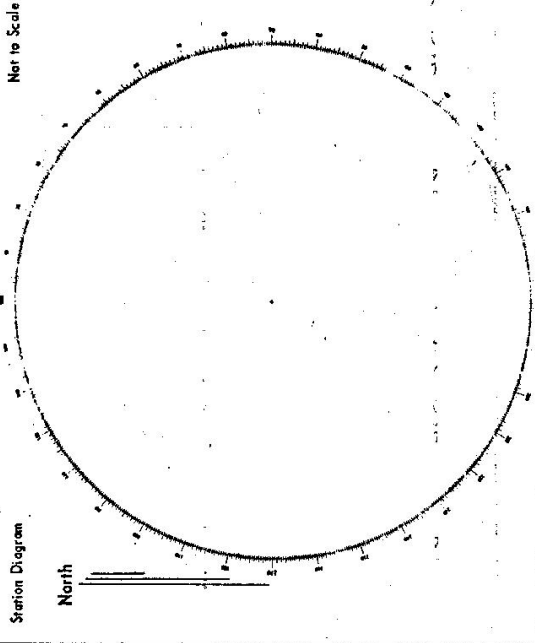


List of Observed Directions:-

Standpoint:		Station:	
Station	Direction	Station	Direction
Standpoint:		Station:	
Station	Direction	Station	Direction

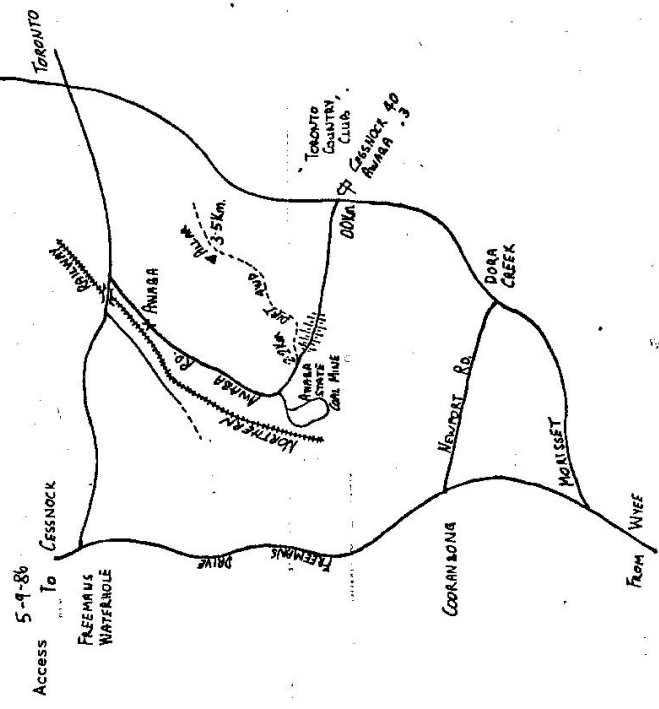

D. West, Government Printer, New South Wales - 1976

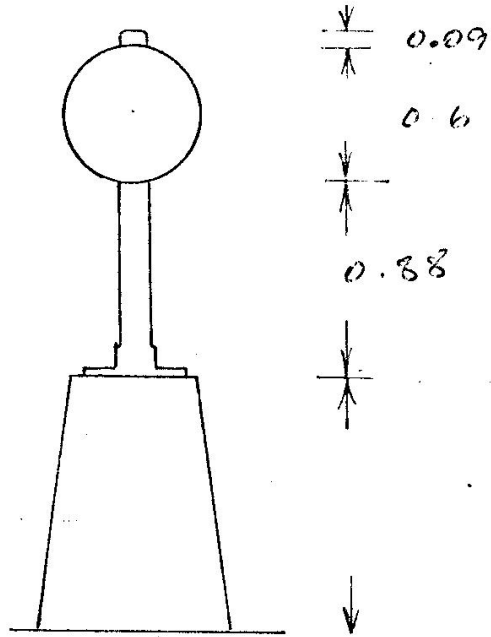


TS AWABA (P)

MAST & VANES REPLACED 19/8/88

Department of Lands
 Integral Survey of N.S.W.
RECONNAISSANCE and MAINTENANCE REPORT

STATION INWARBA PILLAR, T.S 666
 Co: NorKumber/sno Ph: Anwaba
 Map Sheet: Lake Macquarie No: 4547
 Inspected by: T. Bluffey Date: 9/19/86
 Authority: IS.D NCL Field Book: MP805

Beacon Diagram
 Not to Scale

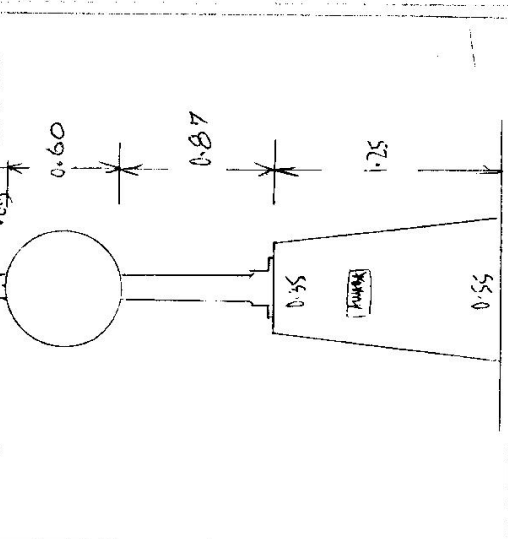

Date	Record of Station

This Trig. Station has been:-
 Note: Cross out word or words which do not apply

- Completely cleared to permit 360° vision to surrounding Trigs. ✓
- Cleared by lines bearing ✓ from Trig: Mast
- Trig. Mast & Vanes have been painted white & black respectively. ✓
- The Trig. was unpiled/not supplied, dimensions now being: 1.25 m above G.L.

Description of mark: rock-concrete should be explicit, e.g. Steel plug, Brass plug, Bolt, Concrete Pillar
 Height of mark: 1.25 m above G.L.
 Height of Top Vanes to Top Mast Top pillar plate: 1.47 m Diameter of Vanes (vertical): 0.60 m.
 Height of Cairn: 0.35 m. Diameter of Cairn: 0.55 m.
 Length of Mast: 1.50 m. (approximate if not supplied)

- A. SSM set in conc/rock has been placed/d. 5.24 m bearing 220° M from Trig. Mast/pillar
- A. SSM set in conc/soil has been placed/d. 5.204 m bearing 250° M from Trig. Mast/pillar
- A. set in conc/soil has been placed/d. m. bearing m. bearing m. bearing
- A. set in conc/rock has been placed/d. m. bearing m. bearing m. bearing

- Connection: Plug to SSM : 2.540 m. bearing 325° SM
- Connection: to : m. bearing m. bearing m. bearing
- Connection: to : m. bearing m. bearing m. bearing
- Diff. Ht. Pills. Plate is 1.278 m. above SSM
- Diff. Ht. Pills. Plate is 1.336 m. above Plug
- Diff. Ht. Plug is 0.064 m. below SSM
- Diff. Ht. is m. above m. below

Prepared by: [Signature] Checked: [Signature]

CENTRAL MAPPING AUTHORITY

GEODETTIC STATION RECONNAISSANCE and MAINTENANCE REPORT


GEODETTIC SURVEY OF N.S.W.

STATION: *ANABA (P)* No.: *666*

MAP SHEET
SCALE 1:250 000 SYDNEY *1:80,000 LNE MAGSQUARIE*

INSPECTED BY: *P.BITS* DATE: *29/1/90*

AUTHORITY: *LAND INFORMATION CENTRE* FIELD BOOK: *2102*

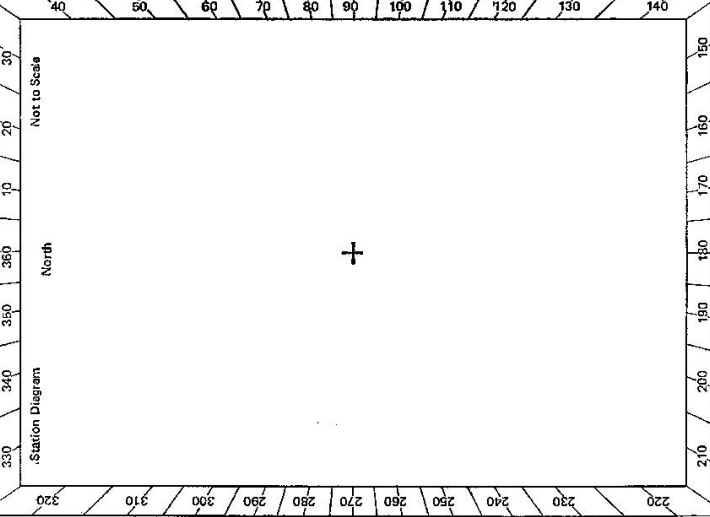

Description:

1. Cleared by lanes bearing..... *CLEARED TO 15° BEARING FOR S.P.S SURVEY* from Trig. Mast
2. Mast & Vanes have been painted white & black respectively.
3. The station/pillar was unpiled/not unpiled/constructed on.....*19*....., dimensions now being:

Description of mark.....should be explicit, e.g., S/Steel Pillar Plate, Steel plug, Brass plug, Bolt, G.I. Pipe

Height of mark.....m.....^{above}/_{below} rock/concrete; Mark is.....m.....^{above}/_{below} G.L.

Height of Top Vanes to Top Mark/Pillar plate.....m. Diameter of Vanes (vertical).....m.

Height of Cairn.....m. Diameter of Cairn.....m. Name Plate found/not found/placed.

Length of Mast.....m. (approximate if not unpiled)

4. A.....set in conc/rock has been placed/found, bearing.....°M from Mast/Plug/Pillar

5. A.....set in conc/rock has been placed/found, bearing.....°M from Mast/Plug/Pillar

6. A.....set in conc/rock has been placed/found, bearing.....°M from Mast/Plug/Pillar

7. A.....set in conc/rock has been placed/found, bearing.....°M from Mast/Plug/Pillar

8. Action required:.....

STANDPOINT:

STANDPOINT:

Mark	Direction	Horiz. Distance	Height Difference	Mark	Direction	Horiz. Distance	Height Difference
			above standpt.				above standpt.
			below				below
			above standpt.				above standpt.
			below				below
Prepared by: *P.BITS 6/12/90* Checked: *[Signature]* Noted on U.T.M. Card

Checked

GS 24

et. 2733-2 D. West. Government Printer Beacon Diagram Not to Scale	STATION ANABA (P) 666	Owner's Name: TRIC RESERVE 19153 Address: CORRYT A6 TRICURE 16700 CHECKED WITH MATTHEW LAND BOARD Phone: Current Occupant: Address: Phone: <p style="text-align: center;"><u>ACCESS</u></p> Access Report of 21.1.19 was found suitable/unsuitable. <p>4WD ACCESS</p> At RAIL LINE CROSSING TORONTO, HEAD TOWARDS TORONTO TRAFFIC LIGHTS, CONTINUE STRAIGHT AHEAD. TORONTO COUNTRY CLUB ON LEFT TURN RIGHT SIGN WILTON ROAD, GARBAGE TIP, ANABA. TORONTO RIGHT ON RIGHT GARBAGE TIP ON TRACK, JUST AFTER CUTTING TAKE LEFT FORK. ANABA (P) ✓
		Date Record of Station
This section to be completed by officer constructing pillar.		
Original station mark found/not found.		
Description of mark:		
Original beacon found/not found.		
Description of beacon:		
Height Top of Vanes to Top Markm.		
Height of markm. above below G.L.		
Diameter of Vanesm. Height of Cairnm.		
Original Beacon has/has not been destroyed by me.		