





GEODETIC SURVEY OF N.S.W.

CENTRAL MAPPING AUTHORITY


GEODETIC STATION RECONNAISSANCE and MAINTENANCE REPORT

STATION: STONEY GAULTE (1) No: 6665

MAPSHEET SCALE 1:250 000 TUBED HEADS

INSPECTED BY: C. PAKES DATE: 27/2/81

AUTHORITY: C.M.A. FIELD BOOK: 1809

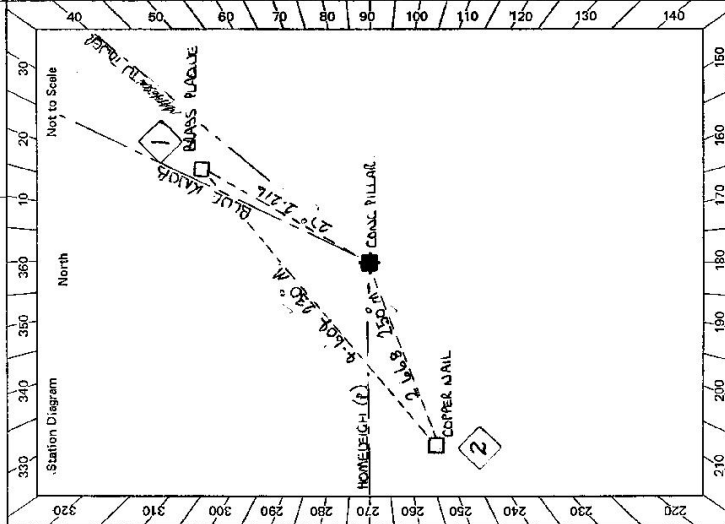

- Description: 4.45° to 1.99° Note: Cross out word or words which do not apply
- Cleared by lanes bearing..... from Trig. Mast
  - Mast & Vanes have been painted white & black respectively. ✓
  - The station/pillar was ~~erected~~ ~~not erected~~ /constructed on ~~1.1th~~ ~~FEARNSLEY~~ 19.81... dimensions now being: ~~S/STEEL~~ ~~PLATE~~ should be explicit, e.g. S/Steel Pillar Plate, Steel plug, Brass plug, Bolt, G.I. Pipe
  - Height of mark: 1.20 m. <sup>above</sup> ~~below~~ rock/concrete; Mark is 1.54 m. <sup>above</sup> ~~below~~ G.L.
  - Height of Top Vanes to Top Mark/Pillar plate .....m. Diameter of Vanes (vertical): 1.50 m.
  - Height of Cairn .....m. Diameter of Cairn .....m. Name Plate ~~found~~ ~~not found~~ placed.
  - Length of Mast .....m. (approximate if not implied)
  - A. COPPER NAIL set in conc/rock has been placed/~~found~~, bearing 156° M from Mast/Plug/Pillar
  - A. BRASS PLAQUE set in conc/rock has been placed/~~found~~, bearing 27° M from Mast/Plug/Pillar
  - A. .... set in conc/rock has been placed/~~found~~, bearing ..... M from Mast/Plug/Pillar
  - A. .... set in conc/rock has been placed/~~found~~, bearing ..... M from Mast/Plug/Pillar
  - Action required: .....

| STANDPOINT: PILLAR |           | STANDPOINT: BRASS PLAQUE |                   |                   |           |                 |                   |
|--------------------|-----------|--------------------------|-------------------|-------------------|-----------|-----------------|-------------------|
| Mark               | Direction | Horiz. Distance          | Height Difference | Mark              | Direction | Horiz. Distance | Height Difference |
| HOMELEIGH (P)      | 0 00 00   |                          | above standpt.    | HOMELEIGH (P)     | 0 00 00   |                 | above standpt.    |
| BRASS PLAQUE       | 119 26 95 | 2.214                    | below standpt.    | MILDENHURST TOWER | 130 31 10 |                 | below standpt.    |
| MILDENHURST TOWER  | 130 29 55 |                          | above standpt.    | PILLAR SPICOT     | 299 28 35 | 2.217           | below standpt.    |
| COPPER NAIL        | 338 99 15 | 4.668                    | below standpt.    | COPPER NAIL       | 321 03 05 | 4.604           | above standpt.    |
|                    |           |                          | above standpt.    |                   |           |                 | below standpt.    |
|                    |           |                          | below standpt.    |                   |           |                 | above standpt.    |
|                    |           |                          | above standpt.    |                   |           |                 | below standpt.    |
|                    |           |                          | below standpt.    |                   |           |                 | above standpt.    |

Prepared by: C. PAKES

Checked:

Noted on U.T.M. Card

Checked

|                                                                                                                                                                                                                                                                                                                                                                                                                                                                                                                                                                                                                                                                                                                                                                                                                                                                                                                                                                                                                                                                                        |                                                                                                                                                                                                                                                                                                                                                                                                                                                                                                                                                                                                                                                                                |
|----------------------------------------------------------------------------------------------------------------------------------------------------------------------------------------------------------------------------------------------------------------------------------------------------------------------------------------------------------------------------------------------------------------------------------------------------------------------------------------------------------------------------------------------------------------------------------------------------------------------------------------------------------------------------------------------------------------------------------------------------------------------------------------------------------------------------------------------------------------------------------------------------------------------------------------------------------------------------------------------------------------------------------------------------------------------------------------|--------------------------------------------------------------------------------------------------------------------------------------------------------------------------------------------------------------------------------------------------------------------------------------------------------------------------------------------------------------------------------------------------------------------------------------------------------------------------------------------------------------------------------------------------------------------------------------------------------------------------------------------------------------------------------|
| <p>STATION <b>STONE-7 SHUTE (P) TS 6665</b></p> <p>Owner's Name: <b>BANKY T.S.D.V.</b><br/>                 Address: <b>RODRIK, CAERK.</b><br/>                 Phone: <b>LISMORE</b></p> <p>Current Occupant: .....<br/>                 Address: .....<br/>                 Phone: .....</p> <p style="text-align: center;"><b>ACCESS</b></p> <p>Access Report of 14/10/19: Was found suitable/unsuitable.<br/>                 DIRECTION<br/>                 ON KYDOLLE NUMBANG RD SIGNS POST KYDOLLE 29, NUMBANG 4, LISMORE 31, HEAD SOUTH<br/>                 TOWARDS GEORGICA II ALONG MOUNTAIN TOP ROAD.<br/>                 3.93 PASS LODGE ROAD ON L.H.S.<br/>                 4.24 TURN RIGHT OFF MAIN RD AT SHARP L.H. BEND &amp; OVER GRAD.<br/>                 4.36 PASS HOUSE ON L.H.S. (TENANTS)<br/>                 4.40 THROUGH TWO WIRE GATES ON RIGHT OF OLD COW SALES. FOLLOW TRACK.<br/>                 5.24 TURN LEFT OFF TRACK. DOWN HILL ACROSS HEAD OF DULLY AND ON INTO TIMBER<br/>                 5.74 BELOW TRIG. ABOUT 5 MINUTES WALK TO TRIG.</p> | <p>Beacon Diagram</p> <p style="text-align: right;">Not to Scale</p> <p>This section to be completed by officer constructing pillar.</p> <p>Original station mark found/ <del>not found</del>.</p> <p>Description of mark: <b>BANKY T.S.D.V.</b></p> <p>Original beacon found/ <del>not found</del>.</p> <p>Description of beacon: <b>CAIMU MAIST &amp; VANES</b></p> <p>Height Top of Vanes to Top Mark: <b>3.935</b> m.</p> <p>Height of mark, <del>above</del> <b>below</b> G.L. <b>2.30</b> m. <del>above</del> <b>below</b></p> <p>Diameter of Vanes <b>1.150</b> m. Height of Cairn <b>0.000</b> m.</p> <p>Original Beacon has/ <del>not been</del> destroyed by ma.</p> |
| <p>Date</p> <p>Record of Station</p>                                                                                                                                                                                                                                                                                                                                                                                                                                                                                                                                                                                                                                                                                                                                                                                                                                                                                                                                                                                                                                                   |                                                                                                                                                                                                                                                                                                                                                                                                                                                                                                                                                                                                                                                                                |