

CENTRAL MAPPING AUTHORITY

GEODETIC SURVEY OF N.S.W.

GEODETIC STATION RECONNAISSANCE and MAINTENANCE REPORT

Description:

1. Cleared by lanes bearing.....
Note: Cross out word or words which do not apply
2. Mast & Vanes have been painted white & black respectively. in Cairn of rocks has been sighted from Trig. Mast from South West
3. The station/pillar was unplied/not unplied/constructed on.....19....., dimensions now being:
Description of mark.....should be explicit, e.g., S/Steel Pillar Plate, Steel plug, Brass plug, Bolt, G.I. Pipe
- Height of mark.....m. ^{above} rock/concrete; Mark is.....m. ^{above} G.L.
- Height of Top Vanes to Top Mark/Pillar platem. Diameter of Vanes (vertical).....m.
- Height of Cairn.....m. Diameter of Cairn.....m. Name Plate found/not found/placed.
- Length of Mast.....m. (approximate if not unplied)
4. A.....set in conc/rock has been placed/found, bearing.....°M from Mast/Plug/Pillar
5. A.....set in conc/rock has been placed/found, bearing.....°M from Mast/Plug/Pillar
6. A.....set in conc/rock has been placed/found, bearing.....°M from Mast/Plug/Pillar
7. A.....set in conc/rock has been placed/found, bearing.....°M from Mast/Plug/Pillar
8. Action required:.....

STANDPOINT:

Mark	Direction	Horiz. Distance	Height Difference	Mark	Direction	Horiz. Distance	Height Difference
			above standpt.				above standpt.
			below				below
			above standpt.				above standpt.
			below				below
Prepared by: R.K. Barwick 9/12/19 Checked: Noted on U.T.M. Card

SI 2733-1

STATION: *BINNIE* No.: *6671*
 MAP SHEET SCALE 1:250 000 *TAMMUBERTH*
 INSPECTED BY: *R.K. BARWICK* DATE: *28/3/19*
 AUTHORITY: *CMA* FIELD BOOK:

Station Diagram
 North
 Not to Scale

GS 24

<p>St. 2733-2 D. West, Government Printer</p> <p>Beacon Diagram</p> <div style="border: 1px solid black; width: 100%; height: 150px; position: relative;"> <div style="position: absolute; top: 0; right: 0; font-size: 8px;">Not to Scale</div> </div>	<table border="1" style="width: 100%; border-collapse: collapse;"> <tr> <td style="width: 50%; padding: 5px;"> <p>Owner's Name:</p> <p>Address:</p> <p>Phone:</p> <p>Access Report of <u>28/3/1979</u> was found suitable/unsuitable.</p> </td> <td style="width: 50%; padding: 5px;"> <p>STATION B/N/N/E 6671*</p> <p>Current Occupant:</p> <p>Address:</p> <p>Phone:</p> <p style="text-align: center;">ACCESS</p> </td> </tr> </table>	<p>Owner's Name:</p> <p>Address:</p> <p>Phone:</p> <p>Access Report of <u>28/3/1979</u> was found suitable/unsuitable.</p>	<p>STATION B/N/N/E 6671*</p> <p>Current Occupant:</p> <p>Address:</p> <p>Phone:</p> <p style="text-align: center;">ACCESS</p>
<p>Owner's Name:</p> <p>Address:</p> <p>Phone:</p> <p>Access Report of <u>28/3/1979</u> was found suitable/unsuitable.</p>	<p>STATION B/N/N/E 6671*</p> <p>Current Occupant:</p> <p>Address:</p> <p>Phone:</p> <p style="text-align: center;">ACCESS</p>		
<p>This section to be completed by officer constructing pillar.</p>			
<p>Original station mark found/not found.</p>			
<p>Description of mark:</p>			
<p>Original beacon found/not found.</p>			
<p>Description of beacon:</p>			
<p>Height Top of Vanes to Top Mark.....m.</p>			
<p>Height of mark.....m. above rock/conc.....m. below G.L.</p>			
<p>Diameter of Vanes.....m. Height of Cairn.....m.</p>			
<p>Original Beacon has/has not been destroyed by me.</p>			
<p>Date</p>	<p>Record of Station</p>		

GS 24

STATION **BINNIE (P) 6671**

Owner's Name: **R (BOB) RANKIN**
 Address: **GLEN LOGAN**
 Phone: **QUIR INDI**
SPRING RISE 1CU

Current Occupant:
 Address:
 Phone:


ACCESS

Access Report of 11/1/19¹⁹ was found suitable/unavailable.

- 0.0 AT SPRING RIDGE RD. HEADING EAST TOWARDS CAROONA
 - A-A TURN RIGHT TOWARDS "TRIBELLA" AND CROSS RAILWAY LINE
 - 7.1 GRID, PAST TRACK ON RIGHT
 - 8.3 GRID 9.9 GRID "TRIBELLA" 11.34 GRID 11.5 ACROSS GRID THAT LEADS TO HOUSE
 - 11.7 GRID 12.5 GRID 13.5 GRID
 - 14.1 RIGHT. A CROSS GRID AT ENTRANCE TO GLEN LOGAN HOMESTEAD
 - 14.2 TURN RIGHT AT BACK OF OWNERS HOUSE
 - 14.3 GO THROUGH DOUBLE IRON GATE, TURN LEFT AND FOLLOW FENCE
 - 15.0 TURN RIGHT, FOLLOW WATER DRAIN > EDGE OF CULTIVATION TO S-W CORNER
 - 16.9 TURN RIGHT TOWARDS GATE IN S-W CORNER OF Paddock
 - 17.0 GO THROUGH GATE AND FOLLOW TRACK
 - 17.05 GO THROUGH GATE AND FOLLOW TRACK
 - 17.6 FENCE - TURN RIGHT FOLLOW FANT TRACK OF FENCE
 - 18.4 GO THROUGH GATE TURN LEFT FOLLOW FENCE LINE (BEND 100m)
 - 18.6 VEER RIGHT AT LIVE GUM MAKE WAY TO TOP OF RIDGE 19.1 BONNE GS.
- (SEE OWNER AS ACCESS MAY CHANGE WITH CROPS)

Not to Scale

Beacon Diagram

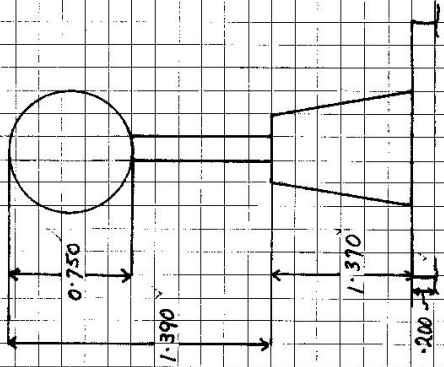

This section to be completed by officer constructing pillar.

Original station mark found/~~not found~~.

Description of mark: **BRASS TRIG PLUG**

Original beacon found/~~not found~~.

Description of beacon: **CAIRN MAST & VANES**

Height Top of Vanes to Top Mark: **3.640** m.

Height of mark: **0.90** m. ^{above} rock/~~base~~ ^{below} G.L.

Diameter of Vanes: **0.915** m. Height of Cairn: **3.100** m.

Original Beacon has/~~has not~~ been destroyed by me.

Date

Record of Station

CENTRAL MAPPING AUTHORITY


GEODETIC SURVEY OF N.S.W. GEODETIC STATION RECONNAISSANCE and MAINTENANCE REPORT

STATION: **BINNIE** No.: **6671**

MAP SHEET SCALE 1:250 000 **FRAMWORTH**

INSPECTED BY: **C. MOSS** DATE: **5/0/22**

AUTHORITY: **C.M.A** FIELD BOOK: **---**

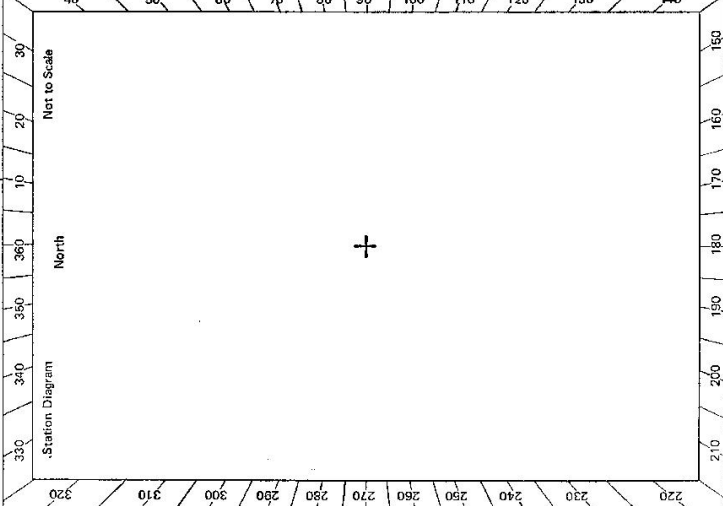

- Description:
 Note: Cross out word or words which do not apply
- Cleared by lances bearing..... from Trig. Mast
 - Mast & Vanes have been painted white & black respectively.
 - The station/pillar was unpiled/not unpiled/constructed on..... 19....., dimensions now being:
 Description of mark..... should be explicit; e.g., S/Steel Pillar Plate, Steel plug, Brass plug, Bolt, G.I. Pipe
 Height of mark.....m. ^{above} rock/concrete; Mark is.....m. ^{above} G.L.
 - Height of Top Vanes to Top Mark/Pillar plate.....m. Diameter of Vangs(vertical).....m.
 Height of Cairn.....m. Diameter of Cairn.....m. Name Plate found/not found/placed.
 Length of Mast.....m. (approximate if not unpiled)
 - A.....set in conc/rock has been placed/found, bearing.....° M from Mast/Plug/Pillar
 - A.....set in conc/rock has been placed/found, bearing.....° M from Mast/Plug/Pillar
 - A.....set in conc/rock has been placed/found, bearing.....° M from Mast/Plug/Pillar
 - A.....set in conc/rock has been placed/found, bearing.....° M from Mast/Plug/Pillar
 - Action required:.....

STANDPOINT:

Mark	Direction	Horiz. Distance	Height Difference	Mark	Direction	Horiz. Distance	Height Difference
			above standpt.				above standpt.
			below				below
			above standpt.				above standpt.
			below				below
Prepared by: **C. Moss** Checked: **AS** 31/5/22 Noted on U.T.M. Card

GS 24

84 2739-2 D. West, Government Printer

STATION **BINNIE** **6671***

<p>Beacon Diagram</p> <p style="text-align: right;">Not to Scale</p>	<p>Owner's Name: R. RANKIN</p> <p>Address: "GLEN LOGAN"</p> <p>Phone: DUNINDI</p> <p>Current Occupant: DWINERS</p> <p>Address:</p> <p>Phone:</p> <p>ACCESS 5'10"-82</p> <p>Access Report of 10/12/1981 was found unsuitable/unsuitable.</p> <p>AT SPRING RIDGE RD. HEADING EAST TOWARDS CRAIGON</p> <p>4.4 TURN RIGHT TOWARDS "TRABELLA" & CROSS RAILWAY</p> <p>7.1 GRID PAST TRACK ON RIGHT</p> <p>8.3 GRID 9.9 GRID "TRABELLA" 11.34 GRID 11.5 ACROSS GRID THAT LEADS TO HOUSE</p> <p>11.7, 12.5, 13.5, GRIDS</p> <p>14.1 RIGHT ACROSS GRID AT ENTRANCE TO GLEN LOGAN HOMESTEAD</p> <p>14.2 TURN RIGHT AT BACK OF DWINERS HOUSE</p> <p>14.3 THROUGH DOUBLE IRON GATE - TURN RIGHT - FOLLOW TRACK</p> <p>15.45 AT END OF BOWLEY FIELD TURN LEFT ALONG TOP OF BANK - FOLLOW TRACK</p> <p>16.73 THROUGH IRON GATE</p> <p>16.80 THROUGH IRON GATE - FOLLOW TRACK</p> <p>17.35 FOLLOW TRACK TO RIGHT ALONG FENCE</p> <p>18.11 THROUGH IRON GATE - TURN LEFT & FOLLOW FENCE</p> <p>18.3 VEER RIGHT AT LIVE GUM - MAKE WAY TO TOP OF RIDGE</p> <p>18.8 BINNIE GS</p>
<p>Date</p>	<p>Record of Station</p>
<p>This section to be completed by officer constructing pillar.</p> <p>Original station mark found/not found.</p> <p>Description of mark:</p> <p>Original beacon found/not found.</p> <p>Description of beacon:</p> <p>Height Top of Vanes to Top Mark.....m.</p> <p>Height of mark.....m. above rock/conc.....m. below G.L.</p> <p>Diameter of Vanes.....m. Height of Cairn.....m.</p> <p>Original Beacon has/has not been destroyed by me.</p>	