

STATION MURWILLUMBAH G.S. IS 6679	
Owner's Name: Address: Phone:	Current Occupant: Address: Phone:
Access Report of...../19..... was found suitable/unsuitable.	
ACCESS	
This section to be completed by officer constructing pillar. Original station mark found/not found. Description of mark: Original beacon found/not found. Description of beacon: Height Top of Vanes to Top Mark.....m. Height of mark.....m. above below G.L. Diameter of Vanes.....m. Height of Cairn.....m. Original Beacon has/not been destroyed by mc.	
Beacon Diagram	
Not To Scale	

GS 24

STATION MURWILLUMBAH TS 6679	
<p>Owner's Name: <u>Tweed River Shire Council</u></p> <p>Address: <u>Tumbulgum Road</u></p> <p>Phone: <u>73 2393</u></p>	<p>Current Occupant:</p> <p>Address:</p> <p>Phone:</p>
<p>ACCESS</p> <p>OLD Access Report of 28/3/1980 was found suitable/unsuitable.</p>	
<p>Feature</p> <p>0.0 MURWILLUMBAH P.O. travelling south along Brisbane Street.</p> <p>0.16 Turn RIGHT</p> <p>0.48 Turn LEFT sign Lismore 50, Kyogle 43.</p> <p>0.89 Turn RIGHT into Concoong Street</p> <p>0.97 Turn LEFT into narrow laneway</p> <p>1.45 Murwillumbah CS.</p>	<p>NOTE: Key to Water Reservoir obtained from Town planning Dept Tweed River Shire Council</p>
<p>Beacon Diagram</p> <p>Not to Scale</p>	
<p>This section to be completed by officer constructing pillar.</p> <p>Original station mark found/not found.</p> <p>Description of mark:</p> <p>Original beacon found/not found.</p> <p>Description of beacon:</p> <p>Height Top of Vanes to Top Markm.</p> <p>Height of markm. above below G.L.</p> <p>Diameter of Vanesm. Height of Cairnm.</p> <p>Original Beacon has/has not been destroyed by me.</p>	
<p>Date</p> <p>28.3.80</p>	<p>Record of Station</p> <p>Construction of pillar & clearing of camphor leaved trees on council land was verbally approved by J. Hinkley, Town Planning Dept.</p> <p>Tweed River Shire Council</p>

CENTRAL MAPPING AUTHORITY

GEODETTIC SURVEY OF N.S.W.

GEODETTIC STATION RECONNAISSANCE and MAINTENANCE REPORT

Description:

1. Cleared by lanes bearing.....
 Note: Cross out word or words which do not apply

2. Mast & Vanes have been painted white & black respectively. ✓

3. The station/pillar was ~~unplaced/lost/unplaced~~/constructed on ~~7th~~ Match..... 19 81..... dimensions now being:

Description of mark..... 114x114..... should be explicit, e.g., S/Steel Pillar Plate, Steel plug, Brass plug, Bolt, G.I. Pipe

Height of mark..... 1.36m..... ^{above} ~~below~~ 1.36m..... Mark is 1.36m..... ^{above} ~~below~~ G.L.

Height of Top Vanes to Top ~~Mark~~ Pillar plate 1.42..... ^{above} ~~below~~ 1.42..... Diameter of Vanes (vertical)..... 750.....m.

Height of Cairn.....m. Diameter of Cairn.....m. Name Plate ~~found/not found~~/placed.

Length of Mast.....m. (approximate if not unplaced)

4. A ~~Stainless Steel~~ Steel..... set in conc/~~rock~~ has been ~~placed~~/found, bearing..... 247.....°M from ~~Monolith~~ Pillar

5. A ~~G.I. Pipe~~ Steel..... set in conc/~~rock~~ has been ~~placed~~/found, bearing..... 260.....°M from ~~Monolith~~ Pillar

6. A ~~Galvanised~~ Steel..... set in conc/~~rock~~ has been ~~placed~~/found, bearing..... 278.....°M from ~~Monolith~~ Pillar

7. A ~~G.I. Pipe~~ Steel..... set in conc/~~rock~~ has been ~~placed~~/found, bearing..... 195.....°M from ~~Monolith~~ Pillar

8. Action required:.....

STANDPOINT: Pillar Plate..... STATION: Stainless Steel Pillar 12 Coast Box


Mark	Direction	Horiz. Distance	Height Difference	Mark	Direction	Horiz. Distance	Height Difference
Harvey Valley P	0 00 00		above standpt	Harvey Valley P	0 00 00		above standpt
Bureau of Land P	35 48 10		below standpt	Bureau of Land P	35 45 00		below standpt
Coastal P	82 12 20		above standpt	Coastal P	82 10 00		below standpt
G.B.M. 182	106 24	10286	below standpt	G.B.M. 182	330 30 50	18581	below standpt
Stainless Steel P	156 58 40	28355	below standpt	Coastal P	335 03 20	26351	below standpt
G.I. Pipe	164 03 50	10124	above standpt	Pillar Plate	337 03 50	24356	below standpt
Coastal Mail	184 33 20	25014	below standpt	G.B.M. 182	357 03 45	23255	below standpt

Prepared by:


Checked:

Noted on U.T.M. Card

Sr 2733-1

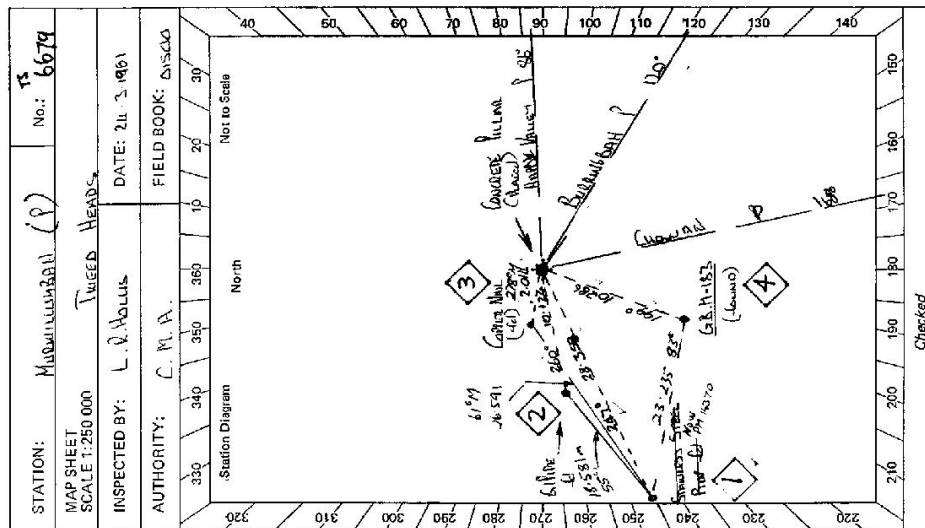

ST 2733-2 D. West, Government Printer

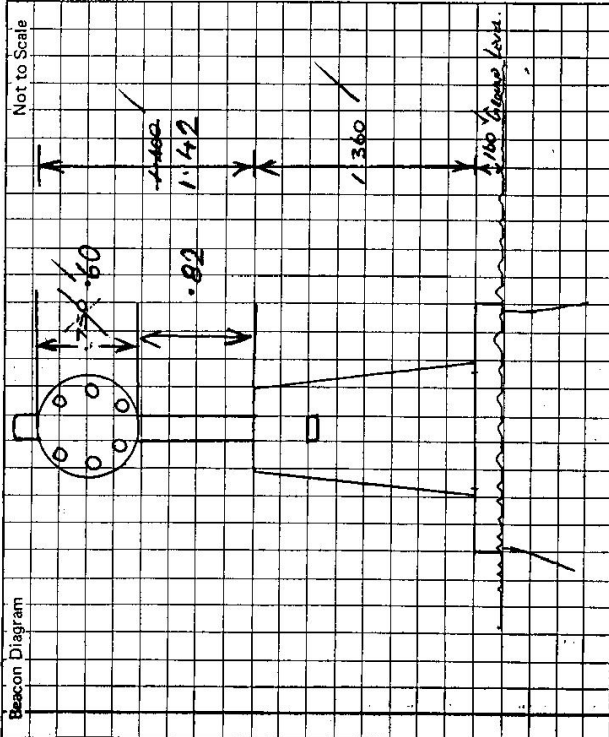

This section to be completed by officer constructing pillar.

Original station mark found/not found.

Description of mark: Small Steel P.D. in Forest Box (Not Under Vines)Original beacon found/~~not found~~Description of beacon: Quarantine P.D.Height Top of Vane to Top Mark Notm.Height of mark Notm. above G.L.
belowDiameter of Vane Notm. Height of Cairnm.Original Beacon has/~~been~~ been destroyed by me.

STATION

MORWILLUMBAH (P) TS 6679Owner's Name: Tucker, Shirley (Sally)

Address:

Phone: 72 2993

Current Occupant:

Address:

Phone:

ACCESS

Access Report of 24/3/1981 was found suitable/unsuitable.

Km.	Feature
0.0	Morwillumbah P.D. head South along Brisbane St.
0.16	Turn Right
0.48	Turn Left sign "Lismore 50 Kyogle 43"
0.89	Turn Right into Concoing St.
0.97	Turn Left into narrow Lane way
1.45	MORWILLUMBAH GS

Note: Key to Reservoir obtained from Town Planning Dept

Record of Station

Date

9/9/91	New effector at. <u>Not</u> (Reported by T. Duffy)

CENTRAL MAPPING AUTHORITY

GEODETTIC SURVEY OF NSW

GEODETTIC STATION RECONNAISSANCE and MAINTENANCE REPORT

Description:

Note: Cross out word or words which do not apply

1. Cleared by lanes bearing..... from Trig. Mast
2. Mast & Vanes have been painted white & black respectively.
3. The station/pillar was unpiled/not unpiled/constructed on..... dimensions now being:
 - Description of mark..... should be explicit, e.g., S/Steel Pillar/Plate, Plug, Boss, Bolt, G.I. Pipe
 - Height of mark..... m. above below rock/concrete; Mark is..... m. above below G.L.
 - Height of Top Vanes to Top Mark/Pillar plate..... m. Diameter of Vanes (vertical)..... m.
 - Height of Cairn..... m. Name Plate found/not found/placed.
 - Length of Mast..... m. (approximate if not unpiled)
4. A..... set in conc/rock has been placed/found, bearing.....°M from Mast/Plug/Pillar
5. A..... set in conc/rock has been placed/found, bearing.....°M from Mast/Plug/Pillar
6. A..... set in conc/rock has been placed/found, bearing.....°M from Mast/Plug/Pillar
7. A..... set in conc/rock has been placed/found, bearing.....°M from Mast/Plug/Pillar

8. Action required: **NOTE: Station & GBM's are levelled. First Order**

STANDPOINT: Conc. Pillar

STANDPOINT: GBM 01831 in Cover Box

Mark	Direction	Horiz. Distance	Height Difference	Mark	Direction	Horiz. Distance	Height Difference
HAPPY VALLEY GS 359 59 60			above standpt.	HAPPY VALLEY GS 359 59 60			above standpt.
BURRINGBAR GS 35 48 14			above standpt.	BURRINGBAR GS 35 49 27			above standpt.
GBM 01831 106 24 30			above standpt.	GBM 01832 174 10 24			above standpt.
GBM 01832 155 40 22			above standpt.	G.I. Pipe 228 32 30			above standpt.
G.I. Pipe in conc 169 03 50			above standpt.	Cu. Nail 275 11 10			above standpt.
Cu. Nail in conc 184 35			above standpt.	MURWILLUMBAH GS 286 28 40			above standpt.

Prepared by: A. Smith

Checked: 6-5-82

Noted on U.T.M. Card

Checked

