

TS 6682

No.: 3787

STATION: **POTTINGER**


MAP SHEET
SCALE 1:250 000
GILGANDRA

INSPECTED BY: **J. Sutton**

DATE: **24th April 1979**

AUTHORITY: **C.M.A.**

FIELD BOOK: **—**

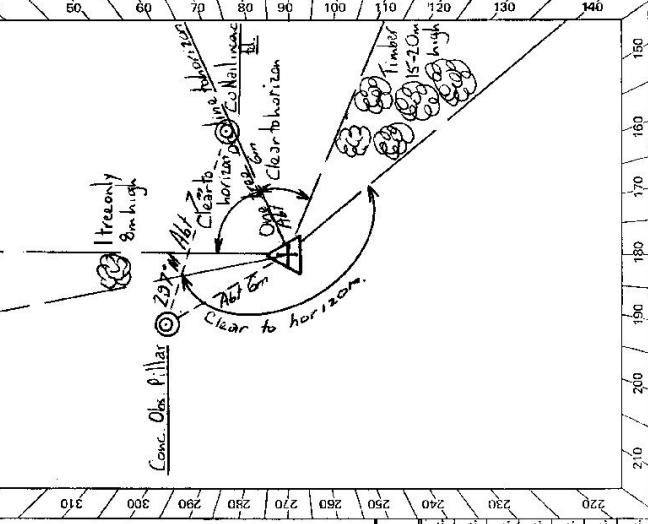

Checked

GEODETTIC SURVEY OF NSW

GEODETTIC STATION RECONNAISSANCE and MAINTENANCE REPORT

Description: *Note: Cross out word or words which do not apply*

1. Cleared by lances bearing $0^{\circ} 65' M$, $6.7^{\circ} - 112^{\circ} M$, $138^{\circ} - 348^{\circ} M$ from Trig. Mast *are*
2. Mast & Vanes ~~have been~~ painted white & black respectively.
3. The station/~~pillar~~ ~~was~~ ~~erected~~ ~~not~~ ~~unpiled~~ ~~erected~~ on **24th April 1979**, dimensions now being: Description of mark ~~should be explicit, e.g., S/Steel Pillar Plate, Steel plug, Brass plug, Bolt, G.I. Pipe~~
Height of mark ~~above~~ ~~below~~ rock/concrete; Mark is ~~above~~ ~~below~~ G.L.
Height of Top Vanes to Top Mark/Pillar plate ~~.....m.~~ Diameter of Vanes (vertical) **0.760** m.
Height of Cairn **2.15** m. Diameter of Cairn **3.06** m. ~~Name Plate found/not found/placed;~~
Length of Mast **4.17** m. (approximate if not unpiled)
4. ~~An~~ ~~existing~~ ~~Pillar~~ set in conc/rock has been ~~placed~~ ~~found~~, bearing **332** M from Mast/~~plug~~ ~~pillar~~
5. ~~A~~ ~~Copper~~ ~~Nail~~ set in conc/rock has been ~~placed~~ ~~found~~, bearing **65** M from Mast/~~plug~~ ~~pillar~~
6. ~~A~~ set in conc/rock has been placed/~~found~~, bearing ~~.....~~ M from Mast/~~plug~~ ~~pillar~~
7. ~~A~~ set in conc/rock has been placed/~~found~~, bearing ~~.....~~ M from Mast/~~plug~~ ~~pillar~~
8. Action required: ~~Pillaring~~ ~~with~~ ~~standard~~ ~~pillar~~ ~~suggested~~ ~~ring~~ ~~gone~~ ~~from~~ ~~top~~ ~~of~~ ~~mast~~.

STANDPOINT:

Mark	Direction	Horiz. Distance	Height Difference	Mark	Direction	Horiz. Distance	Height Difference
			above standpt.				above standpt.
			below				below
			above standpt.				above standpt.
			below				below
Noted on U.T.M. Card

Prepared by: *[Signature]* 24.4.79

Checked:

ST 2735-1

GS 24

STATION **POTTINGER** TS **6682**


Owner's Name: **Mr. A. Whallock**
 Address: **"Round Mountain"**
Tambora Springs
 Phone:

Current Occupant: **Mr. A. Whallock**
 Address:

Phone:

ACCESS **24-4-1979**

Access Report of **1964** was found ~~unsuitable~~/unsuitable.
 km. **0.0** From **Coolah P.O.** proceed towards **Gunnedah**
10.85 Bypass **Conabara** branch turnoff and proceed towards **Gunnedah**.
29.85 Turn left at four letter boxes and up **Round Mountain** road which is **550m** North
 of level crossing at **Connamarra**.
31.35 By pass access road into **"Round Mountain"** (Owner.)
31.35 Cross grid follow road.
33.40 Swing up hillside to right - make way up towards highest point of hill
 over rocky ground. Stop truck **5 mins** walk to trig.

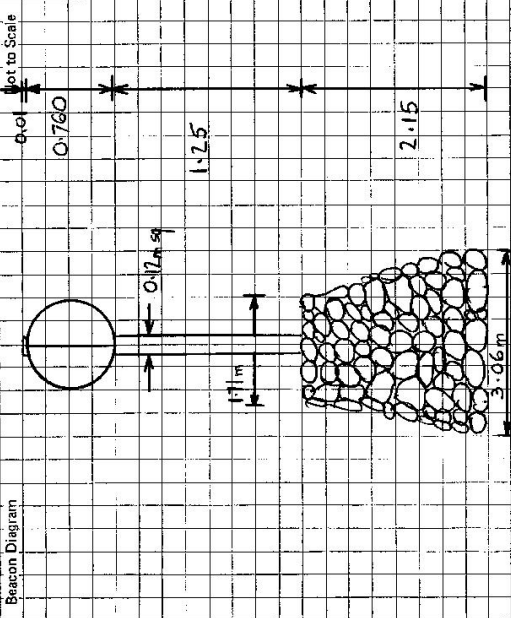

This section to be completed by officer constructing pillar.

Original station mark found/not found.

Description of mark:

Original beacon found/not found.

Description of beacon:

Height Top of Vanes to Top Mark:m.

Height of mark:m. above G.L.
 below

Diameter of Vanesm. Height of Cairnm.

Original Beacon has/not been destroyed by me.

Date	Record of Station

CENTRAL MAPPING AUTHORITY

GEODETIC SURVEY OF N.S.W.
 GEODETIC STATION RECONNAISSANCE and MAINTENANCE REPORT

STATION: **POTTINGER (P)** No.: **6682**

MAP SHEET
 SCALE 1:250 000

INSPECTED BY: **G. L. FORD**

DATE: **19-3-81**

AUTHORITY: **C.M.A.**

FIELD BOOK: **1823**

Description: *Note: Cross out word or words which do not apply*

- Cleared by lanes bearing **2° 51' 58" 6.5 6.7 7.8 110° 11' 22" 36.0** from Trig. Mast
 Close Range **80° - 101**
- Mast & Vanes have been painted white & black respectively. ✓
- The station/pillar was ~~unplaced/not unplaced~~/constructed on **18.3** m. dimensions now being: **19.8** m.
- Description of mark: **S&S PILLAR PLATE** should be explicit, e.g., S/Steel Pillar Plate, ~~Steel pillar, Brass plug, Bolt, Cap plate~~
- Height of mark **1.380** m. above ~~level~~ ^{above} rock/concrete; Mark is **1.470** m. above G.L.
- Height of Top Vanes to Top ~~mark~~/Pillar plate **1.407** m. Diameter of Vanes (vertical) **0.750** m.
- Height of Cairn **0.000** m. Diameter of Cairn **0.000** m. Name Plate found/not found/placed.
- Length of Mast **0.000** m. (approximate if not unplaced)
- BRASS TRIG. PILE** set in ~~conc~~/rock has been ~~placed~~/found, bearing **217**° M from ~~Mast/Pillar~~/Pillar
- COPPER NAIL** set in ~~conc~~/rock has been ~~placed~~/found, bearing **131**° M from ~~Mast/Pillar~~/Pillar
- CONC. SATINITE PILLAR** set in ~~conc~~/rock has been ~~placed~~/found, bearing **395**° M from ~~Mast/Pillar~~/Pillar
- CONC. PILLAR** set in ~~conc~~/rock has been ~~placed~~/found, bearing **000**° M from ~~Mast/Pillar~~/Pillar


Action required: **None**

STANDPOINT: CONC PILLAR				STANDPOINT: BRASS TRIG PILE			
Mark	Direction	Horiz. Distance	Height Difference	Mark	Direction	Horiz. Distance	Height Difference
OAKEY GS	0 00 00		above standpt.	OAKEY GS	0 00 00		above standpt.
TRIG PILE	75 25 20	5.044	above standpt.	SATINITE PILLAR	207 42 50	5.918	above standpt.
SATINITE PILLAR	150 44 00	4.448	above standpt.	CONC PILLAR	255 14 50	5.043	above standpt.
BOMERA (P)	279 46 20		above standpt.	BOMERA (P)	279 46 30		above standpt.
BRANNAN GS	337 12 40		above standpt.	COPPER NAIL	292 55 00	5.238	above standpt.
COPPER NAIL	354 44 00	2.451	above standpt.	BRANNAN GS	337 12 00		above standpt.

Prepared by: **G. L. Ford**

Checked: **G. L. Ford**

512733-1

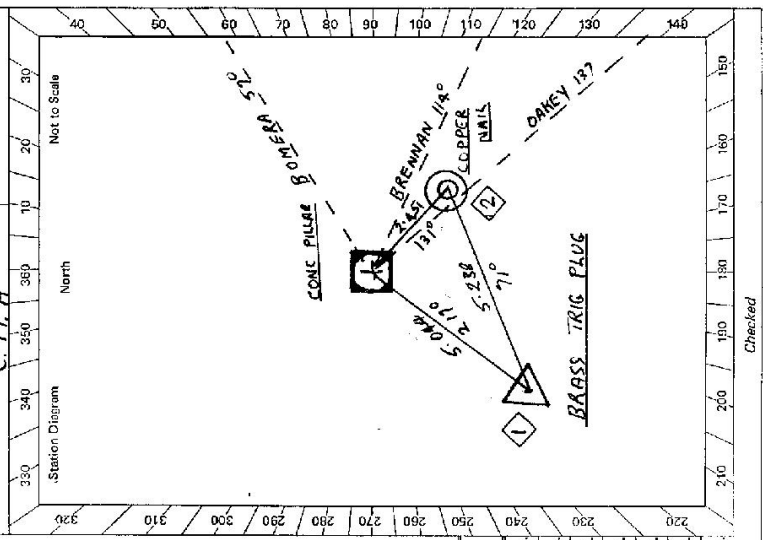

GEODETTIC SURVEY OF N.S.W.

CENTRAL MAPPING AUTHORITY

GEODETTIC STATION RECONNAISSANCE and MAINTENANCE REPORT

- Description:**
 Note: Cross out word or words which do not apply
- Cleared by lanes bearing..... from Trig, Mast
 - Mast & Vanes have been painted white & black respectively.
 - The station/pillar was unpiled/not unpiled/constructed on..... 19....., dimensions now being:
 Description of mark.....should be explicit, e.g., S/Steel Pillar Plate, Steel plug, Brass plug, Bolt, G.I. Pipe
 Height of mark.....m. ^{above} rock/concrete; Mark is.....m. ^{above} _{below} G.L.
 - Height of Top Vanes to Top Mark/Pillar plate.....m. Diameter of Vanes (vertical).....m.
 - Height of Cairn.....m. Diameter of Cairn.....m. Name Plate found/not found/placed.
 - Length of Mast.....m. (approximate if not unpiled)
 - A.....set in conc/rock has been placed/found, bearing.....°M from Mast/Plug/Pillar
 - A.....set in conc/rock has been placed/found, bearing.....°M from Mast/Plug/Pillar
 - A.....set in conc/rock has been placed/found, bearing.....°M from Mast/Plug/Pillar
 - A.....set in conc/rock has been placed/found, bearing.....°M from Mast/Plug/Pillar
 - Action required: SATLITE PILLAR HAS BEEN REMOVED

STANDPOINT: CONE SATLITE PILLAR STANDPOINT:

Mark	Direction	Horiz. Distance	Height Difference	Mark	Direction	Horiz. Distance	Height Difference
DAKEY GS	0 00 00		above standpt.				above standpt.
TRIG PLUG	27 43 40	5.818	above standpt.				above standpt.
BOMERA (P)	279 49 00	0.535	below				below
CONC PILLAR	330 42 10	4.450	above standpt.				above standpt.
BRENNAN GS	337 13 00	0.533	below				below
COPPER NAIL	339 12 10	6.768	below				below

Prepared by: G. L. Ford Checked: Noted on U.T.M. Card

S. 2733-1

STATION: POTTINGER (P) No: 6682
 MAP SHEET SCALE 1:250 000 GILGANDRA
 INSPECTED BY: G. L. Ford DATE: 26-5-81
 AUTHORITY: C. MA FIELD BOOK: 1823

GS 24

STATION POTTINGER (P) TS 6682	Owner's Name: MR. A. WHILLOCK Address: ROUND MOUNTAIN TAMBER SPRINGS (VIA COOLAH) Phone: TAMBER SPRINGS 545 Current Occupant: Address: Phone: ACCESS Access Report of 11.3.1981 was found suitable/unsuitable. 0.0 P.O. COOLAH TAKE GUNNEDAH ROAD NORTH 10.85 PASS ROAD ON LEFT TO COONBARABRAN 29.34 RAILWAY LEVEL CROSSING 29.85 TURN LEFT SIGNPOST (ROUND MOUNTAIN ROAD) 31.35 PASS ROAD ON RIGHT ACCESS TO OWNERS HOUSE 32.35 GRID 33.50 TURN RIGHT AND RIGHT OF WHITE GATES AND HEAD UP HILL ON FAINT TRACK 34.45 TRIG. A.M.D.
Beacon Diagram Not to Scale 	This section to be completed by officer constructing pillar. Original station mark found/ not found . Description of mark: BRASS TRIG. PLUG Original beacon found/ not found . Description of beacon: CAIRN MAST & VANES Height Top of Vanes to Top Mark: 3.590 m. Height of mark: 0.90 m. above rock/ none 1.00 m. above G.L. below Diameter of Vanes 0.760 m. Height of Cairn 2.140 m. Original Beacon has/ has not been destroyed by me.
	Date Record of Station