



STATION 13

CC 1422

GOTS 6685



Owners Name **Mr. K. P. Ryan**

Address **e/- Post Office**

Current Occupant

Address **Coraki**

Access **25-1-1977**

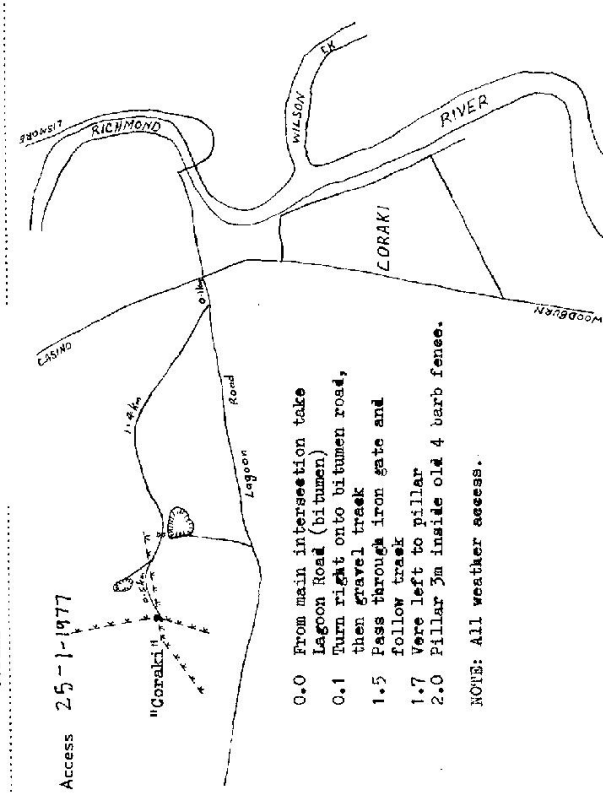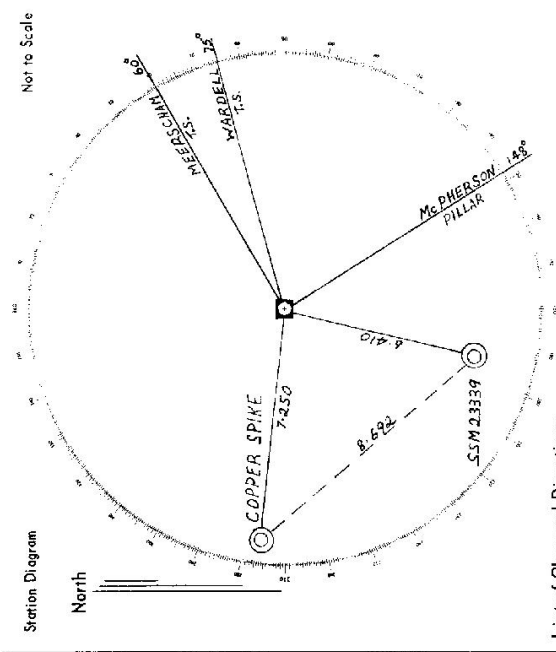

- 0.0 From main intersection take Lagoon Road (bitumen)
  - 0.1 Turn right onto bitumen road, then gravel track
  - 1.5 Pass through iron gate and follow track
  - 1.7 Veer left to pillar
  - 2.0 Pillar 3m inside old 4 barb fence.
- NOTE: All weather access.

List of Observed Directions:-

Standpoint: CONCRETE PILLAR		Standpoint:	
Station	Direction	Station	Direction

Station	Direction	Station	Direction

D. West, Government Printer, New South Wales - 1976

CENTRAL MAPPING AUTHORITY

GEODETTIC SURVEY OF N.S.W.

GEODETTIC STATION RECONNAISSANCE and MAINTENANCE REPORT

Description:

- Cleared by lanes bearing  $(3.0^{\circ} N. 2.2^{\circ} W)$   $(27.0^{\circ} W. 1.15^{\circ} E)$   $(122.0^{\circ} W. 1.15^{\circ} E)$   $(282.0^{\circ} W. 2.2^{\circ} E)$   $(169.0^{\circ} W. 2.2^{\circ} E)$   $(201.0^{\circ} W. 2.2^{\circ} E)$   $(232.0^{\circ} W. 2.2^{\circ} E)$  from Trig. Mast
- Mast & Vanes have been painted white & black respectively.  $(305^{\circ} W. 3.24^{\circ} E)$   $(310^{\circ} W. 3.29^{\circ} E)$   $(-2.31^{\circ} E)$
- The ~~station~~/pillar was ~~reconstructed~~/constructed on  $27.7^{\circ} S. 19.8^{\circ} E$ ..... dimensions now being:  
Description of mark ~~Steel Plate~~ Steel Plate should be explicit, e.g. S/Steel Pillar Plate, Steel plug, Brass plug, Bolt, G.I. Pipe  
Height of mark  $1.376$ .....m. above ~~mark~~ mark concrete; Mark is  $1.470$ .....m. above G.L.  
Height of Top Vanes to Top ~~mark~~/Pillar plate  $1.450$ .....m. Diameter of Vanes (vertical)  $0.752$ .....m.  
Height of Cairn.....m. Diameter of Cairn.....m. Name Plate ~~concrete~~/placed.  
Length of Mast  $1.540$ .....m. (~~approximate~~) On  $28.1.198$ .
- A G.B.M. 115..... set in conc/~~mark~~ has been ~~placed~~/found, bearing  $246.0^{\circ} M$  from ~~Marking~~/Pillar
- A G.I. Pipe..... set in conc/~~mark~~ has been placed/~~found~~, bearing  $20^{\circ} M$  from ~~Marking~~/Pillar
- A..... set in conc/rock has been placed/~~found~~, bearing.....M from Mast/~~Plug~~/Pillar
- A..... set in conc/rock has been placed/~~found~~, bearing.....M from Mast/~~Plug~~/Pillar

Action required:.....

STANDPOINT: Concrete observation pillar STATIONPOINT: G.B.M. No. 115


Mark	Direction	Horiz. Distance	Height Difference	Mark	Direction	Horiz. Distance	Height Difference
Mc Pherson (P)	$0^{\circ} 00' 00''$		above standpt.	McPherson (P)	$0^{\circ} 00' 00''$		above standpt.
G.B.M. NO. 115	$220.15.29$	$4.623$	below standpt.	MYRALLAH (P)	$227.27.34$		above standpt.
MYRALLAH (P)	$221.24.21$		below standpt.	G.I. Pipe	$275.40.42$	$6.257$	$0.341$ above standpt.
G.I. Pipe	$229.24.32$	$2.966$	below standpt.	Meerschauven Tower	$274.37.34$		below standpt.
Meerschauven (Tower)	$274.35.21$		above standpt.	Conc. obs. Pillar	$300.17.01$	$4.621$	$1.609$ above standpt.
CORAKI (P) Lanes Dist	$324.57.23$		above standpt.	CORAKI (P) Lanes Dist	$324.35.58$		below standpt.

Prepared by:

Checked:

Noted on U.T.M. Card

Checked

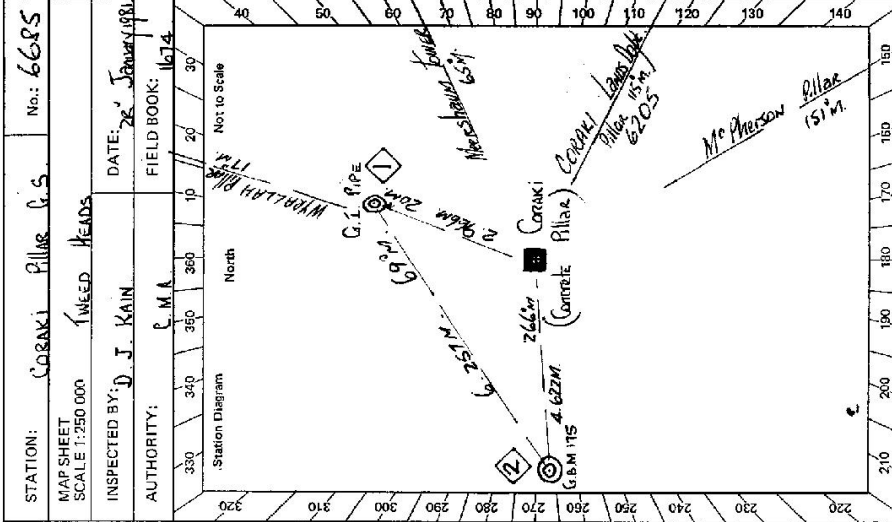


STATION: CORAKI Pillar G.S. No.: 6685

MAP SHEET SCALE 1:250,000

INSPECTED BY: D. J. KAIN

DATE: 28. January 1981

AUTHORITY: C.M.A. FIELD BOOK: 1674

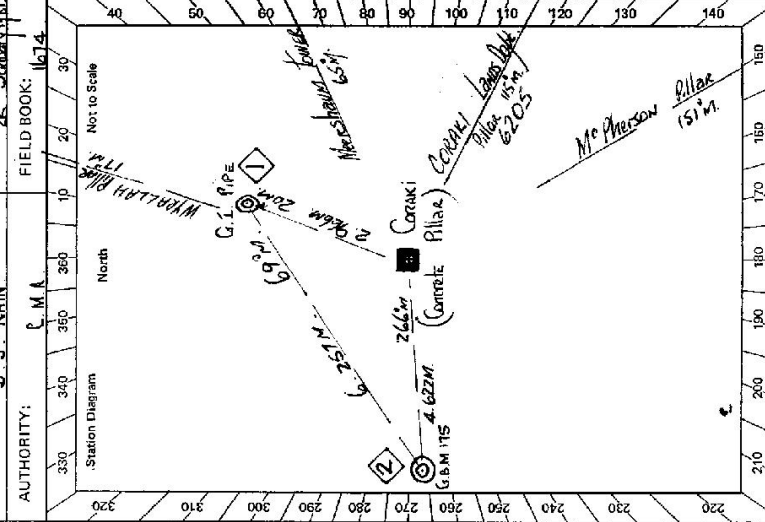

Checked

Noted on U.T.M. Card

Prepared by:

Checked:

Noted on U.T.M. Card

Checked

Noted on U.T.M. Card

Checked

SI 2733-2 D. West, Government Printer

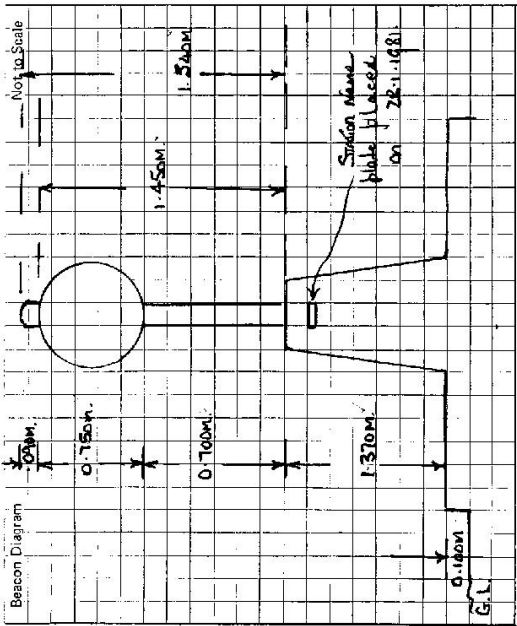

This section to be completed by officer constructing pillar.

Original station mark found/not found.

Description of mark: *Ne W*

Original beacon found/not found.

Description of beacon: *Station*

Height Top of Vane to Top Mark: *Station* m.

Height of mark: *Station* m. above G.L. below

Diameter of Vane: *Station* m. Height of Calm: *Station* m.

Original Beacon has/not been destroyed by me.

STATION **CORAKI (Pillar) TS 6685**

Owner's Name: **MR. A. F. KELLY**

Address: **29, RICHIE STREET, CORAKI**

Phone: **.....**

Neighbour: **MR. K. P. RYAN**

Current Occupation: **74, FAIRLEY STREET, CORAKI**

Phone: **.....**

ACCESS

Access Report of 10/1/1981 Shows found suitable/unsuitable.

**KMS.**

0.00 **Fence. Heading North.**

0.59 **Coraki Post Office Street Turns Left.**

0.78 **Turn right onto Main Road.**

1.25 **Turn Left at Cross Roads "LAGOON ROAD"**

1.40 **Turn Right.**

2.21 **END of Bitumen.**

2.85 **Thru Iron Gate beside Quarry.**

3.13 **Pass Quarry on R.H.S.**

3.41 **Thru wooded Gate on R.H.S. Yards.**

3.76 **Turn Left off Track.**

3.91 **CORAKI, Concrete observation pillar.**

Date	Record of Station

GEODETTIC SURVEY OF N.S.W.

CENTRAL MAPPING AUTHORITY

GEODETTIC STATION RECONNAISSANCE and MAINTENANCE REPORT

Description: *Note: Cross out word or words which do not apply*

1. Cleared by lanes bearing..... from Trig, Mast

2. Mast & Vanes have been painted white & black respectively.

3. The station/pillar was ~~located on~~ *DESTROYED* on ~~S.S. 19 S.A.~~..... dimensions now being: *DESTROYED*

Description of mark..... should be explicit, e.g., S/Steel Pillar Plate, Steel plug, Brass plug, Bolt, G.I. Pipe

Height of mark..... above ~~rock/concrete~~ *above G.L.* Mark is ~~4.472~~.....m. Diameter of Vanes (vertical).....m.

Height of Top Vanes to Top ~~Mast/Pillar plate~~.....m. Diameter of Vanes (vertical).....m.

Height of Cairn.....m. Diameter of Cairn.....m. Name Plate found/not found/placed.

Length of Mast.....m. (~~approximate~~)

4. A ~~Conc/Mast~~ *Mast*..... set in conc/~~rock~~ has been placed/~~found~~, bearing.....°M from ~~Mast/Plug/Pillar~~

5. A..... set in conc/rock has been placed/found, bearing.....°M from Mast/Plug/Pillar

6. A..... set in conc/rock has been placed/found, bearing.....°M from Mast/Plug/Pillar


7. A..... set in conc/rock has been placed/found, bearing.....°M from Mast/Plug/Pillar

8. Action required:.....

STANDPOINT: <i>General TS</i> <del>Pillar Plate</del>			STANDPOINT: <i>Corner Nail</i> <del>used</del>				
Mark	Direction	Horiz. Distance	Height Difference	Mark	Direction	Horiz. Distance	Height Difference
<i>Mt Henson GS (P)</i>	<i>0 00 00</i>		above standpt.	<i>Mt Henson GS (P)</i>	<i>0 00 00</i>		above standpt.
<i>General GS (P)</i>	<i>143 11 50</i>		above standpt.	<i>General TS</i>	<i>143 10 10</i>	<i>2.517</i>	below standpt.
<i>WARRAN GS (P)</i>	<i>173 58 30</i>		above standpt.	<i>General GS (P)</i>	<i>143 11 00</i>		above standpt.
<i>BROADWATER GS (P)</i>	<i>302 11 20</i>		above standpt.	<i>Miyallia GS (P)</i>	<i>273 57 50</i>		above standpt.
<i>Corner Nail</i>	<i>313 04 40</i>	<i>2.505</i>	above standpt.	<i>BROADWATER GS (P)</i>	<i>303 10 15</i>		above standpt.
			below				below
			below				below
			below				below

Prepared by: *L.R. Boulton* Checked: *L.R. Boulton* Noted on U.T.M. Card

S: 2723-1

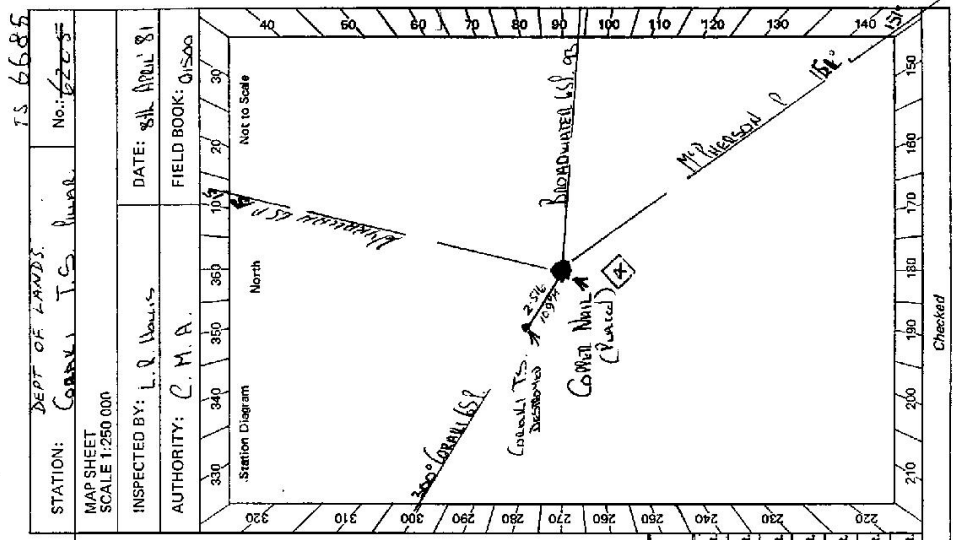

STATION: DEPT OF LANDS. *General TS* ~~Pillar~~ No: *6220-F*


MAP SHEET SCALE 1:250 000

INSPECTED BY: *L.R. Boulton* DATE: *21 APRIL 81*

AUTHORITY: *C.M.A.* FIELD BOOK: *01500*

*TS 6685*

61-2733-2 D. West, Government Printer

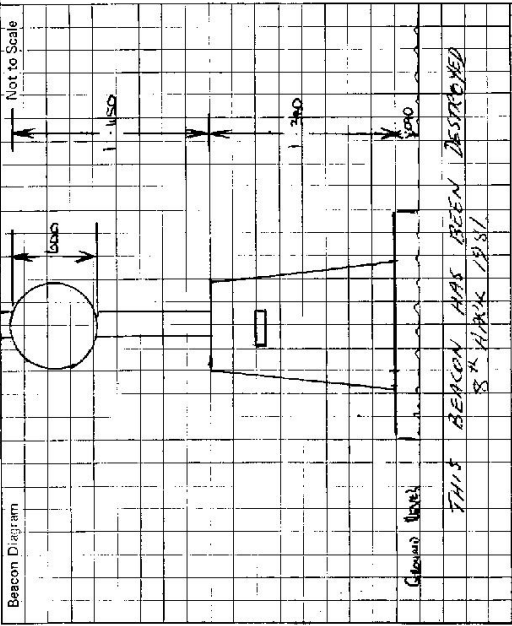

This section to be completed by officer constructing pillar.

Original station mark found/~~not found~~.

Description of mark: AS ABOVE

Original beacon found/~~not found~~.

Description of beacon: .....

Height Top of Vanes to Top Mark: .....m.

Height of mark: .....m. above rock/conc .....m. below G.L.

Diameter of Vanes: .....m.

Original Beacon has/has not been destroyed by me. Height of Cairn .....m.

STATION CONNALTS 6685

Owner's Name: Mr K P Ryan  
 Address: 24 Farley Street  
 Phone: Casine


Owner: Connal G.S (P)  
 Address: 29 Baggot St  
 Phone: CONNAL

ACCESS

Access Report of 14/16/1978 was found suitable/~~unsuitable~~.

- Feature
- Connal Police Station
- Turn Right BP
- Leaving on corner
- Turn Left into
- Lagoon Rd
- Turn Right
- Gate beside Quarry
- Turn Right along fence
- Cu. Nail over fence
- (See locality sketch)

Km.	0.0
	0.2
	0.8
	0.9
	2.2
	2.8
	2.9

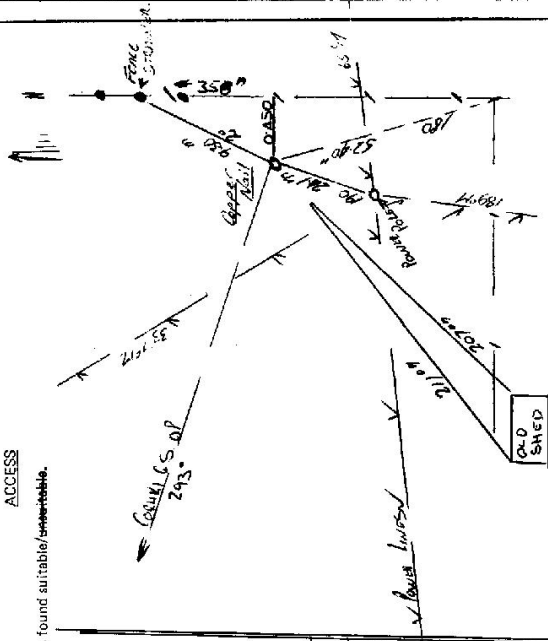

Record of Station

Date

6685

GEODETIC SURVEY OF N.S.W.

CENTRAL MAPPING AUTHORITY

GEODETIC STATION RECONNAISSANCE and MAINTENANCE REPORT

Description:

Note: Cross out word or words which do not apply

- Cleared by lanes bearing..... 350° M..... from Trig. Mast
- Mast & Vanes have been painted white & black respectively.
- The station/pillar was ~~unplaced/not unplaced~~ constructed on..... 19..... dimensions now being:
  - Description of mark..... S/S Pillar Plate could be explicit, e.g., S/Steel Pillar Plate, Steel plug, Brass plug, Bolt, G.I. Pipe
  - Height of mark..... m. above rock/concrete; Mark is..... m. above G.L.
  - Height of Top Vanes to Top Mark/Pillar plate..... m. Diameter of Vanes (vertical)..... m.
  - Height of Cairn..... m. Diameter of Cairn..... m. Name Plate found/not found/placed.
  - Length of Mast..... m. (approximate if not unplaced)
- A..... set in conc/rock has been placed/found, bearing.....° M from Mast/Plug/Pillar
- A..... set in conc/rock has been placed/found, bearing.....° M from Mast/Plug/Pillar
- A..... set in conc/rock has been placed/found, bearing.....° M from Mast/Plug/Pillar
- A..... set in conc/rock has been placed/found, bearing.....° M from Mast/Plug/Pillar
- Action required:..... No clearing required, however new cover box for S.S.M. required

STANDPOINT: SSM 23339 (6205-6)

STANDPOINT: Cu nail in conc (6205-4)

Mark	Direction	Horiz. Distance	Height Difference	Mark	Direction	Horiz. Distance	Height Difference
BROADWATER (5522-0)	0° 00' 00"		above standpt.	BROADWATER (5522-0)	0° 00' 00"		above standpt.
M'PHERSON (5549-0)	57° 47' 30"		above standpt.	M'PHERSON (5549-0)	57° 49' 17"		above standpt.
CORAKI S/S (6205-0)	202° 00' 52"		above standpt.	SSM 23339 (6205-6)	121° 52' 00"	6.387	0.031 below
Cu spike in conc (6205-5)	224° 14' 20"	0.105	0.122 below	Cu spike in conc (6205-5)	183° 51' 40"	9.631	0.153 below
Cu nail in conc (6205-4)	301° 52' 00"	6.387	0.031 below	CORAKI S/S (6205-0)	201° 00' 28" 5"		above standpt.
			above standpt.				below

Prepared by: S. J. O. G.

Checked: A.

Noted on U.T.M. Card

Checked

STATION: CORAKI No: 6205  
 MAP SHEET SCALE 1:250 000 TWEED HEADS  
 INSPECTED BY: D HALLS DATE: 5-6-1981  
 AUTHORITY: C.M.A. FIELD BOOK: 106

Station Diagram

for diagram see over page.

\*fil replaced by W Harris 15.5.84

STATION **CORAKI (Pillar) 6685**


Owner's Name: **MS. A. F. Kelly**  
 Address: **29 Bridge St CORAKI**  
 Phone: .....

Neighbour  
 Current Occupant: **Mr. K. P. Ryan**  
 Address: **24 Fairley St**  
 Phone: **64511020**

**ACCESS**

Access Report of 10/11/1988 was found suitable/feasible.

- 0.0 kms **CORAKI RD. head north**
- 0.50 **Street turns left**
- 0.78 **Turn right onto main road**
- 1.25 **Turn left at cross roads "Lagoon Road"**
- 1.40 **Turn right**
- 2.21 **End of Bitemen**
- 2.85 **Thru iron gate beside quarry.**
- 3.13 **Original GS is on LHS through fence, as in diag**
- 3.41 **Thru wooden gate on R.H.S. yards.**
- 3.76 **Turn left off track**
- 3.91 **Coraki, Concrete observation pillar**

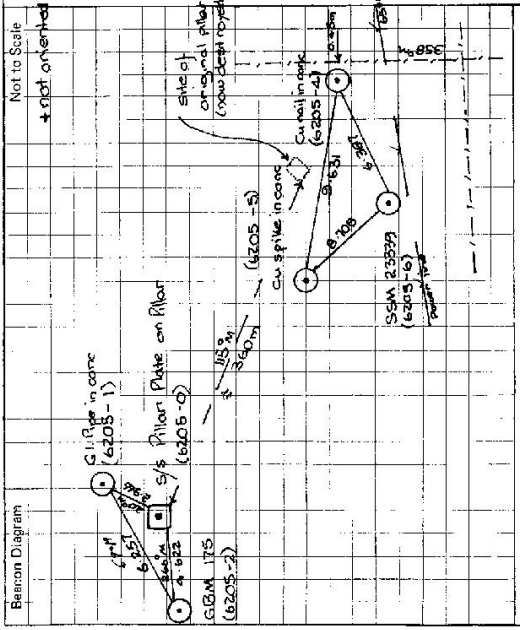

This section to be completed by officer constructing pillar.

Original station mark found/not found.

Description of mark: .....

Original beacon found/not found.

Description of beacon: .....

Height Top of Vanes to Top Mark: .....m.

Height of mark: .....m. above G.L. below G.L.

Diameter of Vanes: .....m.

Original Beacon has/has not been destroyed by me.

Date	Record of Station