


ROBINSON (P) TS 6697

STATION: NEW COBAR T.S. No: 6697

MAP SHEET SCALE 1:250 000 COBAR

INSPECTED BY: P. CARR DATE: 5-3-81

AUTHORITY: C.M.A. FIELD BOOK: C.77

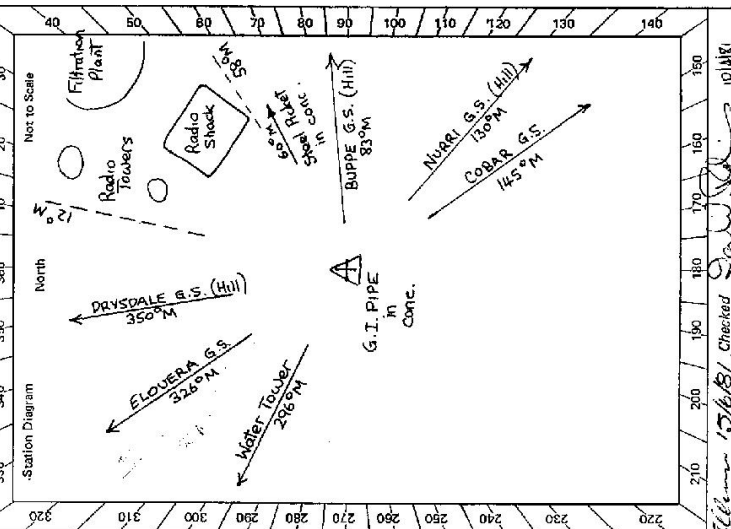

CENTRAL MAPPING AUTHORITY
 GEODETIC SURVEY OF N.S.W.
 GEODETIC STATION RECONNAISSANCE and MAINTENANCE REPORT

- Description:
1. Cleared by lines bearing $58^{\circ}M - 12^{\circ}M$ from Trig. Mast
 Note: Cross out word or words which do not apply
 2. Mast & Vanes have been painted white & black respectively. N/A
 3. The station/pillar was unpiled/not unpiled/constructed on 19....., dimensions now being:
 Description of mark: G.I. PIPE..... should be explicit, e.g., S/Steel Pillar Plate-Steel plug, Brass plug, Bolt, G.I. Pipe
 in conc. above rock/concrete; Mark is.....m. above G.L. below
 Height of mark.....m. above rock/concrete; Mark is.....m. above G.L. below
 Height of Top Vanes to Top Mark/Pillar plate N/A.....m. Diameter of Vanes (vertical) N/A.....m.
 Height of Cairn.....m. Diameter of Cairn.....m. Name Plate found/not found/placed.
 Length of Mast N/A.....m. (approximate if not unpiled)
 4. A. STEEL PLACKET..... set in conc./rock has been placed/found, bearing..... $60^{\circ}M$ from Mast/Plug/Pillar
 5. A..... set in conc./rock has been placed/found, bearing..... M from Mast/Plug/Pillar
 6. A..... set in conc./rock has been placed/found, bearing..... M from Mast/Plug/Pillar
 7. A..... set in conc./rock has been placed/found, bearing..... M from Mast/Plug/Pillar
 8. Action required: CONCRETE OBSERVATION PILLAR TO BE ESTABLISHED ADJACENT G.I. PIPE
 (See Council before construction)

STANDPOINT:

Mark	Direction	Horiz. Distance	Height Difference	Mark	Direction	Horiz. Distance	Height Difference
			above standpt.				above standpt.
			below				below
			above standpt.				above standpt.
			below				below
Prepared by: P. CARR 9/4/81 Checked: [Signature]

Noted on U.T.M. Card [Signature]

STATION NEW COBAR T.S. 6697	Owner's Name: SEE COUNCIL Address: Phone: Current Occupant: Address: Phone: Access Report of 5.3/1981 was found suitable/unsuitable. ACCESS Km 0-0 COBAR P.O. HEAD TOWARDS HWY. 0-2 TURN RIGHT ALONG HWY. 0-9 TURN RIGHT. 1-1 OVER GRID. 2-1 TURN LEFT. 3-4 TAKE TRACK TO LEFT 3-8 AT TRIG.
Beacon Diagram Not to Scale 	This section to be completed by officer constructing pillar. Original station mark found/not found. Description of mark: Original beacon found/not found. Description of beacon: Height Top of Vanes to Top Markm. Height of markm above rock/catchm above G.L. below Diameter of Vanesm. Height of Cairnm. Original Beacon has/has not been destroyed by me.
Date	Record of Station

SI 2733-2 D West Government Printer

CENTRAL MAPPING AUTHORITY
 GEODETIC SURVEY OF N.S.W.
 GEODETIC STATION RECONNAISSANCE and MAINTENANCE REPORT


STATION: ROBINSON No: 6697
 MAP SHEET: 507 SCALE: 1:250 000
 INSPECTED BY: COBARR DATE: 13 5 81
 AUTHORITY: CMA FIELD BOOK: 1820

Description:
 1. Cleared by lanes bearing 360° Note: Cross out word or words which do not apply
 2. Mast & Vanes have been painted white & black respectively.
 3. The station/pillar was ~~unplaced~~ unplaced / constructed on 12.5 19.8 19.8, dimensions now being:
 Description of mark: S/Steel Pillar Plate, Steel plug, Brass plug, Bolt, G.I. Pipe
 Height of mark: 2.000m ^{above} ~~below~~ reek/concrete Mark is 4.58245 m. ^{above} ~~below~~ G.L.
 Height of Top Vanes to Top Mark/Pillar plate: 1.497 m. Diameter of Vanes (vertical): 0.177 m.
 Height of Cairn: m. Diameter of Cairn: m. Name Plate found/not found/placed.
 Length of Mast: m. (approximate if not unpiled)
 4. DIRECTION PILLAR set in conc/rock has been placed / found, bearing 302.7 ° M from Mast/Plug/Pillar
 5. A. COPPER NAIL set in conc/rock has been placed / found, bearing 323 ° M from Mast/Plug/Pillar
 6. A. set in conc/rock has been placed / found, bearing ° M from Mast/Plug/Pillar
 7. A. set in conc/rock has been placed / found, bearing ° M from Mast/Plug/Pillar
 8. Action required: 0° 50' 40"

STANDPOINT: S/S PILLAR PLATE			STANDPOINT: CORNER NAIL		
Mark	Direction	Horiz. Distance	Mark	Direction	Horiz. Distance
COBARR CS (P)	0 00 00		COBARR CS (P)	0 00 00	
WATER TOWER	149 33 30		DIRECTION PILLAR	120 50 40	7 101
DIRECTION PILLAR	160 25 30	4 331	WATER TOWER	149 31 50	
COPPER NAIL	173 07 35	11 262	ELEGERA CS	179 14 55	
ELEGERA CS	179 13 25	11 262	S/S PILLAR PLATE	353 08 05	11 262

Height Difference
 above standpt. / below standpt.
 above standpt. / below standpt.
Prepared by: *ML* Checked: *CL* Noted on U.T.M. Card

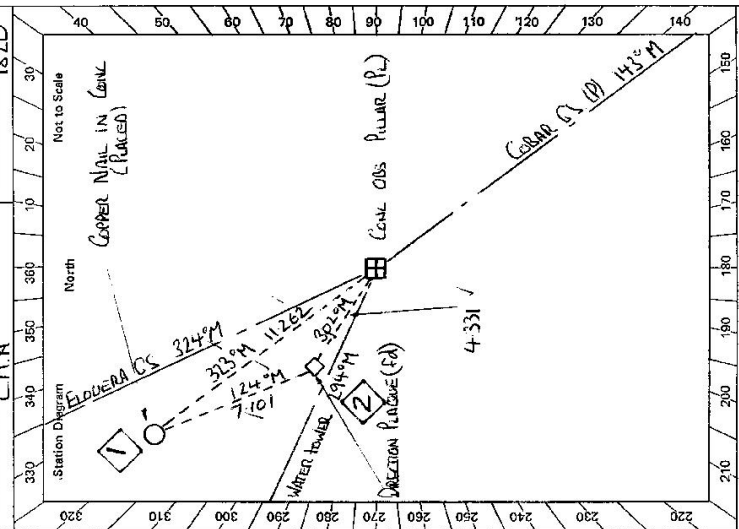

STATION ROBINSON
FORT BOORKE CS (P) TS 6697


Owner's Name: CEGAR SHIRE COUNCIL
Address: CEGAR
Phone: 080 362 005 - Liz Cameron
Burnham, Hawkes Bay, NZ

Current Occupant:
Address:
Phone:

ACCESS 13-5-1981

Access Report of 5/3/1981 was found usable/unsuitable.

0.0 CEGAR PO. HEAD NORTH.
0.15 TURN RIGHT INTO MAIN STREET.
0.2 TURN RIGHT SIGN "CONDOLOIN HILLSTON"
1.05 CROSS GRAD
2.05 TURN LEFT SIGN "FILTRATION PLANT"
3.35 PASS ROAD ON RIGHT SIGN "TOWSER HUT"
3.6 FORT BOORKE C.S. (P) ON TOP OF BUILDING.

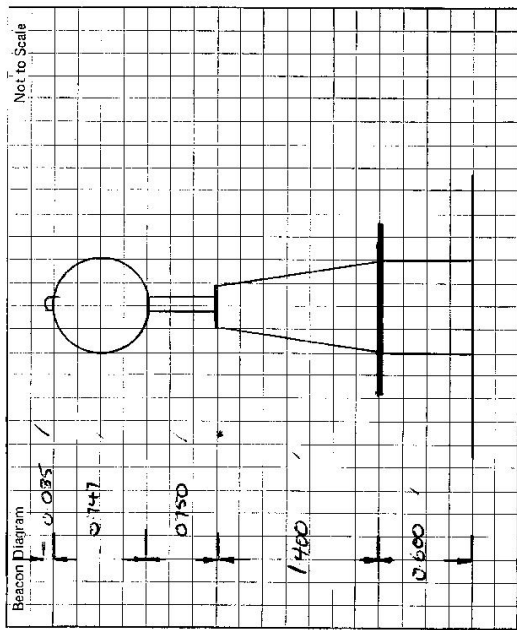

This section to be completed by officer constructing pillar.

Original station mark found/not found.
Description of mark:
Original beacon found/not found.
Description of beacon:
Height Top of Vanes to Top Markm.
Height of markm. above G.L.
below G.L.
Diameter of Vanesm. Height of Cairnm.
Original Beacon has/has not been destroyed by me.

Date	Record of Station
23/7/94	Station visited - occupied with GPS for SRA Freight rail job.