

7-4-98

Trigonometrical Survey of N.S.W.

CENTRAL MAPPING AUTHORITY

Department of Lands

RECONNAISSANCE and MAINTENANCE REPORT

STATION BACKALUM G.S. 670

This Trig. Station has been:-

Note: Cross out word or words which do not apply

1. Completely cleared to permit 360° vision to surrounding Trigs.
2. Cleared by lanes bearing 2.4.8.0M ✓ from Trig. Mast
3. Trig. Mast & Vanes ~~have been~~ ^{need} painted white & black respectively.
4. The Trig. was ~~unpiled~~ not unpiled, dimensions now being: ~~and~~ ^{and} Station Mast ~~found~~ not found

Description of mark..... should be explicit, e.g. Steel plug, Brass plug, Bolt, G.I. Pipe

Height of mark..... m ^{above} rock/concrete m ^{below} G.L.

Height of Top Vanes to Top Mark..... m. Diameter of Vanes (vertical) 0.76 m. ✓

Height of Cairn 1.5.8 m. ✓ Diameter of Cairn 2.3 m. ✓

Length of Mast 3.7 m. ✓ (approximate if not unpiled)

5. A..... set in conc/rock has been placed..... m. bearing.....°M from Trig. Mast
6. A. ~~G.I. PIPE~~ ✓ set in ~~conc~~/soil has been placed 5.3 m. bearing.....°M from Trig. Mast
7. A..... set in conc/soil has been placed..... m. bearing.....°M from Trig. Mast
8. A..... set in conc/rock has been placed..... m. bearing.....°M from Trig. Mast


9. Connection..... to..... m. bearing.....°M
10. Connection..... to..... m. bearing.....°M
11. Connection..... to..... m. bearing.....°M
12. Connection..... to..... m. bearing.....°M
13. Diff. Ht. is..... m. ^{above} _{below}
14. Diff. Ht. is..... m. ^{above} _{below}
15. Diff. Ht. is..... m. ^{above} _{below}
16. Diff. Ht. is..... m. ^{above} _{below}

Prepared by: Jeff Brown 12-5-77 Checked: [Signature] 19-5-77 Noted on U.T.M. Card

Co:

Map Sheet: BERRIDALE 1:100,000 No: 8625 (60) ✓
 Inspected by: A. WOODRUFF ✓ Date: 21st JAN 1977
 Authority: CENTRAL MAPPING ✓ Field Book: 1530 L

Beacon Diagram
 Vanes need painting black 0-02L
 Mast is square 0-09 thick ✓
 Mast is leaning & needs painting white. ✓

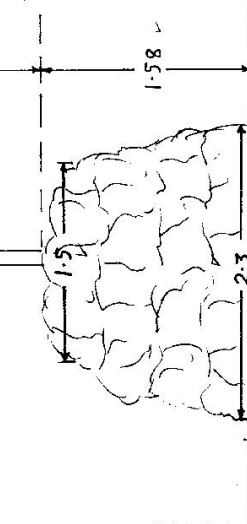

Date	Record of Station
21/1/77	Mast is leaning and needs painting. Vanes need painting also.

Checked: Alan Woodm 27/3/79.

CENTRAL MAPPING AUTHORITY

GEODETIC SURVEY OF N.S.W.

GEODETIC STATION RECONNAISSANCE and MAINTENANCE REPORT

STATION: **BACKALUM** No.: **670**

Description:

1. Cleared by lanes bearing.....
 Note: *Cross out word or words which do not apply*

2. ~~Mast & Vanes have been painted white & black respectively.~~

3. The station/pillar was unpiled/hot unpiled/constructed on..... 19....., dimensions now being:

Description of mark..... should be explicit, e.g., S/Steel Pillar Plate, Steel plug, Brass plug, Bolt, G.I. Pipe

Height of mark.....^{above} rock/concrete; Mark is.....^{above}.....^{below} G.L.

Height of Top Vanes to Top Mark/Pillar plate.....m. Diameter of Vanes (vertical).....m.

Height of Cairn.....m. Diameter of Cairn.....m. Name Plate found/not found/placed,

Length of Mast.....m. (approximate if not unpiled)

4. A.....set in conc/rock has been placed/found, bearing.....° M from Mast/Plug/Pillar

5. A.....set in conc/rock has been placed/found, bearing.....° M from Mast/Plug/Pillar

6. A.....set in conc/rock has been placed/found, bearing.....° M from Mast/Plug/Pillar

7. A.....set in conc/rock has been placed/found, bearing.....° M from Mast/Plug/Pillar

8. Action required: Needs painting black and white.....

STANDPOINT:

STANDPOINT:


Mark	Direction	Horiz. Distance	Height Difference	Mark	Direction	Horiz. Distance	Height Difference
			above standpt				above standpt
			below				below
			above standpt				above standpt
			below				below
Prepared by: **g. Keep 24/7/80** Checked: _____

Noted on U.T.M. Card

Checked

SI 2733-1

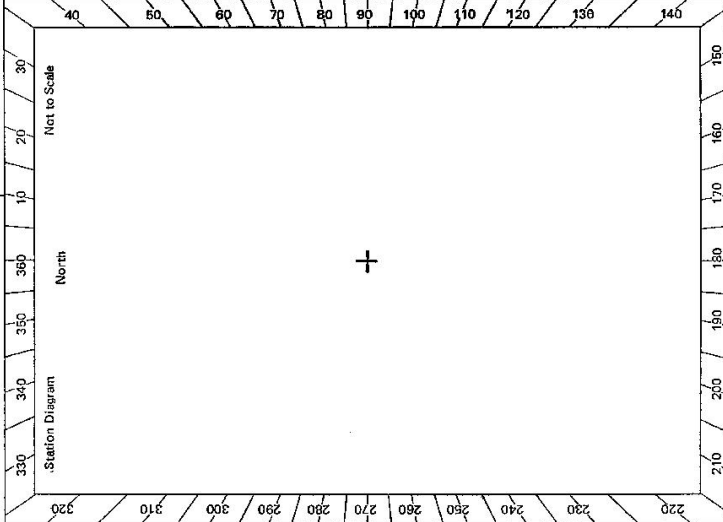

MAPSHEET SCALE 1:250 000 **BE6A**
 INSPECTED BY: **G. KEEP** DATE: **27/5/80**
 AUTHORITY: _____
 FIELD BOOK: _____

