

GEODEIC SURVEY OF N.S.W.

CENTRAL MAPPING AUTHORITY

GEODEIC STATION RECONNAISSANCE and MAINTENANCE REPORT


STATION: **MERRYONG P.** No.: **6700**

MAP SHEET SCALE 1:250 000 **GUNNING**

INSPECTED BY: **A. Hancock** DATE:

AUTHORITY: **D.M.R.**

FIELD BOOK: **0002-181 Pg. 0744**

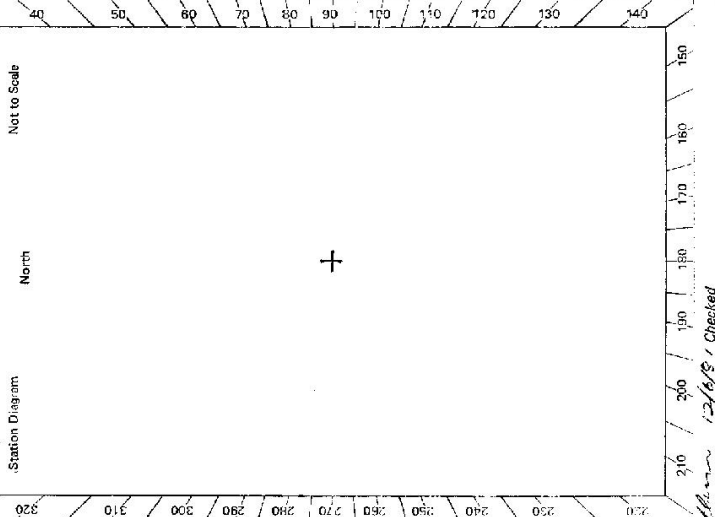

Description:

1. Cleared by lanes bearing.....**clear**.....**ALL ROUND**.....**SOME SINGLES TREES**.....**from Trig. Mast**

2. Mast & Vanes have been painted white & black respectively.

3. The ~~staves~~/pillar was ~~erected/not erected~~/constructed on.....**FERRARY**.....**1950**..... dimensions now being:

Description of mark.....**S/S Pillar Plate**.....should be explicit, e.g., S/Steel Pillar Plate, Steel plug, Brass plug, Bolt, G.I. Pipe

Height of mark.....**3.75**.....m. <sup>above</sup> ~~below~~ rock/concrete; Mark is.....**4.02**.....m. <sup>above</sup> ~~below~~ G.L.

Height of Top Vanes to Top-Mark/Pillar plate.....**4.44**.....m. Diameter of Vanes (vertical).....**2.22**.....m.

Height of Cairn.....m. Diameter of Cairn.....m. Name Plate found/not found/placed.

Length of Mast.....m. (approximate if not unplied)

4. A.....**Trig. Plug**.....set in conc/rock-has been placed/found, bearing.....**0**.....°M from Mast/Plug/Pillar

5. A.....**R.M. Spike**.....set in conc/rock has been placed/found, bearing.....**0**.....°M from Mast/Plug/Pillar

6. A.....set in conc/rock has been placed/found, bearing.....**0**.....°M from Mast/Plug/Pillar

7. A.....set in conc/rock has been placed/found, bearing.....**0**.....°M from Mast/Plug/Pillar

8. Action required.....

STANDPOINT: **Pillar Plate**

STANDPOINT: **T.S. Plug**

Mark	Direction	Horiz. Distance	Height Difference	Mark	Direction	Horiz. Distance	Height Difference
<b>COLLARIN P.</b>	<b>0° 00' 00"</b>		standpt. above	<b>COLLARIN P.</b>	<b>0° 00' 00"</b>		standpt. above
<b>EDWARD P.</b>	<b>25° 49' 30"</b>		standpt. above	<b>EDWARD P.</b>	<b>25° 49' 41"</b>		standpt. above
<b>R.M. spike in conc</b>	<b>65° 03' 40"</b>	<b>4.985</b>	standpt. above	<b>R.M. spike in conc.</b>	<b>51° 51' 40"</b>	<b>10.791</b>	standpt. above
<b>T.S. Plug</b>	<b>29° 23' 40"</b>	<b>6.728</b>	standpt. above	<b>Pillar Plate</b>	<b>110° 23' 09"</b>	<b>6.728</b>	standpt. above
			standpt. below				standpt. below
			standpt. above				standpt. above
			standpt. below				standpt. below
			standpt. above				standpt. above
			standpt. below				standpt. below

Prepared by: **A. Hancock**


Checked:

Noted on U.T.M. Card

ST 2733-1

*Handwritten signature and date: 12/6/18, Checked*

<b>STATION MERRYONG P. TS 6700</b>	<p>Owner's Name: .....                  Address: .....                  Phone: .....</p> <p>Current Occupant: Unoccupied                  Address: .....                  Phone: .....</p> <p>ACCESS                  Access Report of ...../19..... was found suitable/unavailable.</p>
	<p>Date: .....</p> <p>Record of Station: .....</p>

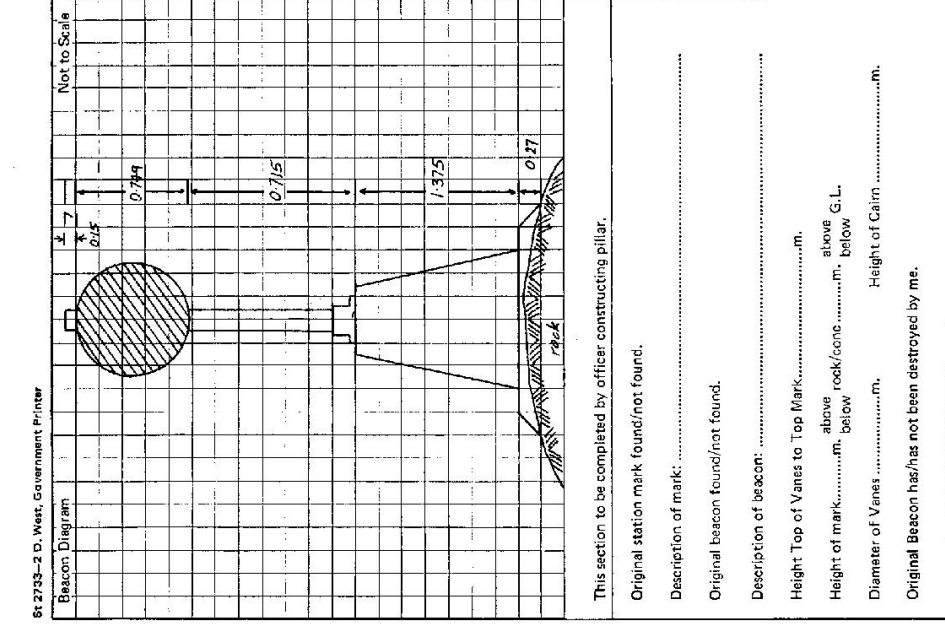

4-59

CENTRAL MAPPING AUTHORITY  
Department of Lands

Trigonometrical Survey of N.S.W.

RECONNAISSANCE and MAINTENANCE REPORT

STATION MERRYONG TS 6700

This Trig. Station has been:-

Note: Cross out word or words which do not apply

1. ~~Completely cleared to permit 360° vision to surrounding trig.~~

2. Cleared by lanes bearing  $0^{\circ} 20'$ ,  $250^{\circ} 30'$ ,  $340^{\circ} 35'$  from Trig. Mast

3. ~~Trig. Mast & Vanes have been painted white & black respectively.~~

4. The Trig. was unpiled/not unpiled, dimensions now being:

Description of mark Brass Plug should be explicit, e.g. Steel plug, Brass plug, Bolt, G.I. Pipe

Height of mark  $\dots$  m above rock/concrete  $\dots$  m below G.L.

Height of Top Vanes to Top Mark  $\dots$  m Diameter of Vanes (vertical) (no. vanes)  $\dots$

Height of Cairn (no. cairns)  $\dots$  m Diameter of Cairn  $\dots$  m.

Length of Mast  $3.89$  m. (approximate if not unpiled)

5. A ~~set in conc/rock has been placed~~  $\dots$  m. bearing  $\dots^{\circ}$  M from Trig. Mast

6. A ~~set in conc/soil has been placed~~  $\dots$  m. bearing  $\dots^{\circ}$  M from Trig. Mast

7. A ~~set in conc/soil has been placed~~  $\dots$  m. bearing  $\dots^{\circ}$  M from Trig. Mast

8. A ~~set in conc/rock has been placed~~  $\dots$  m. bearing  $\dots^{\circ}$  M from Trig. Mast

9. Connection  $\dots$  to  $\dots$  m. bearing  $\dots^{\circ}$  M

10. Connection  $\dots$  to  $\dots$  m. bearing  $\dots^{\circ}$  M

11. Connection  $\dots$  to  $\dots$  m. bearing  $\dots^{\circ}$  M

12. Connection  $\dots$  to  $\dots$  m. bearing  $\dots^{\circ}$  M

13. Diff. Ht.  $\dots$  is  $\dots$  m. <sup>above</sup> ~~below~~

14. Diff. Ht.  $\dots$  is  $\dots$  m. <sup>above</sup> ~~below~~

15. Diff. Ht.  $\dots$  is  $\dots$  m. <sup>above</sup> ~~below~~

16. Diff. Ht.  $\dots$  is  $\dots$  m. <sup>above</sup> ~~below~~

Prepared by: B. MITCHELL 31.7.75 Checked: JH GILLIES 8 AUG. 1975 Noted on U.T.M. Card


Co: KING Ph: DIXON

Map Sheet: GUNNING No: 8728

Inspected by: JH GILLIES Date: 22.7.75

Authority: D.M.R. Field Book:

Beacon Diagram Not to Scale

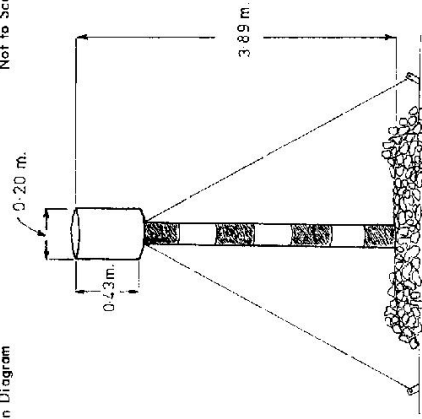

Red and white mast with yellow marker


Date Record of Station

Checked



Department of Lands  
 Integral Survey of N.S.W.  
**RECONNAISSANCE and MAINTENANCE REPORT**  
 This Trig. Station has been:-  
 Note: Cross out word or words which do not apply

STATION TS 3052 MERRYONG (P) 6700  
 Co: KING'S Ph: DIXON  
 Map Sheet: GUNNING No: S728-11 x 111  
 Inspected by: H. J. GREEN Date: 20-2-80  
 Authority: Intelligence Survey Field Book: Intelligence Survey

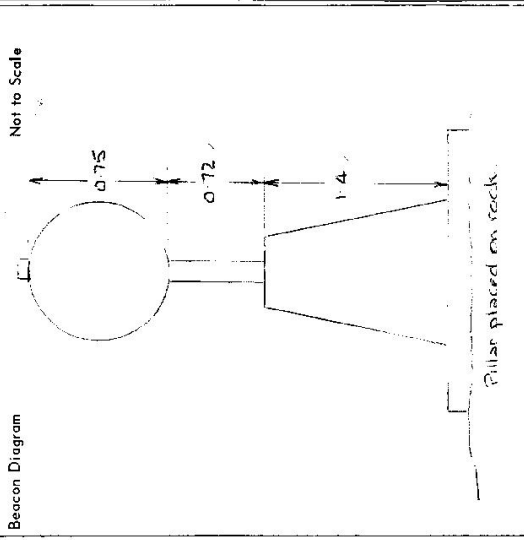

Beacon Diagram  
 Not to Scale  
 Pillar placed on rock

Date	Record of Station
20-2-80	Pillar Erected

1. Completely cleared to permit 360° vision to surrounding Trigs. ✓
2. Cleared by ~~James bearing~~ from Trig. Mast
3. Trig. Mast & Vanes have been painted white & black respectively. ✓
4. The Trig. was unpiled/~~not unpiled~~, dimensions now being: Trig. plug fd: Concrete Pillar should be explicit, e.g. Steel plug, Brass plug, Bolt, Concrete Pillar  
 Description of mark: Concrete Pillar <sup>above</sup> 1.4 m <sup>below</sup> rock, concrete G.L.  
 Height of mark: 1.4 m <sup>above</sup> rock, concrete G.L.  
 Height of Top Vanes to Top Work/Top pillar plate: 1.47 m Diameter of Vanes (vertical): 0.75 m.  
 Height of Cairn:   m. Diameter of Cairn:   m.  
 Length of Mast:   m. (approximate if not unpiled)
5. A Trig. plug set in ~~conc~~/rock has been placed/fd 6.728 m. bearing 336 °M from Trig. Mast/pillar
6. A G.S.P.P. set in conc/~~soil~~ has been placed/fd 4.38 m. bearing 110 1/2 °M from Trig. Mast/pillar
7. A   set in conc/~~soil~~ has been placed/fd   m. bearing   °M from Trig. Mast/pillar
8. A   set in conc/~~rock~~ has been placed/fd   m. bearing   °M from Trig. Mast/pillar
9. Connection: Trig. plug to G.S.P.P.: 10.754 m. bearing 137 °M
10. Connection:   to  :   m. bearing   °M
11. Connection:   to  :   m. bearing   °M
12. Connection:   to  :   m. bearing   °M
13. Diff. Ht. Trig. plug is 0.634 m. <sup>below</sup> Pillar plate.
14. Diff. Ht. G.S.P.P. is 1.861 m. <sup>above</sup> Pillar plate.
15. Diff. Ht.   is   m. <sup>above</sup>
16. Diff. Ht.   is   m. <sup>below</sup>


Prepared by: H. J. Green Checked: CG

STATION TS 3857 MERISYDINE (CP) TS 6100

Owners Name: C. ROBERTS  
 Address: On T.R. 188327  
 Current Occupant:  
 Address:

Access 20-2-1980

See Trig Card for Access.

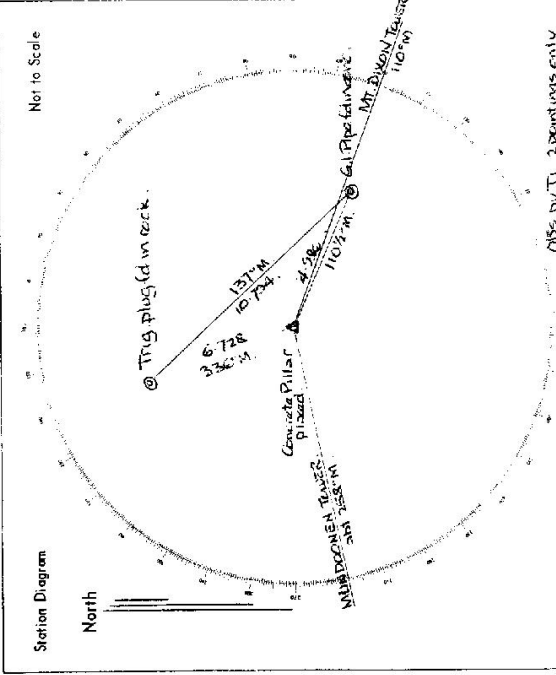

List of Observed Directions:-

Standpoint: Concrete Pillar		Standpoint:	
Station	Direction	Station	Direction
MOUNTAIN TRAIL	333° 55' 60"		
CONCRETE PILLAR	0° 25' 20"		
MOUNTAIN TRAIL	145° 14' 10"		
TRIG. PLUG	226° 45' 50"		
Station	Direction	Station	Direction



6: 2723-2 D. West, Government Printer

STATION *Merryvale (G.P.) TS 6700*


Owner's Name: *Mr Eric Roche*  
 Address: *24270N*  
 Phone: *85 5159*

Current Occupant: *UNOCCUPIED*  
 Address: .....  
 Phone: .....

**ACCESS**

Access Report of 11/11/1981 was found suitable/unsuitable.

*141N 000 OFFICE BUILDING KEVIN THOMAS YAU.*  
*010 TURN LEFT SIGN BERANDEJAN, CAMBERA & BUNDARAO*  
*016 TURN RIGHT SIGN BERANDEJAN & LADEVALE*  
*035 TURN RIGHT THROUGH LOCKED IRON GATE SIGN 'CAMPUS'*  
*BY THE LOCK ON WEST CORNER POST ON LEFT*  
*1130 TURN RIGHT THROUGH IRON GATE - HOUSE ON LEFT OF GATE*  
*1140 TURN LEFT ALONG SHEARING STREET*  
*1150 TAKE IRONEN GATE ON LEFT*  
*1160 TRACK TURNS LEFT UP RIDGE*  
*1180 TURN LEFT AROUND TOP OF RIDGE*  
*1225 FOLLOW TRACK OVER CREST OF RIDGE*  
*1250 GATEWAY - FOLLOW TRACK TO LEFT*  
*1300 TURN RIGHT UP RIDGE TO TRIG*  
*1310 GEODETIC STATION MERRYVALE*

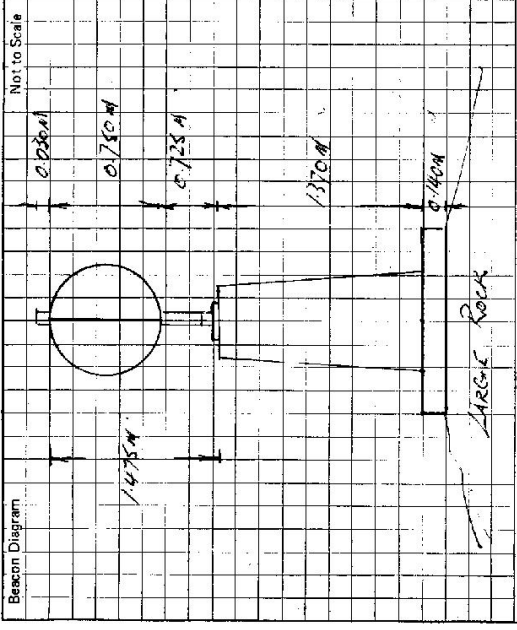

This section to be completed by officer constructing pillar.

Original station mark found/~~not found~~.

Description of mark: *BRASS TRIG ROCK*

Original beacon found/not found.

Description of beacon: .....

Height Top of Vanes to Top Mark: .....m.

Height of mark: .....m. above G.L.  
 below

Diameter of Vanes .....m. Height of Cairn .....m.

Original Beacon has/has not been destroyed by me.

Date	Record of Station



**LAND INFORMATION CENTRE**

GEODETIC SURVEY OF N.S.W.

**GEODETIC STATION RECONNAISSANCE and MAINTENANCE REPORT**

STATION: **MERRYONG** No.: **G700**


MAP SHEET **SCALE 1:50000**

INSPECTED BY: **J. Judge** DATE: **1984**

AUTHORITY: **CMA** FIELD BOOK:

Description: *Note: Cross out word or words which do not apply*

1. Cleared by vanes bearing..... from Trig, Mast
2. Mast & Vanes have been painted white & black respectively.
3. The station/pillar was unpiled/not unpiled/constructed on.....19....., dimensions now being:
  - Description of mark..... should be explicit, e.g., S/Steel Pillar Plate, Steel plug, Brass plug, Bolt, G.I. Pipe
  - Height of mark.....<sup>above</sup> m. <sup>below</sup> rock/concrete; Mark is.....<sup>above</sup> m. <sup>below</sup> G.L.
  - Height of Top Vanes to Top Mark/Pillar plate .....m. Diameter of Vanes (vertical).....m.
  - Height of Cairn.....m. Diameter of Cairn.....m. Name Plate found/not found/placed.
  - Length of Mast .....m. (approximate if not unpiled)
4. A..... set in conc./rock has been placed/found, bearing.....° M from Mast/Plug/Pillar
5. A..... set in conc./rock has been placed/found, bearing.....° M from Mast/Plug/Pillar
6. A..... set in conc./rock has been placed/found, bearing.....° M from Mast/Plug/Pillar
7. A..... set in conc./rock has been placed/found, bearing.....° M from Mast/Plug/Pillar
8. Action required:.....

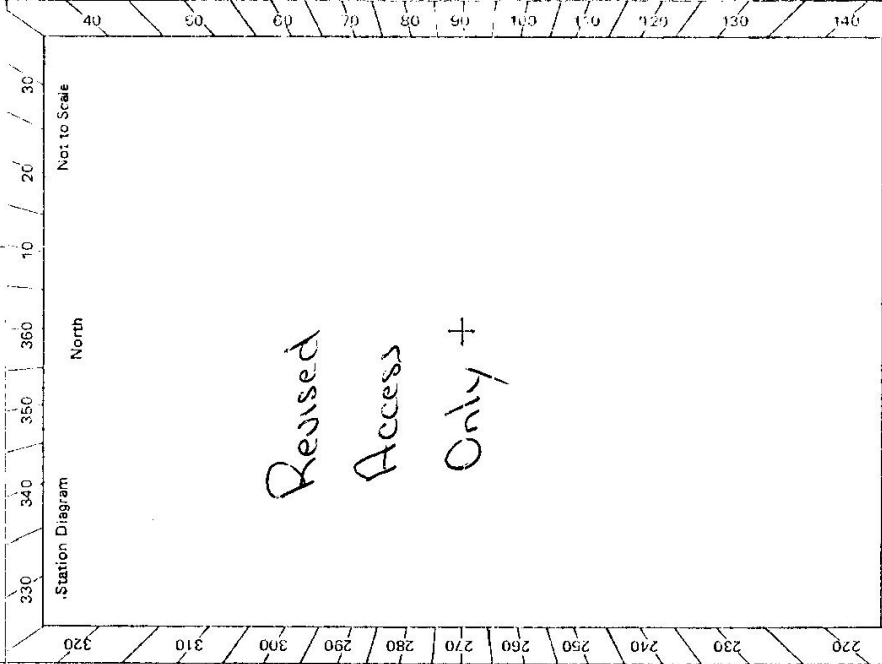

STANDPOINT:				STANDPOINT:			
Mark	Direction	Horiz. Distance	Height Difference	Mark	Direction	Horiz. Distance	Height Difference
			above standpt.				above standpt.
			below				below
			above standpt.				above standpt.
			below				below
Prepared by: *Judge*

Checked: 1990

Noted on U.T.M. Card

Checked

