


CENTRAL MAPPING AUTHORITY  
GEODETTIC SURVEY OF N.S.W.

GEODETTIC STATION RECONNAISSANCE and MAINTENANCE REPORT

STATION: *Bundella* No.: *6703*  
MAP SHEET No.: *1470*  
SCALE 1:250 000

INSPECTED BY: *P.K. Bamala* DATE: *Feb. 79*

AUTHORITY: *CMA* FIELD BOOK:

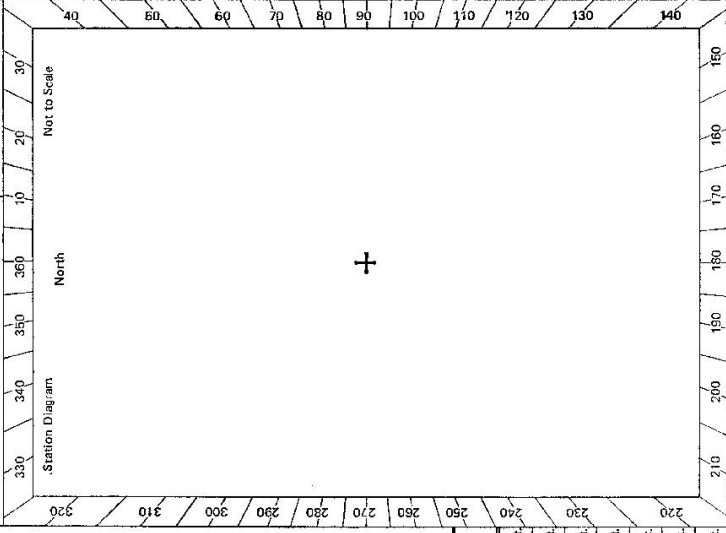

- Description:
- Cleared by lanes bearing. *Note: Cross out word or words which do not apply*
  - Mast & Vanes have been ~~white & black respectively~~ *found in cairn of rocks.*
  - The station ~~marker~~ *was unpiled/not unpiled/constructed on* ~~10~~ *19* ~~dimensions now being~~
- Description of mark.....should be explicit, e.g., S/Steel Pillar Plate, Steel plug, Brass plug, Bolt, G.I. Pipe
- Height of mark.....m. <sup>above</sup> ~~rock/concrete~~ <sub>below</sub> G.L.
- Height of Top Vanes to Top Mark/Pillar plate .....m. Diameter of Vanes (vertical).....m.
- Height of Cairn.....m. Diameter of Cairn.....m. Name Plate found/not found/placed.
- Length of Mast.....m. (approximate if not unpiled)
- A.....set in conc/rock has been placed/found, bearing.....°M from Mast/Plug/Pillar
  - A.....set in conc/rock has been placed/found, bearing.....°M from Mast/Plug/Pillar
  - A.....set in conc/rock has been placed/found, bearing.....°M from Mast/Plug/Pillar
  - A.....set in conc/rock has been placed/found, bearing.....°M from Mast/Plug/Pillar

Action required: *Beacon needs to be painted. Light timber required.*

STANDPOINT:


Mark	Direction	Horiz. Distance	Height Difference	Mark	Direction	Horiz. Distance	Height Difference
			above standpt.				above standpt.
			below				below
			above standpt.				above standpt.
			below				below
Prepared by: *P.K. Bamala* Checked: *KA* Noted on U.T.M. Card

S: 2733-1

Checked

GS 24

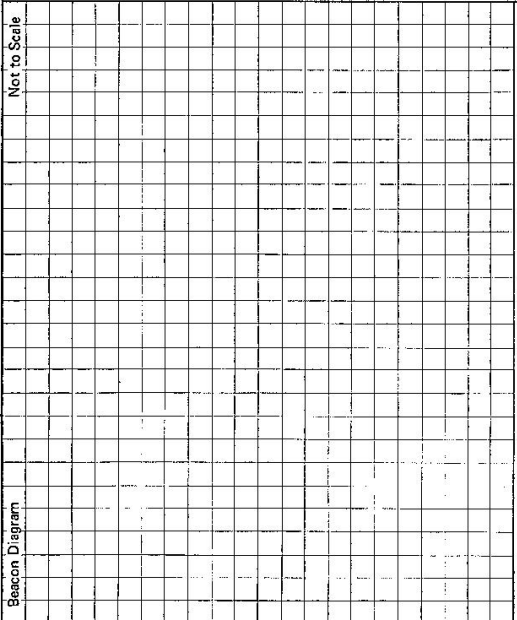STATION <i>Bundella</i>	6703	Owner's Name: ..... Address: ..... Phone: ..... Current Occupant: ..... Address: ..... Phone: ..... Access Report of <sup>26</sup> ...../1973 was found suitable/unsuitable. ACCESS <i>Refer Blackville 8934-11-5.</i> <i>A wheel drive vehicle may be driven to within a 100m of the station.</i>
Beacon Diagram 	This section to be completed by officer constructing pillar. Original station mark found/not found. Description of mark: ..... Original beacon found/not found. Description of beacon: ..... Height Top of Vanes to Top Mark.....m. Height of mark.....m. above G.L. below Diameter of Vanes.....m. Height of Cairn.....m. Original Beacon has/has not been destroyed by me.	
		Date Record of Station



GS 24

STATION **BUNDELLA (P) 6703**

Owner's Name: **TRIG RESERVE N°4808C**  
 Address: **(NOT LEASED)**  
 Phone: .....  
 Current Occupant: .....  
 Address: .....  
 Phone: .....

**ACCESS**


Access Report of 8/10/1982 was found suitable/unavailable.

- 0.0 COOLAH VALLEY HOTEL TRAVEL EAST
- 1.72 TURN LEFT SIGNPOST PANDORA PASS 32
- 20.2A TURN RIGHT SIGNPOST STATE FOREST 11
- 31.01 GRID & ENTRANCE WARNING & BUNDELLA STATE FORESTS
- 34.08 PASS ROAD R.H.S. (NORFOLK CA. FALLS ACCESS)
- 34.56 GRID
- 41.38 GRID
- 44.47 TAKE LEFT FORK AT BLAZED TREE
- 44.49 TURN LEFT FAINT TRACK AT BLAZED TREE FOLLOW TRACK
- 46.09 PASS TRACK ON LEFT
- 46.09 BUNDELLAS.

**Record of Station**

Date

Sr 2733-2 D. West, Government Printer

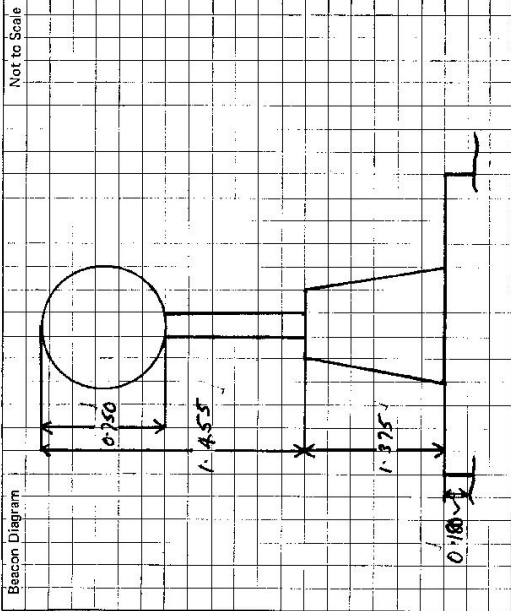

This section to be completed by officer constructing pillar.

Original station mark found/~~not found~~.

Description of mark: **BRASS TRIG PLUG**

Original beacon found/~~not found~~.

Description of beacon: **CAIRN MAST & VANES**

Height Top of Vanes to Top Mark **4.290** m.

Height of mark **0.20** m. above G.L. below

Diameter of Vanes **1.000** m. Height of Cairn **1.840** m.

Original Beacon has/~~has not~~ been destroyed by me.