

GEODETTIC SURVEY OF N.S.W.

CENTRAL MAPPING AUTHORITY

GEODETTIC STATION RECONNAISSANCE and MAINTENANCE REPORT

Description:

1. Cleared by limes bearing 360° Note: *Cross out word or words which do not apply* from Trig, Mast
2. Mast & Vanes have been painted white & black respectively.
3. The station/pillar was unpiled/not unpiled/reassembled on 19 dimensions new being:

Description of mark should be explicit, e.g., S/Steel Pillar Plate, Steel plug, Brass plug, Bolt, G.I. Pipe

Height of mark m. ^{above} rock/concrete; Mark is m. ^{above} G.L.

Height of Top Vanes to Top Mark/Pillar plate m. Diameter of Vanes (vertical) m.

Height of Cairn m. Diameter of Cairn m. Name Plate found/not found/placed.

Length of Mast m. (approximate if not unpiled)

4. A SSM set in conc/reek has been placed/found, bearing M from Mast/Plug/Pillar

5. A ASTRO PILLAR set in conc/rock has been placed/found, bearing M from Mast/Plug/Pillar

6. A set in conc/rock has been placed/found, bearing M from Mast/Plug/Pillar

7. A set in conc/rock has been placed/found, bearing M from Mast/Plug/Pillar

8. Action required: CONCRETE OBSERVATION PILLAR TO BE ESTABLISHED

STANDPOINT:

Mark	Direction	Horiz. Distance	Height Difference	Mark	Direction	Horiz. Distance	Height Difference
			above standpt.				above standpt.
			below				below
			above standpt.				above standpt.
			below				below
Prepared by: P. CARR 9-4-81


Checked:

Checked: *[Signature]*

Noted on U.T.M. Card

STATION: COBAR
MAP SHEET SCALE 1:250 000
INSPECTED BY: P. CARR
AUTHORITY: C.M.A.

TS-6705 No.: 1806
DATE: 6-3-81
FIELD BOOK: C 77

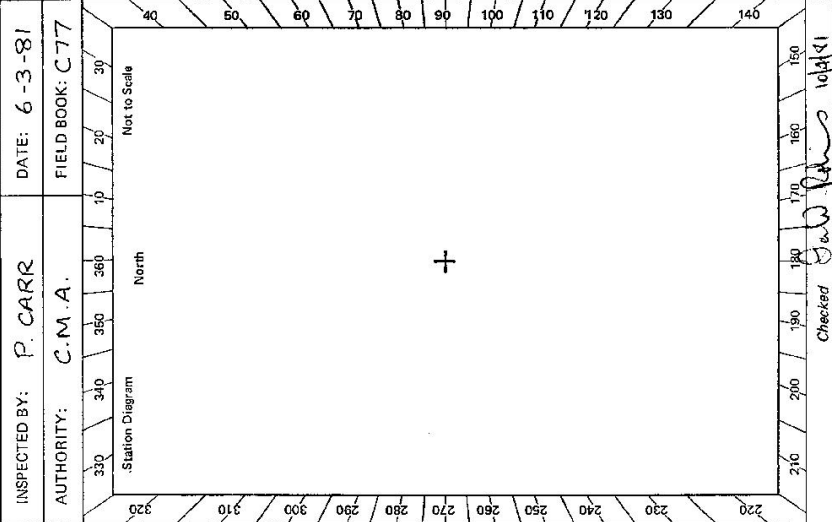

Checked: *[Signature]*

5: 2733-1

STATION **COBAR TS 6705**

Owner's Name:
 Address:
 Phone:
 Current Occupant:
 Address:
 Phone:


ACCESS

Access Report of 6.12.1981 was found suitable/unsuitable.

Km

- 0.0 COBAR P.O. HEAD NORTH.
- 0.2 TURN RIGHT AT HIGHWAY
- 0.9 TURN RIGHT TOWARDS CONDOBLIN.
- 2.0 PAST GRAVEL ROAD TO LEFT.
- 3.0 PAST PINK DUMP ON RIGHT
- 7.9 TURN RIGHT OFF ROAD ONTO FAINT TRACK,
- 8.9 THROUGH OPENING IN FENCE LINE/WIRE GATE AND FOLLOW TRACK AT TRIG.

POSSIBLE TO DRIVE TO TRIG IN STATION SEDAN / WAGON IN DRY WEATHER
 (ie 95% of the time)

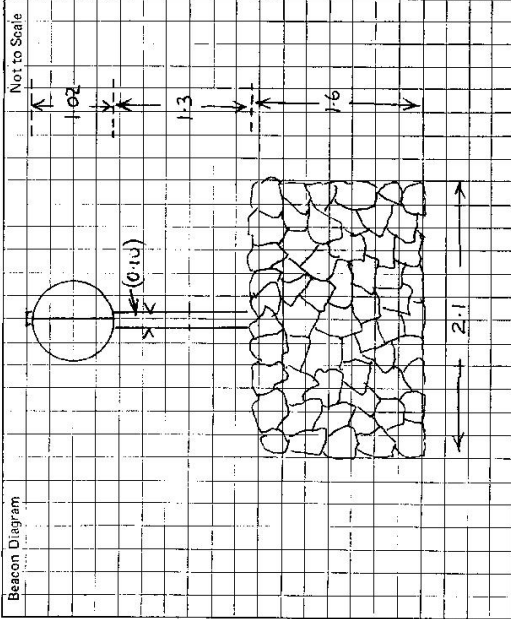

This section to be completed by officer constructing pillar.

Original station mark found/not found.

Description of mark:

Original beacon found/not found.

Description of Beacon:

Height Top of Vanes to Top Markm.

Height of mark.....m. above rock/conc.....m. below G.L.

Diameter of Vanesm.

Height of Cairnm.

Original Beacon has/has not been destroyed by me.

Date	Record of Station

CENTRAL MAPPING AUTHORITY

GEODETIC SURVEY OF M.S.W.

BAWA FA


GEODETIC STATION RECONNAISSANCE and MAINTENANCE REPORT

STATION: COBAR CS (P) No: 6705

MAP SHEET SCALE 1:250 000 COBAR

INSPECTED BY: L. HITCHINS DATE: 8.5.81

AUTHORITY: C.M.A. FIELD BOOK: 1870

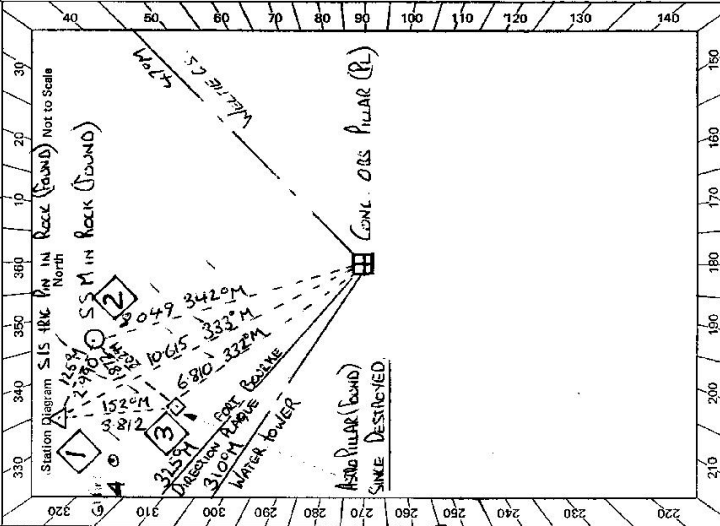

- Description: 36.0° Note: Cross out word or words which do not apply
1. Cleared by lanes bearing 36.0° from Trig. Mast
 2. Mast & Vanes have been painted white & black respectively. ✓
 3. The station/pillar was ~~unplaced~~ constructed on 7.5 19.81 dimensions now being:
 - Description of mark: S15 IRIC PIN should be explicit, e.g., S/Steel Pillar Plate, Steel plug, Brass plug, Bolt, G.I. Pipe
 - Height of mark: 1.375 above 1.475 m. above G.L. ✓
 - Height of Top Vanes to Top Mast/Pillar plate: 1.423 m. Diameter of Vanes (vertical): 0.744 m.
 - Height of Cairn: 0 m. Diameter of Cairn: 0 m. Name Plate found/not found/placed.
 - Length of Mast: 0 m. (approximate if not unplaced)
 4. A S15 IRIC PIN set in ~~stone~~ rock has been placed/destroyed, bearing 333.0° M from Mast/Plug/Pillar
 5. A S.S.M. set in ~~stone~~ rock has been placed/destroyed, bearing 342.0° M from Mast/Plug/Pillar
 6. AN ASTRO PILLAR set in ~~stone~~ conc/rock has been placed/destroyed, bearing 332.0° M from Mast/Plug/Pillar (since destroyed)
 7. A WATER TOWER set in ~~stone~~ conc/rock has been placed/destroyed, bearing 000.0° M from Mast/Plug/Pillar
 8. Action required: None

STANDPOINT: S/S PILLAR PLATE			STANDPOINT: ASTRO PILLAR (since destroyed)		
Mark	Direction	Horiz. Distance	Mark	Direction	Horiz. Distance
WATER TOWER	0 00 00	/	WATER TOWER	0 00 00	above standpt.
DIRECTION P AT F BUSH	15 22 00	/	DIRECTION P AT F BUSH	15 22 20	below standpt.
ASTRO PILLAR	21 39 56	6809	S15 IRIC PIN	25 24 30	above standpt.
S15 IRIC PIN	23 00 10	10615	S.S.M.	75 52 35	below standpt.
S.S.M.	32 32 05	18049	WELTIE CS	97 39 10	above standpt.
WELTIE CS	97 35 55	1568	S/S PILLAR PLATE	101 40 40	below standpt.
					0389

Prepared by: J. Bill Checked: CL Noted on U.T.M. Card

GS 24


STATION **COBAR GS (P) TS 6705**

Current Occupant:
 Address:
 Phone:

Owner's Name: **T.R. 43135**
 Address: **WESTERN LANDS COMMISSION**
 Phone:

ACCESS

Access Report of **6/3/1981** was found suitable/~~unsuitable~~.
COBAR P.O. HEAD NORTH.
TURN RIGHT AT HIGHWAY
TURN RIGHT TOWARDS CONDOBOLIN
PASS GRAVEL ROAD ON LEFT
PASS PINK DUMP ON RIGHT
TURN RIGHT OFF ROAD ONTO FAINT TRACK [ARROW ON ROAD]
THROUGH IRON GATE. C.M.A LOCK PLACED. FOLLOW TRACK.
COBAR GS (P)
2WD IN DRY CONDITIONS

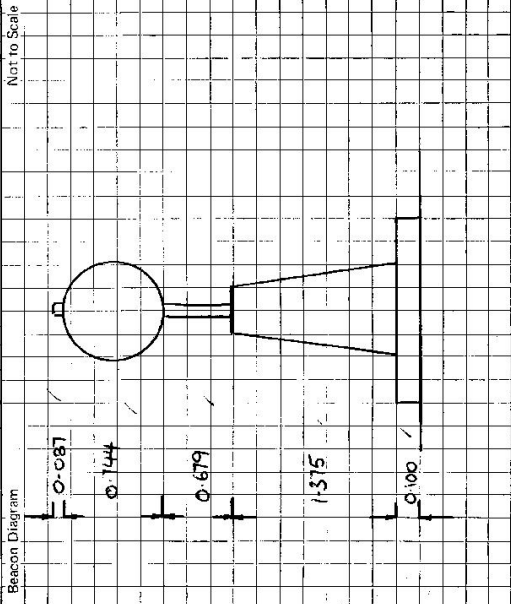

This section to be completed by officer constructing pillar.

Original station mark found/~~not found~~.

Description of mark: ~~SILVER~~ **TRAC. PIN** ✓

Original beacon found/~~not found~~.

Description of beacon: **CAIRN. POLE + DISCS**

Height Top of Vanes to Top Mark: **3.667** m. ✓

Height of mark: **0.683** m. ^{above} rock/~~above~~ **AI** m. ^{above} G.L. / _{below}

Diameter of Vanes: **1.010** m. ✓ Height of Cairn: **1.460** m.

Original Beacon has ~~not~~ been destroyed by me.

Date

Record of Station

CENTRAL MAPPING AUTHORITY

GEODETIC SURVEY OF M.S.W.

GEODETIC STATION RECONNAISSANCE and MAINTENANCE REPORT

Description:

1. Cleared by Janes bearing..... Note: Cross out word or words which do not apply from Trig. Mast
2. Mast & Vanes have been painted white & black respectively.
3. The station/pillar was unpiled/not unpiled/constructed on.....19....., dimensions now being:

Description of mark..... should be explicit, e.g., S/Steel Pillar Plate, Steel plug, Brass plug, Bolt, G.I. Pipe

Height of mark.....m. ^{above}/_{below} rock/concrete; Mark is.....m. ^{above}/_{below} G.L.

Height of Top Vanes to Top Mark/Pillar plate.....m. Diameter of Vanes (vertical).....m.

Height of Cairn.....m. Diameter of Cairn.....m. Name Plate found/not found/placed.

Length of Mast.....m. (approximate if not unpiled)

4. A.....set in conc/rock has been placed/found, bearing.....° M from Mast/Plug/Pillar

5. A.....set in conc/rock has been placed/found, bearing.....° M from Mast/Plug/Pillar

6. A.....set in conc/rock has been placed/found, bearing.....° M from Mast/Plug/Pillar

7. A.....set in conc/rock has been placed/found, bearing.....° M from Mast/Plug/Pillar

8. Action required:.....

STANDPOINT: SIS TRIG PIN.

Mark	Direction	Horiz. Distance	Height Difference	Mark	Direction	Horiz. Distance	Height Difference
WATER TOWER	0 00 00	/	above standpt.				above standpt.
DIRECTION P. AT FT BOUQUE	15 22 20	/	above standpt.				above standpt.
WELTIE GS	97 40 50	/	above standpt.				above standpt.
S.S.M.	176 34 45	2.990	0.004				above standpt.
SIS PILLAR PLATE	203 01 55	10.616	1.573				above standpt.
ASTRO PILLAR	205 26 25	13.813	1.185				above standpt.

Prepared by: J.C. [Signature]

Checked: C.R. Parks 3rd June 81. Noted on U.T.M. Card

Sr 2753-1

STATION: COBSAR GS (P) No.: 6705

MAP SHEET SCALE 1:250 000

INSPECTED BY: DATE:

AUTHORITY: FIELD BOOK: