

CENTRAL MAPPING AUTHORITY

GEODETIC STATION RECONNAISSANCE and MAINTENANCE REPORT


GEODETIC SURVEY OF A.S.M.K

STATION: ~~SAFE B~~ **CANNA** No.: **6107**

MAP SHEET SCALE 1:250 000 **GILGANJARA**

INSPECTED BY: **J. FANNING** DATE: **15.8.80**

AUTHORITY: **C.M.A. (M.V. 22V)** FIELD BOOK: **1837**

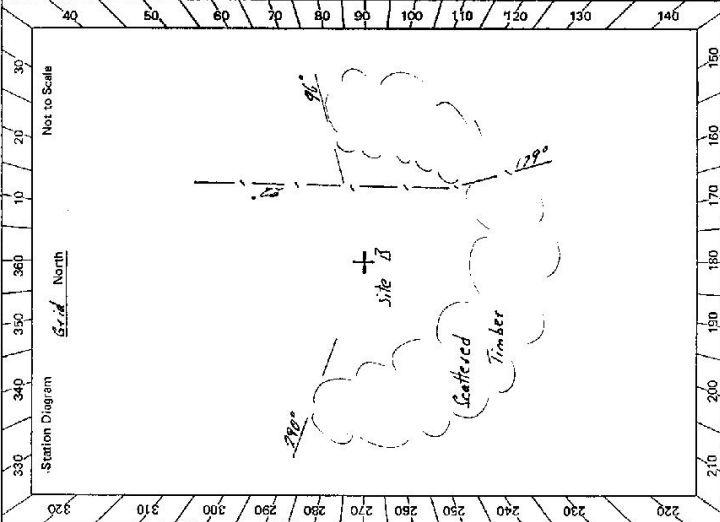

- Description: **290° → 96°**
 Note: Cross out word or words which do not apply
- Cleared by lanes bearing **290°** from Trig. Mast
 - Mast & Vanes have been painted white & black respectively.
 - The station/pillar was unpiled/not unpiled/constructed on **19** dimensions now being:
 - Description of mark: should be explicit, e.g., S/Steel Pillar Plate, Steel plug, Brass plug, Bolt, G.I. Pipe
 - Height of mark: **above** rock/concrete; Mark is **above** **below** G.L.
 - Height of Top Vanes to Top Mark/Pillar plate: **above** **below** Diameter of Vanes (vertical) **above** **below** m.
 - Height of Cairn: **above** **below** m. Diameter of Cairn **above** **below** m. Name Plate found/not found/placed.
 - Length of Mast **above** **below** m. (approximate if not unpiled)
 - A **above** **below** set in conc/rock has been placed/found, bearing **above** **below** °M from Mast/Plug/Pillar
 - A **above** **below** set in conc/rock has been placed/found, bearing **above** **below** °M from Mast/Plug/Pillar
 - A **above** **below** set in conc/rock has been placed/found, bearing **above** **below** °M from Mast/Plug/Pillar
 - A **above** **below** set in conc/rock has been placed/found, bearing **above** **below** °M from Mast/Plug/Pillar
 - Action required: **Place conc. pillar. 1 day clearing.**
2 witness marks

STANDPOINT:

Mark	Grid Direction	Horiz. Distance	Height Difference	Mark	Grid Direction	Horiz. Distance	Height Difference
Cranbourne	108°	23.4	Hill above standpt.	SCOTTAL	103°	27	M.V. above standpt.
East Bluff	92°	15.4	Hill above standpt.	Daley	304°	18	Hill above standpt.
Howard	115°	33	M.V. above standpt.	LEWIS	311°	13	Hill above standpt.
Watt	152°	40	M.V. above standpt.	BERGENDRAT	198	12	Hill above standpt.
Torill	224°	26	M.V. above standpt.	BALLLEPPA	152	21	Hill above standpt.
Collier	248°	35 (6)	profite above standpt.	REMANAGED	266°	10	Hill above standpt.
Boyamorna	273°	27	M.V. above standpt.	Black firm Bundle No. Bove	280°	15	Hill above standpt.

Prepared by: **J. FANNING**

Checked: **WJ 19/8**

Noted on U.T.M. Card

Checked: **WJ 19/8**

GS 24

STATION SAFE B CUNNA IS 6707

Owner's Name: T.M. BAILLIE
 Address: Tombey Street
 Phone: (083) 750 448
 Current Occupant:
 Address:
 Phone:

ACCESS

Access Report of 15.8.1980 was found suitable/unsuitable.

0.0 P.O. Cassilis travel towards Coolah one street and turn right
 Signpost Cooba Bulba
 3.8 6.1 Grid Willow Downs 12 km
 6.4 Torn left Signpost "Willow Downs 12 km"
 7.6 10.2 10.7 13.4 15.2 17.4 18.7 19.3 20.9 Grid
 21.3 Torn right through double iron gate
 21.8 22.0 22.7D 23.31 Iron gate follow track
 23.8 Take left fork 24.55 Iron gate in saddle head North East
 2.4 Wood gate at yards, travel directly north to gate in fence on R.H.S.
 25.7 Iron gate make way up ridge to hill top (surrounded by fallen timber)
 26.8 Site B

Owners Property -

On Coolah to Cassilis road
 0.0 Turce Creek 15 km from Coolah travel east
 0.1 Turn south
 12.9 Tongy Station on rise on R.H.S.

Beacon Diagram	Alternative Access	Not to Scale
0.0	P.O. Cassilis travel towards Coolah / black turn right	
6.4	Turn left	
7.6	10.2 10.7 13.4 15.2 17.4 18.7 19.3 20.9 } Grid	
21.3	Turn right	
21.8	22.0 22.7D 23.31 Iron gate	
23.8	Take left fork	
25.7	Wood gate	
26.8	Site B	

This section to be completed by officer constructing pillar.

Original station mark found/not found.

Description of mark:

Original beacon found/not found.

Description of beacon:

Height Top of Vanes to Top Mark m.

Height of mark m above / below G.L.

Diameter of Vanes m. Height of Cairn m.

Original Beacon has/has not been destroyed by me.

Date	Record of Station
26th Aug 80	Initial permission given to erect concrete pillar & do any clearing necessary

CENTRAL MAPPING AUTHORITY

GEODETIC SURVEY OF NSW

GEODETIC STATION RECONNAISSANCE and MAINTENANCE REPORT

STATION: **CUNNA (P)** No.: **6707**

MAP SHEET
SCALE 1:250 000
TAMWORTH

INSPECTED BY: **G. L. FORD** DATE: **9-5-81**

AUTHORITY: **C. M. A** FIELD BOOK: **01910**

Description: *Note: Cross out word or words which do not apply*

1. Cleared by lanes bearing $330-345$, $355-0$, $15-21$, $40-48$, $64-90$ from Trig. Mast
 $119-145$, $250-266$, $280-300$

2. Mast & Vanes have been painted white & black respectively.

3. The station/pillar was ~~constructed~~ constructed on $7-5$, $19-81$, dimensions now being:

Description of mark: **S/S PILLAR PLATE** should be explicit, e.g., S/Steel Pillar Plate, ~~Steel plate, Brass plug, Bolt, G.I. Pipe~~

Height of mark: 1.580 m. ^{above rock/concrete;} ~~above G.L.~~ Mark is 1.580 m. ^{above} G.L.

Height of Top Vanes to Top ~~Mark~~ Pillar plate 1.440 m. Diameter of Vanes (vertical): 0.250 m.

Height of Cairn: m. Diameter of Cairn: m. Name Plate found/not found/placed.

Length of Mast: m. (approximate if not unplied)

4. A. **COPPER NAIL** set in conc/rock has been placed/ ~~found~~, bearing 126 °, 126 ° M from ~~Mast/Plug/Pillar~~

5. A. **G.I. PIPE** set in conc/rock has been placed/ ~~found~~, bearing 327 °, 327 ° M from ~~Mast/Plug/Pillar~~

6. A. set in conc/rock has been placed/ ~~found~~, bearing:° M from Mast/Plug/Pillar

7. A. set in conc/rock has been placed/ ~~found~~, bearing:° M from Mast/Plug/Pillar

8. Action required:

.....

.....


.....

.....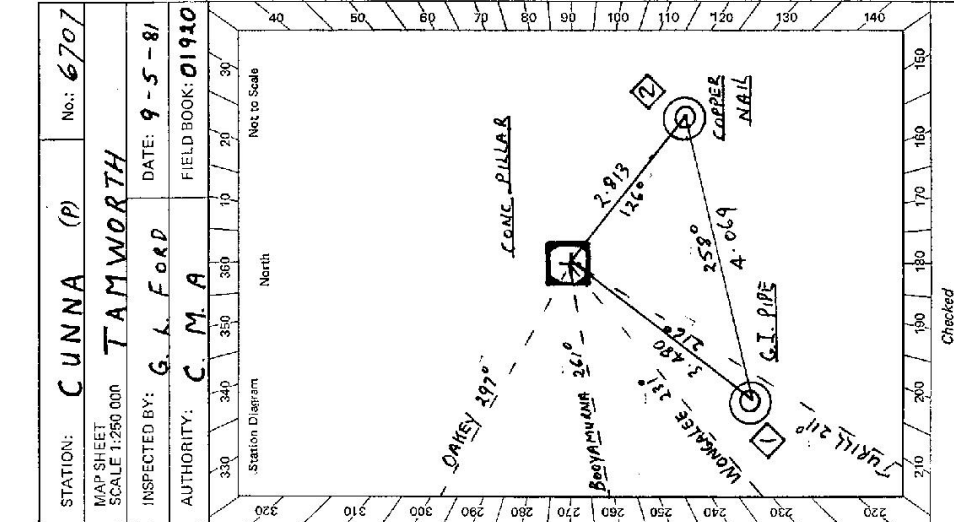

STANDPOINT: CONC PILLAR		STANDPOINT: COPPER NAIL	
Mark	Direction	Mark	Direction
Oakey	0 00 00	Oakey	0 00 00
Copper Nail	204 43 45	Conc Pillar	24 43 20
Turill	280 03 45	Turill	280 04 00
G.I. Pipe	284 33 55	Wongalee	299 03 30
Wongalee	299 02 55	G.I. Pipe	327 33 40
Booyamurna	328 03 35	Booyamurna	328 03 40

Prepared by: **G. L. Ford** Checked: **M. Wood** 31/7/81. *Noted on U.T.M. Card*

ST 2733-1

GS 24

STATION CUNNA (P) ^{TS} 6707	Owner's Name: TIM BAILLIEU Address: TONGY STATION Phone: (083) 250 468 Current Occupant: Address: Phone:
Beacon Diagram Not to Scale 	Access Report of 9.15.19 was found suitable/unsuitable. ACCESS 0-00 CASSIUS P.O. HEAD TOWARDS COOLAH 0-10 TURN RIGHT (100 METRES FROM P.O.) 6-8 GRID GRAVEL ROAD 8-4 GRID 8-8 TURN LEFT "CATTLE CK. ROAD" CROSS 9 GRIDS 22-5 GRID (GOONDEE ON GATE) 22-9 GATE PASS HOUSE ON YOUR LEFT AND CROSS CREEK 23-15 TURN LEFT UP HILL JUST BEFORE SHEARING SHED 23-35 GATE FOLLOW TRACK UP HILL 24-6 GATE 25-5 GATE 26-2 TAKE LEFT TRACK 26-8 GATE THROUGH GATE AND LEFT FOLLOWING FENCE LINE OF HILL 27-1 CUNNA G.S. OWNERS PROPERTY ON COOLAH TO CASSIUS ROAD 0-0 THREE CREEK 15km FROM COOLAH TRAVEL EAST 0-1 TURN SOUTH 12-9 TONGY STATION ON RISE ON R.H.S.
This section to be completed by officer constructing pillar: Original station mark found/not found: Description of mark: NEW STATION Original beacon found/not found: Description of beacon: Height Top of Vanes to Top Markm. Height of mark.....m. above G.L. below Diameter of Vanesm. Height of Cairnm. Original Beacon has/has not been destroyed by me.	Date Record of Station