

GEODETIC SURVEY OF NS&K

CENTRAL MAPPING AUTHORITY

GEODETIC STATION RECONNAISSANCE and MAINTENANCE REPORT

Description:

1. Cleared by lanes bearing  $141^{\circ} 19' 00''$  and  $135^{\circ} 23' 00''$  from Trig. Mast

2. Mast & Vanes have been painted white & black respectively.

3. The station/pillar was unplaced/unpiled/constructed on  $19.81$  m, dimensions now being:

Description of mark:  $1.19$  m.  $1.35$  m.  $2.53$  m.  $1.10$  m. from Trig. Mast

Height of mark:  $1.360$  m.  $1.462$  m.  $1.462$  m.  $1.462$  m. above below

Height of Top Vanes to Top Mark/Pillar plate  $1.435$  m. Diameter of Vanes (vertical)  $0.755$  m.

Height of Cairn  $1.515$  m. Diameter of Cairn  $0.15$  m. Name Plate found/not found/placed.

Length of Mast  $1.515$  m. (approximate if not unpiled)

4. A  $1.19$  m.  $1.35$  m. set in conc/rock has been placed/found, bearing  $135^{\circ} 23' 00''$  M from Mast/Plug/Pillar

5. A  $1.35$  m. set in conc/rock has been placed/found, bearing  $83^{\circ} 00''$  M from Mast/Plug/Pillar

6. A  $1.462$  m. set in conc/rock has been placed/found, bearing  $139^{\circ} 00''$  M from Mast/Plug/Pillar


7. A  $1.462$  m. set in conc/rock has been placed/found, bearing  $139^{\circ} 00''$  M from Mast/Plug/Pillar

8. Action required:  $1.19$  m.  $1.35$  m.  $1.462$  m.  $1.462$  m.

STANDPOINT: PILLAR PLATE		STANDPOINT: PILLAR PLATE	
Mark	Direction	Horiz. Distance	Height Difference
MERLINA PILLAR	$354$ $54$ $60$		above standpt.
HOWARD PILLAR	$19$ $32$ $40$		above standpt.
CARRINGTON PILLAR	$61$ $35$ $40$		above standpt.
S.S.M	$231$ $26$ $35$	$2.861$	$1.497$ below standpt.
BRUCE PILE	$349$ $34$ $50$	$3.601$	$2.003$ below standpt.
G.I. PILE	$349$ $43$ $25$	$2.794$	$1.374$ below standpt.
CARRINGTON PILLAR	$317$ $03$ $25$	$119$ $17$	above standpt.

Prepared by: **DIAMOND (P)** Checked: **DIAMOND (P)** Noted on U.T.M. Grid

SI-2738-1

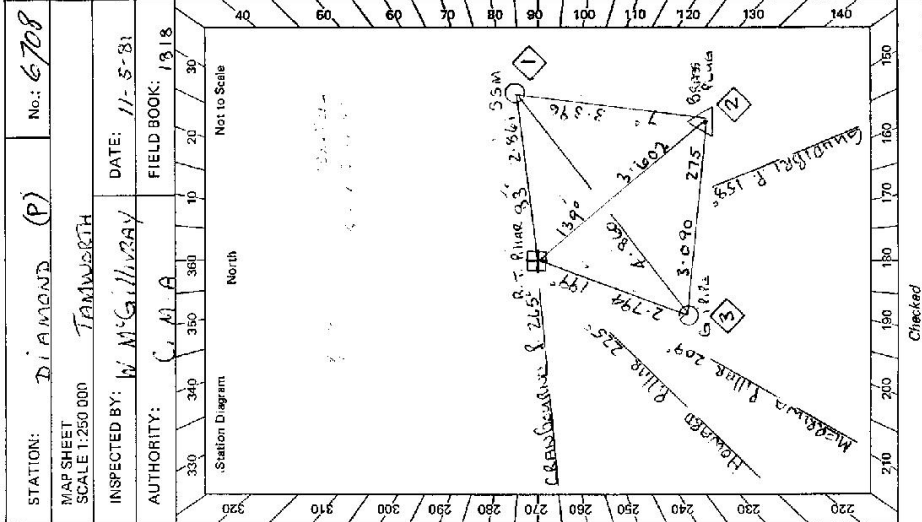

Checked

GS 24


STATION **DIAMOND R.T. PILLAR 6708**

ACCESSES THROUGH THE PROPERTY  
 Current Occupant: **ASST. COMMISSIONER ROBERT**  
 Address: **P.O. BOX 99, SIKHAKOTA**  
 Phone: **045 721498, 061474**

Owner's Name: **TR. S. S. SINGH, M. 225**  
 Address: **RAJAPUR, S. I. TORR, HALL**  
 Phone: **MARRIWARA 497710**

**ACCESS**

Access Report of **11/5/1981** was found suitable/unusable.  
 0.0 ROYAL HOTEL MERRIWAR TRAVEL NORTH.  
 0.54 TURN LEFT WILLOW TREE ROAD  
 1.74 TAKE ROAD TO RIGHT SIGN POST (DRALES CREEK)  
 27.80 CROSS TOP OF RIDGE  
 29.36 TURN RIGHT HOUSE ON LEFT,  
 29.56 TURN LEFT TUBE ON LEFT.  
 29.66 IRON GATE ON RIGHT, FOLLOW TRACK.  
 32.36 LEAVE VEHICLE AT TOP OF RIDGE, CROSS FENCE 10 MIN TO GS.

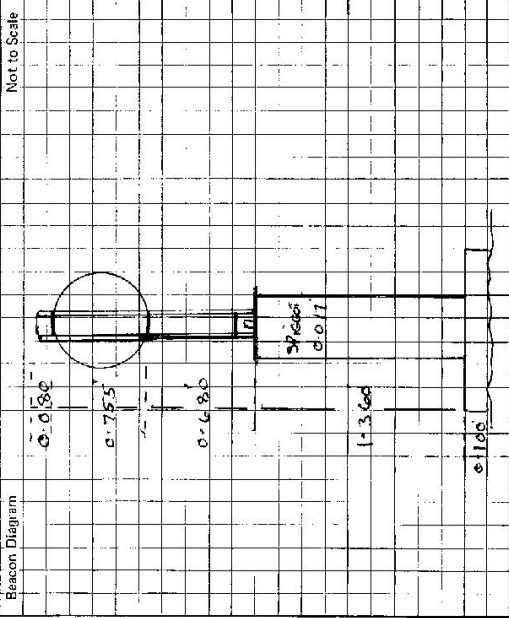

This section to be completed by officer constructing pillar.

Original station mark found/~~not found~~.

Description of mark: **IRON GATE ON RIGHT, FOLLOW TRACK**

Original beacon found/~~not found~~.

Description of beacon: **IRON GATE ON RIGHT, FOLLOW TRACK**

Height Top of Vanes to Top Mark: **0.680** m.

Height of mark: **0.680** m. ~~above~~ **below** G.L.

Diameter of Vanes: **0.755** m. Height of Cairn **0.755** m.

Original Beacon has/~~has not~~ been destroyed by me.

Date	Record of Station

GEODETTIC SURVEY OF M.S.M.

CENTRAL MAPPING AUTHORITY


GEODETTIC STATION RECONNAISSANCE and MAINTENANCE REPORT

STATION: **DIAMOND** No.: **6708**

MAP SHEET SCALE 1:250 000 **TAMWORTH**

INSPECTED BY: **D. KINNSIDE** DATE: **10.6.82**

AUTHORITY: **C.M.A.** FIELD BOOK:

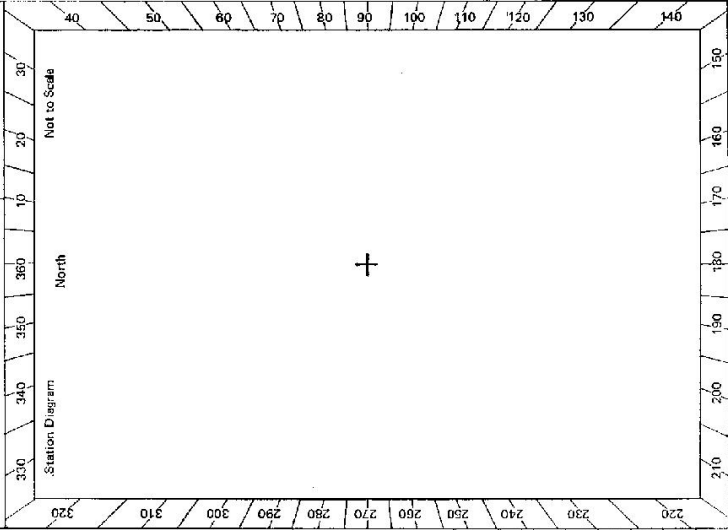

- Description:
- Note: Cross out word or words which do not apply*
1. Cleared by lanes bearing..... from Trig. Mast
  2. Mast & Vanes have been painted white & black respectively.
  3. The station/pillar was unpiled/not unpiled/constructed on....., dimensions now being: Description of mark..... should be explicit, e.g., S/Steel Pillar Plate, Steel plug, Brass plug, Bolt, G.I. Pipe
  - Height of mark.....<sup>above</sup> rock/concrete; Mark is.....<sup>above</sup> G.L.
  - Height of Top Vanes to Top Mark/Pillar plate .....m. Diameter of Vanes (vertical).....m.
  - Height of Cairn.....m. Diameter of Cairn.....m. Name Plate found/not found/placed.
  - Length of Mast .....m. (approximate if not applied)
  4. A.....<sup>set in conc/rock has been placed/found</sup> bearing.....° M from Mast/Plug/Pillar
  5. A.....<sup>set in conc/rock has been placed/found</sup> bearing.....° M from Mast/Plug/Pillar
  6. A.....<sup>set in conc/rock has been placed/found</sup> bearing.....° M from Mast/Plug/Pillar
  7. A.....<sup>set in conc/rock has been placed/found</sup> bearing.....° M from Mast/Plug/Pillar
  8. Action required:.....

**STANDPOINT:**

Mark	Direction	Horiz. Distance	Height Difference	Mark	Direction	Horiz. Distance	Height Difference
			above standpt				below standpt
			below				above
			above standpt				below standpt
			below				above

Prepared by: **C. Lewis** Checked: **AS 31/5/82** *Noted on U.T.M. Card*

STATION DIAMOND AT PILLAR TS 6708

Owner's Name: TRIC RESERVE A10235  
 Address: TARR HILL  
 Phone: MERRINA 48220  
 Access: ACCESS 10-6-1987

RECESS OWNER  
 Current Occupant: GORDON MARTIN  
 Address: P.O. BOX 99  
 Phone: 065 721448 (HOME)  
 721447 (OFFICE)

Access Report of 15/10/87 was found suitable/unsuitable.  
 0.00 RYDAL HOTEL MERRINA - HEAD NORTH TOWARDS SCONE & WILLOW TREE - ALONG VENNACHER ST.  
 0.50 TURN LEFT INTO WILLOW TREE & SCONE ROAD  
 2.4 TURN LEFT TOWARDS WILLOW TREE  
 3.3 CAUSEWAY  
 4.5 PASS MT STATION RD. ON LEFT  
 21.2 PASS ROAD ON LEFT "MIDDLE CREEK RD CUMMUN RD."  
 21.8 TURN RIGHT SA "DALES CREEK"  
 24.2, 26.6, 27.4, 27.4 GRADES  
 29.6 TURN RIGHT  
 29.75 OWNERS HOUSE ON LEFT  
 29.8 TURN LEFT ALONG FENCE PAST 1ST SMALL SHED  
 29.9 THROUGH IRON GATE ON RIGHT, TRACK GOES TO LEFT OF WATER TROUGH  
 30.1 CONTINUE BANK - FOLLOW TRACK SW OVER CONTOUR BANKS  
 30.9 FOLLOW TRACK BESIDE FENCE ON RIGHT  
 31.4 TRACK JERKS LEFT PAST GATE & FENCE CORNER ON RIGHT  
 31.7 FOLLOW TRACK - 216 ZAG UP HILL TO SOUTH  
 32.8 LEAVE VEHICLE AT TOP OF RIDGE - CROSS FENCE WALK IN S.W DIRECTION TO G.S.  
 10 MIN. WALK.

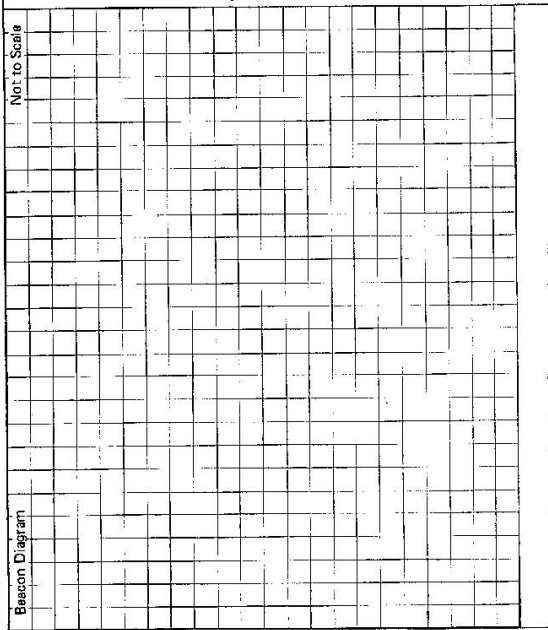

This section to be completed by officer constructing pillar.  
 Original station mark found/not found.  
 Description of mark: .....  
 Original beacon found/not found.  
 Description of beacon: .....  
 Height Top of Vanes to Top Mark: .....m.  
 Height of mark: .....m. above G.L. / .....m. below  
 Diameter of Vanes: .....m. Height of Cairn: .....m.  
 Original Beacon has/has not been destroyed by me.

Date	Record of Station