

TS 6716

GEODETTIC SURVEY OF N.S.W.

CENTRAL MAPPING AUTHORITY

GEODETTIC STATION RECONNAISSANCE and MAINTENANCE REPORT

STATION: **WARRAH RIDGE**

No.: **4687**

MAP SHEET  
SCALE 1:250 000

TAMWORTH


INSPECTED BY: **G.C.HANNA**

DATE: **15/1/79**

AUTHORITY:

FIELD BOOK:

- Description:
- Note: Cross out word or words which do not apply*
1. Cleared by lances bearing.....from Trig. Mast
  2. Mast & Vanes have been painted white & black respectively.
  3. The station/pillar was unpiled/not unpiled/constructed on.....19....., dimensions now being:  
Description of mark.....should be explicit, e.g., S/Steel Pillar Plate, Steel plug, Brass plug, Bolt, G.I. Pipe  
Height of mark.....m. <sup>above</sup> <sub>below</sub> rock/concrete; Mark is.....m. <sup>above</sup> <sub>below</sub> G.L.  
Height of Top Vanes to Top Mark/Pillar plate.....m. Diameter of Vanes (vertical).....m.  
Height of Cairn.....m. Diameter of Cairn.....m. Name Plate found/not found/placed.  
Length of Mast.....m. (approximate if not unpiled)
  4. A.....set in conc/rock has been placed/found, bearing.....° M from Mast/Plug/Pillar
  5. A.....set in conc/rock has been placed/found, bearing.....° M from Mast/Plug/Pillar
  6. A.....set in conc/rock has been placed/found, bearing.....° M from Mast/Plug/Pillar
  7. A.....set in conc/rock has been placed/found, bearing.....° M from Mast/Plug/Pillar
  8. Action required:.....

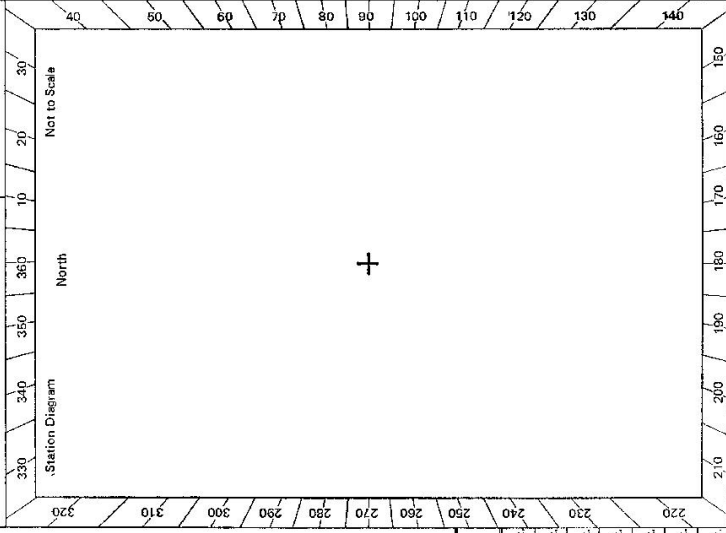

STANDPOINT:

Mark	Direction	Horiz. Distance	Height Difference	Mark	Direction	Horiz. Distance	Height Difference
			above standpt. below				above standpt. below
			above standpt. below				above standpt. below
Prepared by: **G.C.Hanna**

Checked:

Noted on U.T.M. Card

GS 24

STATION	WARRAH RIDGE	TS 6716
<p>Owner's Name: .....</p> <p>Address: .....</p> <p>Phone: .....</p> <p>Current Occupant: .....</p> <p>Address: .....</p> <p>Phone: .....</p> <p><b>ACCESS</b></p> <p>Access Report of 15/11/1979 was found suitable/unsuitable.</p> <p>Trig found in good order &amp; condition 1 metre cairn, 2 metre mast &amp; vanes. Cairn was not upright Light clearing required for 360° vision Drive to.</p> <p>For best access see property owner at Rockleigh See also Quirindi 9034 - IV - N</p>	<p>Not to Scale</p>	<p>Date</p> <p>Record of Station</p>
<p>This section to be completed by officer constructing pillar.</p> <p>Original station mark found/not found.</p> <p>Description of mark: .....</p> <p>Original beacon found/not found.</p> <p>Description of beacon: .....</p> <p>Height Top of Vanes to Top Mark .....m.                  above                      below              Height of mark .....m.   rock/conc .....m.   below G.L.              Diameter of Vanes .....m.                      Height of Cairn .....m.</p> <p>Original Beacon has/hes not been destroyed by me.</p>		

GEODETIC SURVEY OF M.S.I.M.

CENTRAL MAPPING AUTHORITY

GEODETIC STATION RECONNAISSANCE and MAINTENANCE REPORT

STATION: **WARRAH MULE (P)** No.: **6716**  
 MAPSHEET SCALE 1:250 000 TOWN/CORRTH 1:250 000  
 INSPECTED BY: **C. PARCES** DATE: **3/7/21**  
 AUTHORITY: **C.M.A.** FIELD BOOK: **1923**

Station Diagram  
 Not to Scale  
 North

- Description: *Note: Cross out word or words which do not apply*
- Cleared by Vanes bearing  $192.56^\circ$  to  $192.56^\circ$ ,  $125.26^\circ$  to  $125.26^\circ$ ,  $141.13^\circ$  to  $141.13^\circ$ ,  $202.92^\circ$  to  $202.92^\circ$  from Trig. Mast  
 2. Mast & Vanes have been painted white & black respectively. ✓  
 3. The station/pillar was ~~emptied/not emptied~~/constructed on  $19.23$  M.A.S.  $19.23$  dimensions now being:  $5/15$  STEEL  
 Description of mark: **PILLAR PLATE** should be explicit, e.g. S/Steel Pillar Plate, Steel plug, Brass plug, Bolt, G.I. Pipe  
 Height of mark  $1.330$  m. <sup>above</sup> rock/concrete; Mark is  $1.330$  m. <sup>above</sup> G.L.  
 Height of Top Vanes to Top Mark/Pillar plate  $1.945$  m. Diameter of Vanes (vertical)  $0.150$  m.  
 Height of Cairn  $0$  m. Diameter of Cairn  $0$  m. Name Plate ~~found/not found~~/placed.  
 Length of Mast  $0$  m. (approximate if not unplied)
  - A  $55$  m. set in conc/rock has been ~~placed~~/found, bearing  $331.0^\circ$  M from ~~Mast/Plug~~/Pillar  
 5. A  $55$  m. set in conc/rock has been ~~placed~~/found, bearing  $202.92^\circ$  M from ~~Mast/Plug~~/Pillar  
 6. A  $55$  m. set in conc/rock has been placed/ found, bearing  $0^\circ$  M from Mast/Plug/Pillar  
 7. A  $55$  m. set in conc/rock has been placed/ found, bearing  $0^\circ$  M from Mast/Plug/Pillar  
 8. Action required:  $0$

PILLAR SP.COR				STANDPOINT: BRASS PLUG			
Mark	Direction	Horiz. Distance	Height Difference	Mark	Direction	Horiz. Distance	Height Difference
FOUR MULE C.S.	0 00 00 ✓		above standpt	FOUR MULE C.S.	0 00 00 ✓		above standpt
CAUSS (P)	125 26 05 ✓		above standpt	CAUSS (P)	125 26 20 ✓		below standpt
S.S.M.	170 16 30 ✓	2.335	below standpt	PILLAR SP.COR	141 13 20 ✓	2.931	below standpt
BRASS PLUG	321 17 10 ✓	2.922	below standpt	S.S.M.	192 56 20	2.335	0.360 below standpt
METTAM (P)	316 42 35 ✓		above standpt	METTAM (P)	316 41 50		below standpt
			above standpt				below standpt
			below				below

Prepared by: **C. PARCES** Checked: **7/7/21** Noted on U.T.M. Card

GS 24

STATION	WARDAH RIDGE (1) TS 6716
Owner's Name: <u>Dr. M. G. ABRAH</u>	Current Occupant: .....
Address: <u>ROCKLEIGH</u>	Address: .....
Phone: <u>232 K (HOME) 454 (OFFICE)</u>	Phone: .....
ACCESS	
<p>Access Report of 20/10/1988 was found suitable/unsuitable.</p> <p>0-00 FOLLOW TREE TRADIEL SOUTH.</p> <p>0-26 TURN RIGHT OFF HIGHWAY &amp; CROSS RAILWAY LINE SIGNPOST "MERIWAJA"</p> <p>0-85 TURN LEFT SIGNPOST "MERIWAJA"</p> <p>2-15 TURN RIGHT SIGNPOST "MERIWAJA 76 BLACKVILLE 53"</p> <p>9-64 TURN RIGHT SIGNPOST "WARDAH RIDGE ROAD"</p> <p>20-34 TURN RIGHT SIGNPOST "BURINDI"</p> <p>25-00 TURN RIGHT INTO "ROCKLEIGH PROPERTY"</p> <p>25-36 THROUGH DOUBLE IRON GATES NEAR AIRCRAFT HANDLER &amp; FOLLOW TRACK ALONG AIRSTRIP.</p> <p>27-00 THROUGH DOUBLE IRON GATES AT END OF AIRSTRIP &amp; FOLLOW TRACK TO LEFT.</p> <p>27-74 TURN RIGHT THROUGH IRON GATE JUST BEFORE DOUBLE IRON GATE.</p> <p>28-10 KEEP FENCE ON LEFT. AT GLAZED TREE CROSS GULLY &amp; FOLLOW TRACK UP GULLY TO RIDGETOP.</p> <p>28-77 WARDAH RIDGE C.S. OF.</p> <p style="text-align: center;"><u>NO ACCESS</u></p>	
Date	Record of Station
29 MAY 8	CONCRETE PILLAR PLACED.

Not to Scale	
<p>This section to be completed by officer constructing pillar.</p> <p>Original station mark found/<del>not found</del>.</p> <p>Description of mark: <u>CONCRETE PILLAR 500mm CONCRETE BELL</u></p> <p>Original beacon found/<del>not found</del>.</p> <p>Description of beacon: <u>CAM MAST 4 GAJES</u></p> <p>Height Top of Vanes to Top Mark: <u>3.155</u> m. <input checked="" type="checkbox"/> above <input type="checkbox"/> below G.L.</p> <p>Height of mark: <u>0.24m</u> <input checked="" type="checkbox"/> above <input type="checkbox"/> below G.L.</p> <p>Diameter of Vanes: <u>0.750</u> m. / Height of Cairn: <u>1.000</u> m.</p> <p>Original Beacon has/<del>has not</del> been destroyed by me.</p>	