

GEODETIC SURVEY OF NS.I.M

CENTRAL MAPPING AUTHORITY

GEODETIC STATION RECONNAISSANCE and MAINTENANCE REPORT

- Description:
1. Cleared by lanes bearing..... Note: Cross out word or words which do not apply
 from Trig. Mast
2. Mast & Vanes have been painted white & black respectively.
3. The station/pillar was unpiled/not unpiled/constructed on.....19....., dimensions now being:
 Description of mark.....should be explicit, e.g., S/Steel Pillar Plate, Steel plug, Brass plug, Bolt, G.I. Pipe
 Height of mark.....m. ^{above} _{below} rock/concrete; Mark is.....m. ^{above} _{below} G.L.
 Height of Top Vanes to Top Mark/Pillar plate.....m. Diameter of Vanes (vertical).....m.
 Height of Cairn.....m. Diameter of Cairn.....m. Name Plate found/not found/placed.
 Length of Mast.....m. (approximate if not unpiled)
4. A.....set in conc/rock has been placed/found, bearing.....°M from Mast/Plug/Pillar
5. A.....set in conc/rock has been placed/found, bearing.....°M from Mast/Plug/Pillar
6. A.....set in conc/rock has been placed/found, bearing.....°M from Mast/Plug/Pillar
7. A.....set in conc/rock has been placed/found, bearing.....°M from Mast/Plug/Pillar
8. Action required: *Pillaring*

STANDPOINT:			
Mark	Horiz. Distance	Height Difference	Direction
		above standpt.	
		below standpt.	
		above standpt.	
		below standpt.	
Prepared by: *Pillaring* Checked: *Pillaring* Noted on U.T.M. Card

Sc 2730-1

STATION: **MAGNETON GS** No.: **TS 6730**
 MAP SHEET SCALE 1:250 000 **GILGANDRA**
 INSPECTED BY: **C. BOSLOPER** DATE: **26-2-81**
 AUTHORITY: **CMA** FIELD BOOK: **1887**

Station Diagram

Not to Scale

Seem pole d does Ad.
 2 huffines still on mast.
 no sec. marks fl.

Sammale zee
 140m


Magnum GS
 140m

FRIEND GS
 140m

Shrub here & there.

CENTRAL MAPPING AUTHORITY
 GEODETIC SURVEY OF N.S.W. *Block 1483*
 GEODETIC STATION RECONNAISSANCE and MAINTENANCE REPORT

STATION: **MAGOMETON (P)** No.: **6730**
 MAP SHEET SCALE 1:250 000
 INSPECTED BY: **L HITCHINS** DATE: **11/1/81**
 AUTHORITY: **C.M.A.** FIELD BOOK: **L1924**

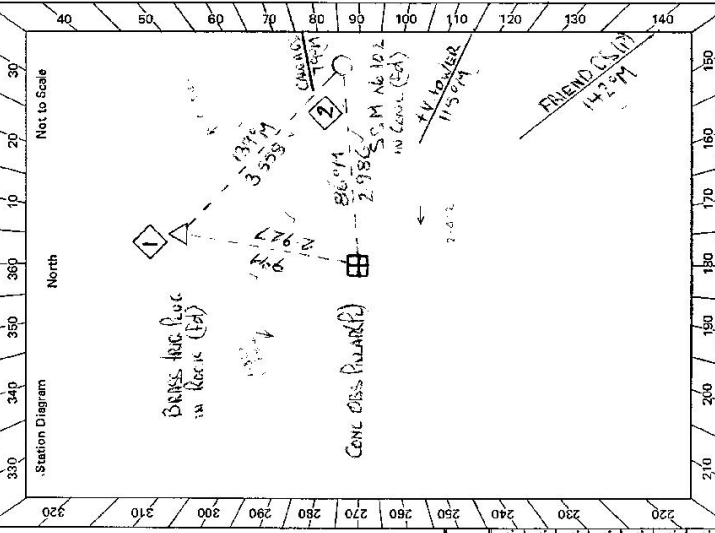

- Description: *Note: Cross out word or words which do not apply*
- Cleared by lanes bearing..... *360°* from Trig. Mast
 - Mast & Vanes have been painted white & black respectively. ✓
 - The station/pillar was ~~unpainted~~/not unpainted/constructed on..... *15.7.19.81*..... dimensions now being: *1.360m* above *rock/concrete*; Mark is *1.630m* above *G.L.*
 - Description of mark *SSM No 102* should be explicit, e.g., S/Steel Pillar Plate, Steel plug, Brass plug, Bolt, G.I. Pipe
 - Height of mark..... *1.360m* above *rock/concrete*; Mark is *1.630m* above *G.L.*
 - Height of Top Vanes to Top-Mark/Pillar plate *1.390m*. Diameter of Vanes (vertical)..... *0.750m*.
 - Height of Cairn..... *0.750m*. Diameter of Cairn..... *0.750m*. Name Plate *found*/not found/placed.
 - Length of Mast..... *0.750m*. (approximate if not unpiled)
 - A. *BRASS IRON PILE* set in *rock*/rock has been *placed*/found, bearing..... *91°* M from *Mast/Plug/Pillar*
 - A. *SSM No 102* set in *conc/rock* has been *placed*/found, bearing..... *86.6°* M from *Mast/Plug/Pillar*
 - A..... set in *conc/rock* has been *placed*/found, bearing..... *0°* M from *Mast/Plug/Pillar*
 - A..... set in *conc/rock* has been *placed*/found, bearing..... *0°* M from *Mast/Plug/Pillar*
 - Action required:.....

STANDPOINT: <i>SS PILLAR PLATE</i>			STANDPOINT: <i>BRASS TRIC PILE</i>			
Mark	Direction	Horiz. Distance	Height Difference	Direction	Horiz. Distance	Height Difference
<i>CALCA CS</i>	<i>0 00 00</i>		<i>above</i> standpt.	<i>0 00 00</i>		<i>above</i> standpt.
<i>SSM No 102</i>	<i>4 25 05</i>	<i>2.980</i>	<i>above</i> standpt.	<i>38 30 15</i>		<i>above</i> standpt.
<i>TV TOWER</i>	<i>38 30 20</i>		<i>below</i> standpt.	<i>56 39 30</i>		<i>below</i> standpt.
<i>FRIEND CS (P)</i>	<i>56 39 15</i>		<i>above</i> standpt.	<i>56 40 40</i>	<i>3.558</i>	<i>above</i> standpt.
<i>BRASS IRON PILE</i>	<i>290 26 30</i>	<i>2.927</i>	<i>below</i> standpt.	<i>110 25 45</i>	<i>2.927</i>	<i>below</i> standpt.
			<i>above</i> standpt.			<i>above</i> standpt.
			<i>below</i> standpt.			<i>below</i> standpt.

Prepared by: *L.C. Hill* Checked: *Michael Clarke 28/1/81* *Noted on U.T.M. Card*


STATION **MARGMETHON GS (1) 6730**

Owner's Name: **ARTHUR BARDER**
 Address: **MARGMETHON ROAD, COONAMBLE**
 Phone: **083 - 256112**

Current Occupant:
 Address:
 Phone:

ACCESS
 Access Report of 26/12/1981 was found suitable/unsuitable.
 0 0 COONAMBLE PO HEAD SOUTH ✓
 0 8 TURN LEFT TO KRAMBEENAH ROAD ✓
 6 6 PASS ROAD ON RIGHT SIGN "WINDY" ✓
 7 1 CROSS WARANA CREEK ✓
 25 05 TURN LEFT AT WHITE MAIL BOX OWNERS HOUSE 0 15 SIGNIFICANT AREA ON RIGHT
 26 55 THROUGH GATE LOWER RAMP THIS GATE COULD BE LOCKED AT WEEKEND ✓
 26 55 PASS OFFICE ON LEFT, CALL IN, COULD BE BURSTING IN QUARRY ✓
 26 6 TAKE LEFT FORK ✓
 26 75 PASS CRUSHER ON RIGHT ✓
 26 8 TAKE TRUCK ON LEFT ✓
 26 25 PASS HUT + TRUCK ON RIGHT ✓
 27 05 TAKE LEFT HAND TRACK HEAD STRAIGHT TOWARD TRIG ✓
 27 4 STOP TRUCK LEVIN WALK TO PILLAR ✓

THE LAST PART OF THIS ACCESS COULD CHANGE DUE TO QUARRY BEING EXTENDED ✓

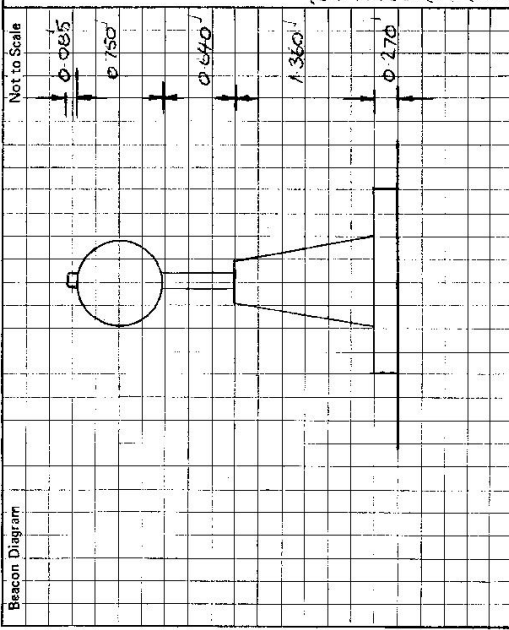

This section to be completed by officer constructing pillar.
 Original station mark found/~~not found~~.
 Description of mark: **BRASS TRIG PILLAR IN ROCK**
 Original beacon found/~~not found~~.
 Description of beacon: **CAIRN POLE + DISCS**
 Height Top of Vanes to Top Mark: **3.650** m.
 Height of mark: **0.55** m. above rock/~~0.36~~ m. above G.L. below
 Diameter of Vanes: **0.210** m. Height of Cairn: **1.200** m.
 Original Beacon has/~~has not~~ been destroyed by me.

Date	Record of Station

CENTRAL MAPPING AUTHORITY

GEODETIC SURVEY OF N.S.W.

GEODETIC STATION RECONNAISSANCE and MAINTENANCE REPORT

Description:

1. Cleared by lanes bearing $323-23^{\circ}M$, $82-132^{\circ}M$. *Note: Cross out word or words which do not apply*
 (132-198m scattered timber), 198-256m. from Trig. Mast

2. Mast & Vanes have been painted white & black respectively.

3. The station/pillar was ~~replaced~~ ^{DISMANTLED} ~~constructed~~ on 17 19 $3\frac{1}{2}$ dimensions now being:

Description of mark $5\frac{1}{2} \times 1\frac{1}{2}$ should be explicit, e.g., S/Steel Pillar Plate, Steel plug, Brass plug, Bolt, G.I. Pipe

Height of mark 0.35 m. above ~~below~~ ^{rock/concrete} Mark is AT m. ~~above~~ ^{below} G.L.

Height of Top Vanes to Top Mark/Pillar plate 7.935 m. Diameter of Vanes (vertical) 9.5 m.

Height of Cairn m. Diameter of Cairn m. Name Plate ~~found~~/not found/~~attached~~.

Length of Mast 3.120 m. (~~approximate if not supplied~~)

4. A. set in conc/rock has been placed/found, bearing ° M from Mast/Plug/Pillar

5. A. set in conc/rock has been placed/found, bearing ° M from Mast/Plug/Pillar

6. A. set in conc/rock has been placed/found, bearing ° M from Mast/Plug/Pillar

7. A. set in conc/rock has been placed/found, bearing ° M from Mast/Plug/Pillar

8. Action required: ~~IF APPROVED, CONCRETE PILLAR TO BE PLACED AND ALL ROUND CLEARING TO BE CARRIED OUT.~~

STANDPOINT:

Mark	Direction	Horiz. Distance	Height Difference	Mark	Direction	Horiz. Distance	Height Difference
			above standpt.				above standpt.
			below				below
			above standpt.				above standpt.
			below				below
Prepared by: D. KAIN

Checked: P. POTTS

11/2/86

Noted on U.T.M. Card

STATION: MAGPIE G.S. No.: 6730

MAP SHEETS SCALE 1:250 000 *COLLIER* SCALE 1:100 000 *POCKWELL*

INSPECTED BY: D. J. KAIN DATE: 12.9.1986


AUTHORITY: C. M. A. FIELD BOOK: C 380

Station Diagram

Net to Scale

Checked

SI 2733-2 D. Wier, Government Printer

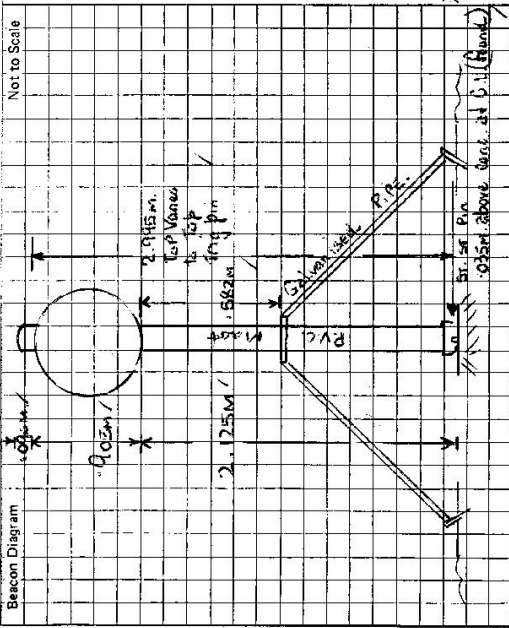

This section to be completed by officer constructing pillar.

Original station mark found/~~relocated~~.
 Description of mark: S.I. 1st. 1st.
 Original beacon found/~~relocated~~. and was dismantled on my visit 12.4.24
 Description of beacon: P.V.C. mark held upright by construction
 Height Top of Vanes to Top Mark: 2.145 m.
 Height of mark: 0.03 m. above mark conc. 1.1 m. below G.L.
 Diameter of Vanes: 90.5 m. Height of Cairn: 1.1 m.
 Original Beacon ~~found~~/has not been destroyed by me.

STATION MAEPIE GROUPELIE STATION 6730
 Owner's Name: TRIS RICHARDS No 19157
 Address: 159 AUBURN STREET GARDENHURST
 Phone: (048) 230 6000
 Access Report of 12-9-1986 was found suitable/unsuitable.
 No Permits Access 12-9-1986
 Access Report of 12-9-1986 was found suitable/unsuitable.

- KLMS
- / 0.00 AT THE TOWNSHIP OF BINDA ABOUT 2.0 KLMS. NORTH OF CROOKWELL.
 - / 0.03 TURN RIGHT INTO BISHOP STREET. -- SIGNPOST, PEELWOOD 29.
 - / 0.98 CONTINUE ALONG KANGALLOOLAN ROAD PASSING GOLDSMITH STREET ON YOUR R.H.S.
 - / 4.38 TAKE LEFT FORK. SIGNPOST KANGALLOOLAN ROAD & PEELWOOD.
 - / 7.27 TAKE LEFT FORK. SIGNPOST KANGALLOOLAN ROAD & PEELWOOD.
 - / 8.37 PASS BRIDGE OVER CREEK ROAD ON LEFT. BOURNE ON YOUR LEFT.
 - / 17.09 PASS PART ACCESS OWNERS HOUSE MRS. BOURNE ON YOUR LEFT.
 - / 17.09 OVER STEEL GRID.
 - / 18.20 TURN LEFT THROUGH IRON GATE.
 - / 18.38 CREEK CROSSING.
 - / 19.59 TRUCK TURNS LEFT. ABOUT 200 METRES BEFORE DAM. FOLLOW TRACK WESTERLY UP VALLEY.
 - / 19.71 TAKE RIGHT BULDOZED TRACK UP HILL.
 - / 20.52 TRACK TURNS LEFT ALONG TOP OF RIDGE.
 - / 20.52 THROUGH IRON GATE.
 - / 20.76 MINOR TRUCK TO LEFT. TAKE WIDE TRACK STRAIGHT AHEAD DOWN INTO SADDLE MAEPIE G.S.
 - / 21.81 Access Owners Request Dry weather access only. 4WD & LOW RANGE.

Date	Record of Station