

TS - 6732

GEODETTIC SURVEY OF N.S.W.


GEODETTIC STATION RECONNAISSANCE and MAINTENANCE REPORT

STATION: *Doona* No: *1854*

MAP SHEET SCALE 1:250 000 *TAMWORTH*

INSPECTED BY: *P.K. BARNOLA* DATE: *22/3/22*

AUTHORITY: *C.M.P.A.* FIELD BOOK:

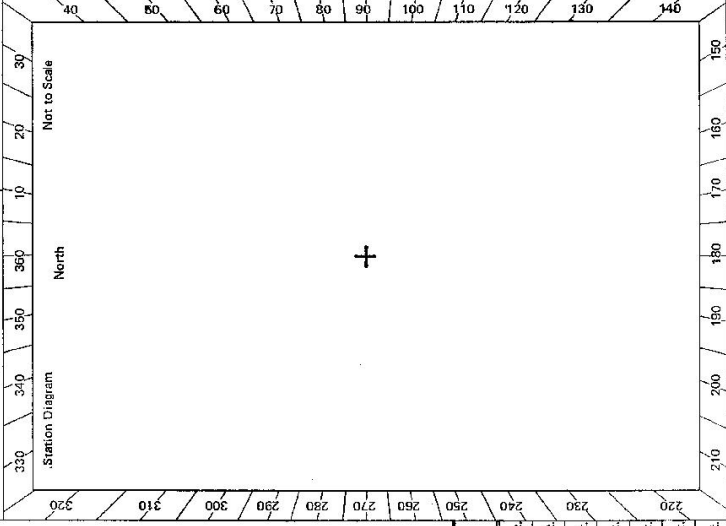

- Description:
- Cleared by lanes bearing. *Note: Cross out word or words which do not apply*
 - Mast & Vanes have been painted white & black respectively, found in cairn of rocks
 - The station/pillar was unpainted/not unpainted/constructed on.....m. *19*.....dimensions new being:
- Description of mark.....should be explicit, e.g., S/Steel Pillar Plate, Steel plug, Brass plug, Bolt, G.I. Pipe
- Height of mark.....m. ^{above} _{below} rock/concrete; Mark is.....m. ^{above} _{below} G.L.
- Height of Top Vanes to Top Mark/Pillar plate.....m. Diameter of Vanes (vertical).....m.
- Height of Cairn.....m. Diameter of Cairn.....m. Name Plate found/not found/placed.
- Length of Mast.....m. (approximate if not unpiled)
- A.....set in conc/rock has been placed/found, bearing.....° M from Mast/Plug/Pillar
 - A.....set in conc/rock has been placed/found, bearing.....° M from Mast/Plug/Pillar
 - A.....set in conc/rock has been placed/found, bearing.....° M from Mast/Plug/Pillar
 - A.....set in conc/rock has been placed/found, bearing.....° M from Mast/Plug/Pillar

8. Action required: *limited visibility from and to the station. At least one of its position in fence Reserve*

STANDPOINT:

Mark	Direction	Horiz. Distance	Height Difference	Mark	Direction	Horiz. Distance	Height Difference
			above standpt.				above standpt.
			below				below
			above standpt.				above standpt.
			below				below
Prepared by: *P.K. Barnola 11/4/22* Checked: *[Signature]* Noted on U.T.M. Card

St 2733-2 D. West, Government Printer

STATION *Deoria* *TS 6732*

Beacon Diagram		Not to Scale
----------------	--	--------------

Owner's Name:
 Address:
 Phone:
 Current Occupant:
 Address:
 Phone:

Access Report of *22.3.19* was found suitable/unsuitable.

Refer Breeza 125000 Chart
Station: Arnie-to
 ACCESS

This section to be completed by officer constructing pillar.

Original station mark found/not found.

Description of mark:

Original beacon found/not found.

Description of beacon:

Height Top of Vanes to Top Mark:m.

Height of mark:m. above G.L.
below rock/cons.m. below

Diameter of Vanesm. Height of Cairnm.

Original Beacon has/has not been destroyed by me.

Date	Record of Station


75-6732

STATION: **DOONA** No.: **1854**

MAPSHEET SCALE 1:250 000 **TAMWORTH**

INSPECTED BY: **O. MOSS** DATE: **26-11-80**

AUTHORITY: **C.M.A.** FIELD BOOK: **1876**

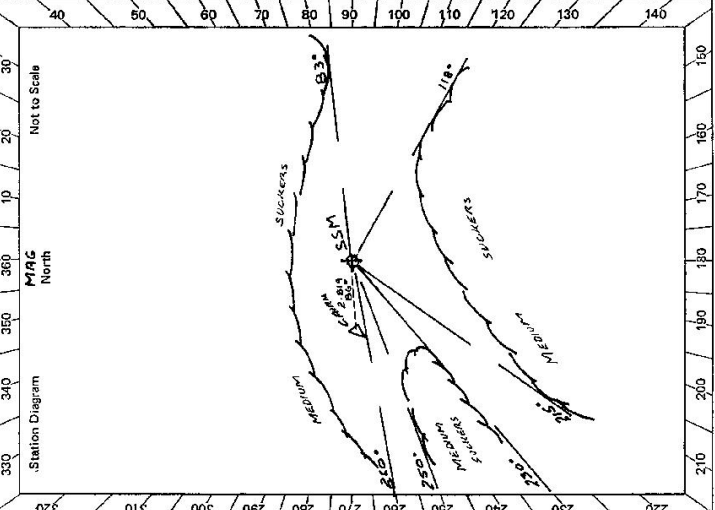

GEODETTIC STATION RECONNAISSANCE and MAINTENANCE REPORT

Description: *Note: Cross out word or words which do not apply*


- Cleared by lanes bearing... from Trig. Mast
- Mast & Vanes have been painted white & black respectively.
- The station/pillar was unpiled/unpiled on... dimensions now being:
 - Description of mark: should be explicit, e.g. S/Steel Pillar Plate, Steel plug, Brass plug, Bolt, G.I. Pipe
 - Height of mark: m. above rock/concrete; Mark is... m. above G.L.
 - Height of Top Vanes to Top Mark/Pillar plate ... m. Diameter of Vanes (vertical) ... m.
 - Height of Cairn ... m. Diameter of Cairn ... m. Name Plate found/not found/placed.
 - Length of Mast ... m. (approximate if not unpiled)
- A ... set in conc/rock has been placed/found, bearing ... M from Mast/Pillar
- A ... set in conc/rock has been placed/found, bearing ... M from Mast/Pillar
- A ... set in conc/rock has been placed/found, bearing ... M from Mast/Pillar
- A ... set in conc/rock has been placed/found, bearing ... M from Mast/Pillar
- Action required: *Construct concrete pillar 2-3 days clearing 360° view*

STANDPOINT:		STANDPOINT:					
Mark	Direction	Horiz. Distance	Height Difference	Mark	Direction	Horiz. Distance	Height Difference
MOOKI	176° 06'	15.8	hill, above standpt.				above standpt.
LOOLANBILLA	256° 14'	23.4	hill, below standpt.				above standpt.
BINNIE	212° 13'	18.8	hill, below standpt.				below standpt.
GRENFELL	95° 06'	19.3	hill, above standpt.				below standpt.
LOOMOO	211° 34'	29.4	hill, below standpt.				below standpt.
TAMARANG	233° 33'	19.3	hill, below standpt.				above standpt.
			hill, below standpt.				below standpt.

Prepared by: *O. Moss* Checked: *P. Holden* Noted on U.T.M. Card

27233-2.D. West Government Printer

STATION **DOONA TS-6732**

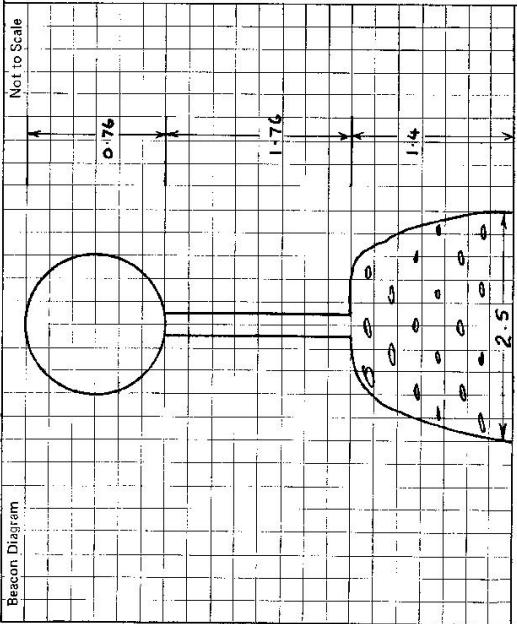

Owner's Name: **EDAR STAY COMMISSION-348**
 Address: **33 ABBOTT ST GUNNAPPA KENNEDY**
 Phone: **067-429200**

Current Occupant:
 Address:
 Phone:
ACCESS
 Access Report of **26/11/1980** was found suitable/unsuitable.

- 00 AT CAROONA RD. HEAD TOWARDS GUNNAPPA.
- 0.7 TURN LEFT BEFORE BRIDGE
- 1.1 TURN RIGHT OFF BITUMEN ROAD ONTO DIAT ROAD AT SIGN "ROSSMOR PARK STUD"
- 1.6 RAILWAY CROSSING
- 2.8 GRAID
- 3.8 GRID
- 4.7 TURN LEFT OFF MAIN TRACK.
- 4.8 GO THROUGH IRON GATE IN E-W FENCE. TAKE RIGHT HAND TRACK & FOLLOW AROUND BOUNDARY OF STATE FOREST.
- 4.9 PASS TRACK ON LEFT.
- 8.7 TURN LEFT ONTO WEEDING ROAD.
- 10.1 TURN LEFT AT TRACK INTERSECTION AT TOP OF RIDGE
- 11.0 DOONA TRIG

This section to be completed by officer constructing pillar.

Original station mark found/not found.
 Description of mark:
 Original beacon found/not found.
 Description of beacon:
 Height Top of Vanes to Top Markm.
 Height of mark:m. above below G.L.
 Diameter of Vanesm. Height of Cairnm.
 Original Beacon has/has not been destroyed by me.

Date	Record of Station
11-12-80	PERMISSION TO BUILD PILLAR & CLEAR LANS OF TIMBER.

GEODETIC SURVEY OF NS.I.M

CENTRAL MAPPING AUTHORITY


GEODETIC STATION RECONNAISSANCE and MAINTENANCE REPORT

STATION: 000000A (1) No.: 632

MAPSHEET SCALE 1:250 000

INSPECTED BY: C. PAKKES DATE: 16 JUL 21

AUTHORITY: C.M.A. FIELD BOOK: 1912

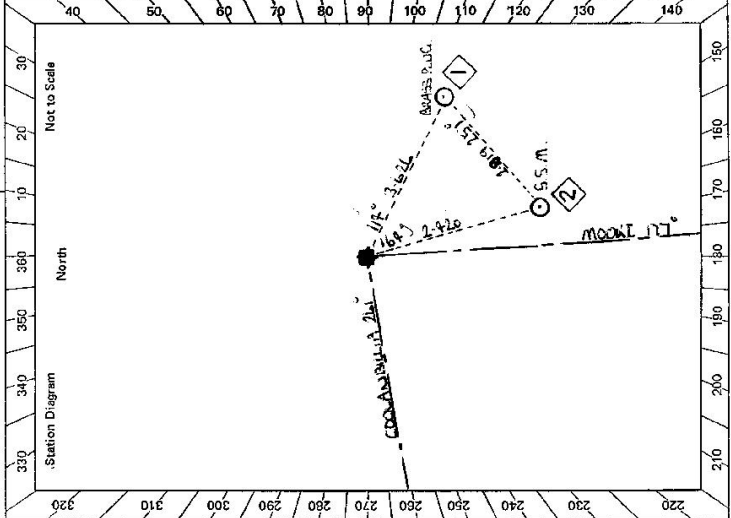

Description:	Mark	Direction	Horiz. Distance	Height Difference	Mark	Direction	Horiz. Distance	Height Difference
1. Cleared by lanes bearing $315^\circ 45' 14.5''$ to $14.5''$ to $128^\circ 45' 28.5''$ to $289^\circ 45' 28.5''$ from Trig. Mast								
2. Mast & Vanes have been painted white & black respectively.								
3. The station/pillar was unplaced constructed on 11.1×11.1 m. dimensions now being $5/6$ m.								
Description of mark: PLATE $5/6$ m. S/Steel Pillar Plate, Steel plug, Brass plug, Bolt, G.I. Pipe								
Height of mark: 1.390 m. above level concrete; Mark is 1.390 m. above G.L.								
Height of Top Vanes to Top Mark/Pillar plate: 1.455 m. Diameter of Vanes (vertical): 0.155 m.								
Height of Cairn: 0.000 m. Diameter of Cairn: 0.000 m. Name Plate found/not found/placed.								
Length of Mast: 0.000 m. (approximate if not piled)								
4. A. BRASS PILLAR set in conc/rock has been placed found, bearing $114^\circ 35' 21''$ M from level Plug/Pillar	MOULI (1)	O 00 00			MOULI (1)	O 00 00		
5. A. S.S.M. set in conc/rock has been placed found, bearing $114^\circ 35' 21''$ M from level Plug/Pillar	COOLANBULLA (1)	80 06 40			COOLANBULLA (1)	80 06 30		
6. A. S.S.M. set in conc/rock has been placed/found, bearing $114^\circ 35' 21''$ M from Mast/Plug/Pillar	BRASS PILLAR	361 58 50	3.625	1.350	S.S.M.	80 08 40	2.619	1.006
7. A. S.S.M. set in conc/rock has been placed/found, bearing $114^\circ 35' 21''$ M from Mast/Plug/Pillar	S.S.M.	352 55 20	2.426	1.957	PILLAR SPICE	121 58 40	3.627	1.351
8. Action required:								

STANDPOINT: PILLAR SPICE
 Prepared by: C. PAKKES
 Checked: [Signature]

GEODETTIC SURVEY OF N.S.W.

CENTRAL MAPPING AUTHORITY

GEODETTIC STATION RECONNAISSANCE and MAINTENANCE REPORT

Description:

1. Cleared by lanes bearing *lanes A.C. 2.56m, 96m, 3.55m* *1m - 2m, 16m - 17m from Trig, Mast*
Note: Cross out word or words which do not apply
2. Mast & Vanes have been painted white & black respectively. ✓
3. The station/pillar was unpiled/not unpiled/constructed on.....19....., dimensions now being:

Description of mark: *Steel Pillar*..... should be explicit, e.g., S/Steel Pillar Plate, Steel plug, Brass plug, Bolt, G.I. Pipe

Height of mark.....m..... ^{above} _{below} rock/concrete; Mark is.....m..... ^{above} _{below} G.L.

Height of Top Vanes to Top Mark/Pillar plate.....m..... Diameter of Vanes (vertical).....m.

Height of Cairn.....m..... Diameter of Cairn.....m..... Name Plate found/~~not found~~/placed.

Length of Mast.....m..... (approximate if not unpiled)

4. A.....*SSM 1.56*..... set in conc/reek has been placed/found, bearing.....°M from Mast/Plug/Pillar

5. A.....*B.BASS. 1.16m. Plug*..... set in conc/rock has been placed/found, bearing.....°M from Mast/Plug/Pillar

6. A..... set in conc/rock has been placed/found, bearing.....°M from Mast/Plug/Pillar

7. A..... set in conc/rock has been placed/found, bearing.....°M from Mast/Plug/Pillar

8. Action required:.....

STANDPOINT:

STANDPOINT:

Mark	Direction	Horiz. Distance	Height Difference	Mark	Direction	Horiz. Distance	Height Difference
			above standpt.				above standpt.
			below standpt.				below standpt.
			above standpt.				above standpt.
			below standpt.				below standpt.
Prepared by: *J. Reid 19/6/88*

Checked: *K. O'Farrell 17/88*

Noted on U.T.M. Card

Checked: *M.J.*

STATION: *DOONA (P)* No.: *6732*
 MAP SHEETS SCALE 1:250 000
 INSPECTED BY: *TAMMORATH*
 AUTHORITY: *C.M.A.* DATE: *13-9-88*
 FIELD BOOK: *1949*


Scale 1:100 000
 Station Diagram
 North
 Not to Scale

320 310 300 290 280 270 260 250 240 230 220
 210 200 190 180 170 160 150 140

98-9732-2 C. West Government Printer

Beacon Diagram

Not to Scale

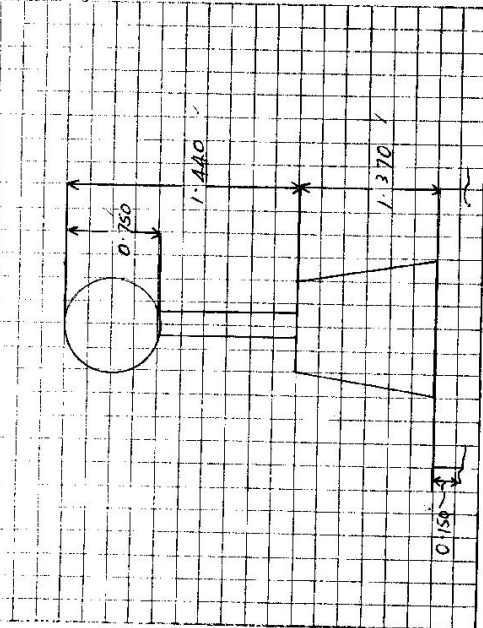

This section to be completed by officer constructing pillar.

Original station mark found/not found.

Description of mark:

Original beacon found/not found.

Description of beacon:

Height Top of Vanes to Top Mark.....m.

Height of mark.....m. above rock/conc.....m. below G.L.

Diameter of Vanesm. Height of Cairnm.

Original Beacon has/has not been destroyed by me.

STATION **DOONA (P) IS 6732**

Owner's Name:
 Address:
 Phone:
 Current Occupant:
 Address:
 Phone:

ACCESS:
 Access Report of 13/1/1983 was found suitable/unsuitable.

Date	Record of Station