

6741

STATION: **YARRA MAN** No.: **4836**


MAP SHEET
SCALE 1:250 000

INSPECTED BY: **P.K. Bamala**

DATE: **Feb. 79**

AUTHORITY: **C.M.A**

FIELD BOOK:

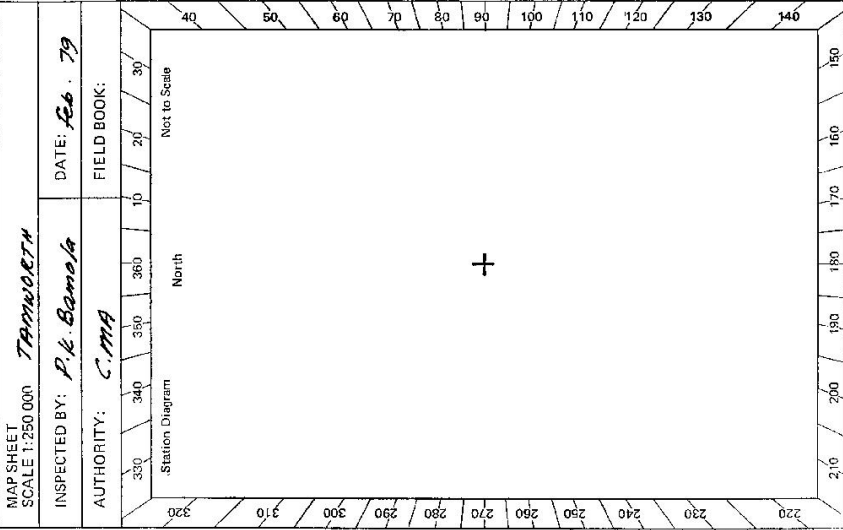

GEODETIC STATION RECONNAISSANCE and MAINTENANCE REPORT

Description: *Note: Cross out word or words which do not apply*

1. Cleared by Janes bearing..... from Trig. Mast

2. Mast & Vanes have been painted white & black respectively **fa** in cairn of rocks

3. The station/pillar was unspiled/not unspiled/constructed on....., dimensions now being:

Description of mark..... should be explicit, e.g., S/Steel Pillar Plate, Steel plug, Brass plug, Bolt, G.I. Pipe

Height of mark.....m, ^{above}/_{below} rock/concrete; Mark is.....m. ^{above}/_{below} G.L.

Height of Top Vanes to Top Mark/Pillar plate.....m. Diameter of Vanes (vertical).....m.

Height of Cairn.....m. Diameter of Cairn.....m. Name Plate found/not found/placed.

Length of Mast.....m. (approximate if not unspiled)

4. A..... set in conc/rock has been placed/found, bearing.....°M from Mast/Plug/Pillar

5. A..... set in conc/rock has been placed/found, bearing.....°M from Mast/Plug/Pillar

6. A..... set in conc/rock has been placed/found, bearing.....°M from Mast/Plug/Pillar

7. A..... set in conc/rock has been placed/found, bearing.....°M from Mast/Plug/Pillar

8. Action required: **Station is bearing..... 2 days. Sharpening..... required**

STANDPOINT: **On the Eastern side**

STANDPOINT:

Mark	Direction	Horiz. Distance	Height Difference	Mark	Direction	Horiz. Distance	Height Difference
			above standpt.				above standpt.
			below				below
			above standpt.				above standpt.
			below				below
Prepared by: **P.K. Bamala**

Checked: **14P**

Noted on U.T.M. Card

Checked

GS 24

STATION <u>Yarraman</u> 4896 <u>6741</u>	Owner's Name: Address: Phone: Current Occupant: Address: Phone: Access Report of <u>1.2.19.79</u> was found suitable/unsuitable. <u>See Blackwille 8934-14-5.</u> <u>A 4 wheel drive vehicle can be driven to within 200m of the station.</u>
Beacon Diagram Not to Scale	This section to be completed by officer constructing pillar. Original station mark found/not found. Description of mark: Original beacon found/not found. Description of beacon: Height Top of Vanes to Top Markm. Height of markm. above rock/conem. below G.L. Diameter of Vanesm. Height of Cairnm. Original Beacon has/has not been destroyed by me.
	Date Record of Station

CENTRAL MAPPING AUTHORITY

GEODETIC SURVEY OF N.S.W.

GEODETIC STATION RECONNAISSANCE and MAINTENANCE REPORT


STATION: YARRAMAN No: 6741
 MAP SHEET SCALE 1:250 000 TANNWORTH
 INSPECTED BY: D. KINLYSIDE DATE: 28. 11. 80
 AUTHORITY: C. M. A. FIELD BOOK: 1905.

- Description: *Note: Cross out word or words which do not apply*
- Cleared by lanes bearing *See diagram*
 - Mast & Vanes ~~have been painted white & black respectively.~~ Mast & vanes *red leaning*
 - The station/pillar was unpilled/not unpilled/~~constructed on~~ *19* ~~dimensions new being:~~
- Description of mark *should be explicit, e.g., S/Steel Pillar Plate, Steel plug, Brass plug, Bolt, G.I. Pipe*
- Height of mark *above below* rock/concrete; Mark is *above below* G.L.
- Height of Top Vanes to Top Mark/Pillar plate *m.* Diameter of Vanes (vertical) *1.51* m.
- Height of Cairn *1.0* m. Diameter of Cairn *2.0* m. Name Plate found/not found/placed.
- Length of Mast *2.5* m. (approximate if not unpilled)
- A *S.S.M.* set in conc/feek has been placed/found, bearing *141* M from Mast/~~Plug/Pillar~~
 - A set in conc/rock has been placed/found, bearing *141* M from Mast/Plug/Pillar
 - A set in conc/rock has been placed/found, bearing *141* M from Mast/Plug/Pillar
 - A set in conc/rock has been placed/found, bearing *141* M from Mast/Plug/Pillar
- Action required *Construct concrete pillar. 1.2.2 keys. Erecting of monument. 1.2.3. 36.0 vision NO KURAJONG TREES TO BE CLEARED*

Mark	Direction Grid	Horiz. Distance	Height Difference	Mark	Direction	Horiz. Distance	Height Difference
PIGEOON	307 37	13.2	above standpt				above standpt
COOMOO	356 44	13.1	above standpt				above standpt
MOOKI	44 28	25.2	above standpt				above standpt
WINDY	75 06	5.8	above standpt				above standpt
PARRY	120 45	16.1	above standpt				above standpt
BLACK MOUNTAIN	173 10	6.7	above standpt				above standpt
BINKIE	19	21	above standpt				above standpt

STANDPOINT: S.S.M. *1.2.2 keys. Erecting of monument. 1.2.3. 36.0 vision NO KURAJONG TREES TO BE CLEARED*

Prepared by: D. Kinlyside Checked: R. Lander 20-7-81 Noted on U.T.M. Card

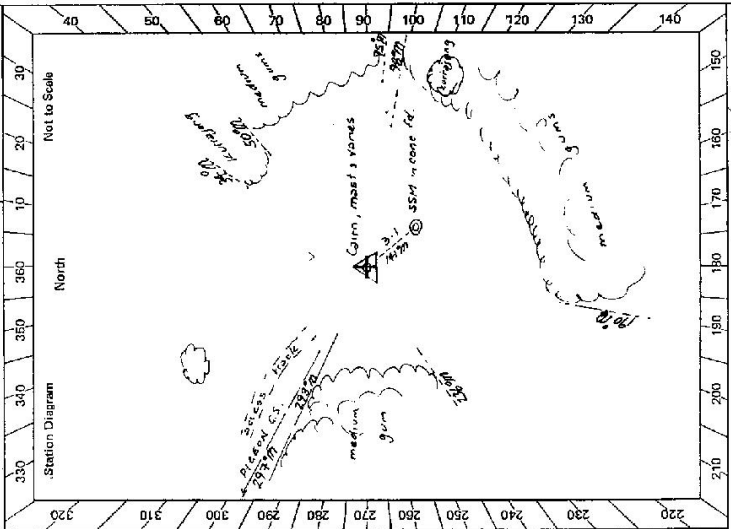

GS 24

<p>61 2733 - 2 D, West, Government Printer</p> <p>Beacon Diagram</p>	<p>STATION</p> <p>YARRAMAN TS 6741</p>	<p>Owner's Name: <i>Amaroo Holdings</i> Address: <i>H.R. Carter</i> Phone: <i>Amaroo</i></p> <p>Current Occupant: <i>B. Griffin (manager)</i> Address: <i>Amaroo</i> Phone: <i>Blackville 55</i></p> <p style="text-align: center;">ACCESS 28-11-1980</p> <p>Access Report of 21.11.1980 was found suitable/unsuitable. 0.0 Blackville 55 heading west along gravel road towards Yarraman. 6.2 Turn LEFT SP Connsbaroban 108° 7.2 Coweaway 7.5 Turn LEFT SP Yarraman Ck Road. - cross grid 8.6 Grid 9.8 turn LEFT into "Amaroo" to owners house. 10.0 Grid 11.6 Grid 12.6 Turn LEFT off main road 12.7 Thru Double iron gate and turn RIGHT along fence. 13.1 cross creek 13.2 Turn LEFT and cross gully 13.8 Thru iron gate and turn LEFT following faint track along fence line 14.4 Turn RIGHT at bend in fence and just before small gully - follow track 16.6 At top of rise - veer left along slight cutting 16.7 At end of cutting turn RIGHT up rocky slope to trig 16.8 Trig.</p>
<p>Not to Scale</p>		<p>This section to be completed by officer constructing pillar.</p> <p>Original station mark found/not found.</p> <p>Description of mark:</p> <p>Original beacon found/not found.</p> <p>Description of beacon:</p> <p>Height Top of Vane to Top Markm. above below Height of markm. rock/contm. below G.L. Diameter of Vanem. Height of Cairnm.</p> <p>Original Beacon has/has not been destroyed by me.</p>
<p>Date</p>		<p>Record of Station</p> <p><i>Permission granted by manager for access, construction of pillar, and any clearing necessary except for Kensington trees.</i></p>

GEODETIC SURVEY OF M.S.M

CENTRAL MAPPING AUTHORITY

GEODETIC STATION RECONNAISSANCE and MAINTENANCE REPORT

STATION: YARLAMPAN C. S. (P) No.: 6741
 MAP SHEET SCALE 1:250 000 TANNODUTH
 INSPECTED BY: C. PARULES DATE: 21 AUGUST 2021
 AUTHORITY: C.M.A. FIELD BOOK: 1921

Station Diagram
 Not to Scale
 North

- Description: *Note: Cross out word or words which do not apply*
- Cleared by lanes bearing..... from Trig. Mast
 - Mast & Vanes have been painted white & black respectively. ✓
 - The station/pillar was ~~unplaced/not unplaced~~/constructed on..... 19.81....., dimensions now being: S/STEEL
 Description of mark: PILLAR, B.A.F.E..... should be explicit, e.g., S/Steel Pillar Plate, Steel plug, Brass plug, Bolt, G.I. Pipe
 Height of mark.....m. above ~~below~~ rock/concrete; Mark is.....m. above ~~below~~ G.L.
 Height of Top Vanes to Top Mark/Pillar plate.....m. Diameter of Vanes (vertical) 0.750.....m.
 Height of Cairn.....m. Diameter of Cairn.....m. Name Plate ~~found/not found~~/placed.
 Length of Mast.....m. (approximate if not unplaced)
 - A..... COPPER MAIL..... set in conc/rock has been placed/~~found~~, bearing.....° M from Mast/Plug/Pillar
 - A..... STAINLESS STEEL P.W. set in conc/rock has been placed/~~found~~, bearing.....° M from Mast/Plug/Pillar
 - A..... set in conc/rock has been placed/~~found~~, bearing.....° M from Mast/Plug/Pillar
 - A..... set in conc/rock has been placed/~~found~~, bearing.....° M from Mast/Plug/Pillar
 - Action required:.....

STANDPOINT: PILLAR SPIGOT				STANDPOINT: STAINLESS STEEL P.W.			
Mark	Direction	Horiz. Distance	Height Difference	Mark	Direction	Horiz. Distance	Height Difference
PIGLOW G.S.(P)	0 00 00	0.00	above standpt	PIGLOW G.S.(P)	0 00 00	0.00	above standpt
COOMBE G.S.(P)	49 07 35	4.07	above standpt	COOMBE G.S.(P)	49 08 40	4.07	above standpt
COPPER MAIL	52 41 05	5.197	below standpt	COPPER MAIL	48 51 10	4.351	below standpt
PARRY G.S.(P)	173 13 30	3.196	below standpt	PARRY G.S.(P)	173 13 10	3.196	below standpt
STAINLESS STEEL P.W.	356 54 45	3.796	below standpt	PILLAR SPIGOT	176 53 35	3.796	below standpt
			above standpt				below standpt
			below				below

Prepared by: C. PARULES Checked: Noted on U.T.M. Card

CENTRAL MAPPING AUTHORITY

GEODETIC SURVEY OF N.S.W.K.

GEODETIC STATION RECONNAISSANCE and MAINTENANCE REPORT

STATION: YARRAMAN / No.: 674-1

MAP SHEET SCALE 1:250 000

INSPECTED BY: A. SEVERTSEN / D. KINLYSIDE / DATE: 8.10.82 / 15.01.82

AUTHORITY: C.M.A. / FIELD BOOK: C224 / C193

Description:
 1. Cleared by trees bearing.....
 Note: Cross out word or words which do not apply

2. Mast & Vanes have been painted white & black respectively.
 Note: Cross out word or words which do not apply

3. The station/pillar was ~~re-erected~~ unpiled/constructed on.....
 Note: Cross out word or words which do not apply

4. A..... set in conc/rock has been placed/found, bearing.....
 Note: Cross out word or words which do not apply

5. A..... set in conc/rock has been placed/found, bearing.....
 Note: Cross out word or words which do not apply

6. A..... set in conc/rock has been placed/found, bearing.....
 Note: Cross out word or words which do not apply

7. A..... set in conc/rock has been placed/found, bearing.....
 Note: Cross out word or words which do not apply

8. Action required:.....

SUPPLEMENTARY CONNECTIONS


4. A..... set in conc/rock has been placed/found, bearing.....
 Note: Cross out word or words which do not apply

5. A..... set in conc/rock has been placed/found, bearing.....
 Note: Cross out word or words which do not apply

6. A..... set in conc/rock has been placed/found, bearing.....
 Note: Cross out word or words which do not apply

7. A..... set in conc/rock has been placed/found, bearing.....
 Note: Cross out word or words which do not apply

8. Action required:.....

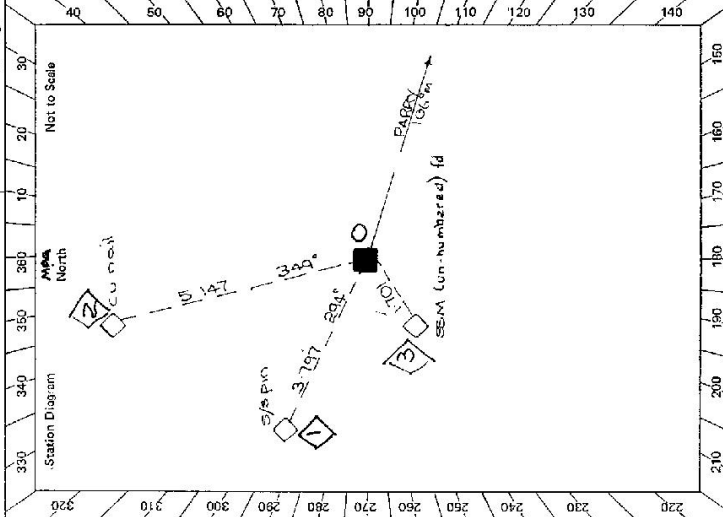

Mark	Direction	Horiz. Distance	Height Difference	Mark	Direction	Horiz. Distance	Height Difference
PIGEON (481-0)	0° 00' 00"	✓	above standpt.	PIGEON (481-0)	0° 00' 00"	✓	above standpt.
COO-WOOD (4676-0)	149° 01' 52"	✓	below standpt.	YARRAMAN (6741-2)	98° 44' 00"	4.354	above standpt.
PARRY (4712-0)	173° 13' 21.5"	✓	below standpt.	YARRAMAN (6741-0)	176° 56' 00"	3.197	above standpt.
YARRAMAN (5143)	302° 28'	1.701	below standpt.	YARRAMAN (6741-3)	208° 01' 30"	3.124	below standpt.
			below standpt.	YARRAMAN (6741-4)	225° 34' 15.5"		below standpt.
			below standpt.				below standpt.
			below standpt.				below standpt.
			below standpt.				below standpt.

STANDPOINT: ABOVE PILLAR PLATE / ABOVE THE PIGEON

Prepared by: D. HALLS

Checked: M. G. J. O'NEILL 15.3.83

Checked


GS 24

STATION **YARRAMAN C.S. PILLAR JS 6741**

Owner's Name: **AMARAJI, H. R. CARTER**
 Government Occupant: **AMARAJI, H. R. CARTER**
 Address: **AMARAJI, H. R. CARTER**
 Phone: **AMARAJI, H. R. CARTER**

ACCESS

Access Report of 28/11/1981 was found suitable/unsuitable
 0-0 BLACKVILLE PO HEAD WEST ALONG GRAVEL ROAD TOWARDS 'YARRAMAN'.
 6-1 TURN LEFT SIGN POST 'COOJAGARRAMAN 100'.
 7-1 CAUSEWAY
 7-3 TURN LEFT SIGN POST: "YARRAMAN CREEK ROAD".
 8-6 GRID.
 9-8 (OWNER'S HOUSE ON LEFT SIGN POST "AMARAJI").
 10-0 GRID
 11-6 GRID
 12-6 TURN LEFT OFF MAIN ROAD.
 12-7 THROUGH DOUBLE IRON GATES + TURN RIGHT ALONG FENCE.
 13-1 CROSS CREEK.
 13-2 TURN LEFT + CROSS GULLY (FOLLOWS TRACK).
 13-8 THROUGH IRON GATE + TURN LEFT FOLLOWING FARM TRACK ALONG FENCE LINE.
 14-4 TURN RIGHT AT BEND IN FENCE + FOLLOW DOZED TRACK UP GULLY. (FOLLOWS TRACK).
 16-6 AT TOP OF RISE - USEC LEFT ALONG SLOPE CUTTING.
 16-7 AT END OF CUTTING TURN RIGHT UP ROCKY SLOPE TO TRIG.
 16-8 YARRAMAN C.S. PILLAR.

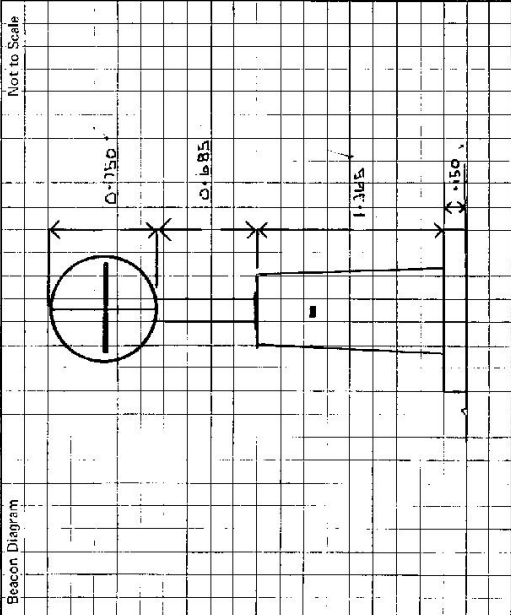

This section to be completed by officer constructing pillar.

Original station mark found/~~not found~~.

Description of mark: **CONCRETE PILLAR PLACED**

Original beacon found/~~not found~~.

Description of beacon: **CONCRETE PILLAR PLACED**

Height Top of Vanes to Top Mark: **2.375** m.

Height of mark: **0.160** m. above G.L. below

Diameter of Vanes: **0.175** m. Height of Cairn: **0.150** m.

Original Beacon has/~~been~~ been destroyed by me.

Date	Record of Station
21 AUG 1981	CONCRETE PILLAR PLACED