


TS 6743
No.: 1530

STATION: DALL KILLY G.S.
MAP SHEET SCALE 1:250 000
INSPECTED BY: L. HITCHINGS
AUTHORITY: C.M.A.

DATE: 22.7.81
FIELD BOOK: CM124

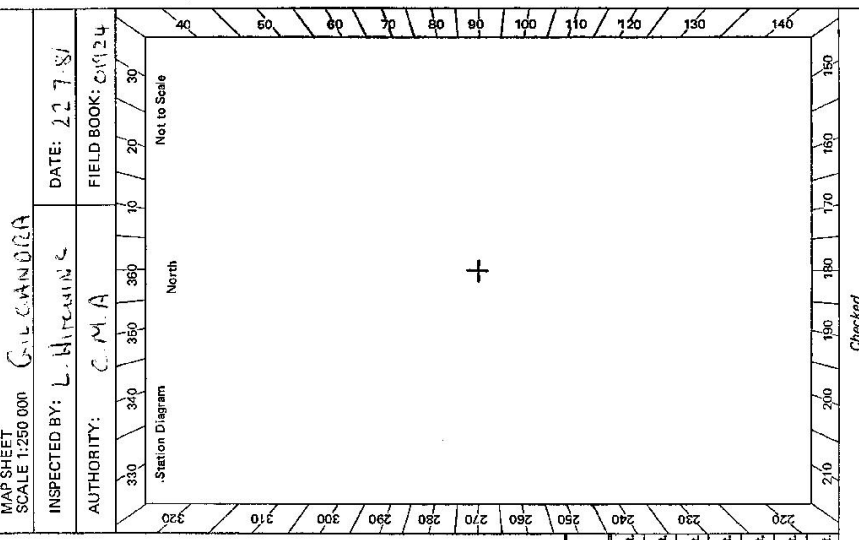

CENTRAL MAPPING AUTHORITY
GEODETTIC SURVEY OF N.S.W.
GEODETTIC STATION RECONNAISSANCE and MAINTENANCE REPORT

Description:
 1. Cleared by lanes bearing.....
 2. Mast & Vanes have been painted white & black respectively.
 3. The station/pillar was unpiled/not unpiled/constructed on.....19....., dimensions now being:
 Description of mark.....should be explicit, e.g., S/Steel Pillar Plate, Steel plug, Brass plug, Bolt, G.I. Pipe
 Height of mark.....m. above rock/concrete; Mark is.....m. above G.L.
 Height of Top Vanes to Top Mark/Pillar plate.....m. Diameter of Vanes (vertical).....m.
 Height of Cairn.....m. Diameter of Cairn.....m. Name Plate found/not found/placed.
 Length of Mast.....m. (approximate if not unpiled)
 4. A.....set in conc/rock has been placed/found, bearing.....° M from Mast/Plug/Pillar
 5. A.....set in conc/rock has been placed/found, bearing.....° M from Mast/Plug/Pillar
 6. A.....set in conc/rock has been placed/found, bearing.....° M from Mast/Plug/Pillar
 7. A.....set in conc/rock has been placed/found, bearing.....° M from Mast/Plug/Pillar
 8. Action required:.....

STANDPOINT: BRASS TRIG P.L.C.				STANDPOINT:			
Mark	Direction	Horiz. Distance	Height Difference	Mark	Direction	Horiz. Distance	Height Difference
LOW CROWN TELECOM TOWER @ 0000			above standpt.				above standpt.
PILGRIM G.S.	84 32 SE		above standpt.				above standpt.
ASTRO PILLAR	122 03 55	4.650	below standpt.				above standpt.
CAMPBELL MARK	215 57 30	5.523	below standpt.				below standpt.
G.I. PIPE	305 01 30	2.798	below standpt.				below standpt.
FRIEND G.S. (P)	307 55 35		above standpt.				above standpt.

Prepared by:
 Checked:
 Noted on U.T.M. Card

St: 2733-2 D. West, Government Printer

STATION **DILL KILLY C.S. (P)** TS **6743**

Owner's Name: **TRIG. RESERVE**
 Address: **D. WEST, G.S.**
 Phone:


Current Occupant: **LEONARD RICHARD HESKETH**
 Address: **"ACCOMMODATION" MENDOGORAN**
 Phone:

ACCESS **21-8-1981**

Access Report of **17.5.1977** was found **suitable/unsuitable**.
 0.0 GILCANDRA - COONABARABRAN, TORAWENAT - MENDOGORAN CROSS READS **54.29**
 5th WEST OF COONABARABRAN ON HIGHWAY HEAD EAST ON MENDOGORAN ROAD.
 7.67 TURN RIGHT OFF GRAVEL FOLLOW TRACK ACROSS CREEK
 7.99 TURN RIGHT BEFORE DOUBLE IRON GATES AND FOLLOW LANE
 8.94 THROUGH GATE AND TURN LEFT FOLLOW TRACK ALONG FENCE.
 9.12 VEER RIGHT
 9.15 VEER LEFT ALONG EDGE OF TIMBER (STRAIGHT AHEAD TO OWNERS HOUSE)
 9.64 THROUGH GATE FOLLOW TRACK STRAIGHT AHEAD
 10.98 TURN RIGHT AND FOLLOW WHEEL MARKS AROUND HILL
 11.37 VEER LEFT AND FOLLOW AND WALK UP TRACK ON LEFT
 11.63 STOP TRACK IN SADDLE AND WALK TO TRIG
 5 MIN WALK TO TRIG

ALTERNATIVE ACCESS TO OWNERS HOUSE

67.09 KM FROM COONABARABRAN ON GILCANDRA RD
 TURN LEFT AND FOLLOW TRACK THEN VEER LEFT
 AND TAKE FIRST TRACK ON RIGHT
 NAME OF OWNERS PROPERTY "MOUNTAIN VIEW" /

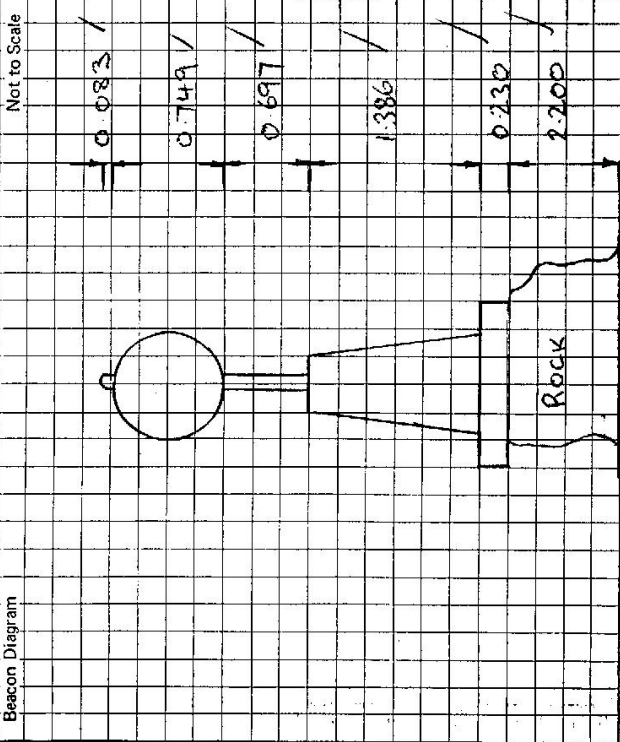

This section to be completed by officer constructing pillar.

Original station mark found/~~not found~~.
 Description of mark: **BRASS TRIG. PIN IN CONC** /

Original beacon found/~~not found~~.
 Description of beacon: **CAIRN POLE + DISCS** /

Height Top of Varies to Top Mark: **APPROX 3.365** m.
 above **0.051** m. below **2.052** m. G.L.

Diameter of Varies **0.911** m. Height of Cairn **1.460** m.

Original Beacon has/~~has not~~ been destroyed by me.

Date	Record of Station