

NOW KNOWN AS: BALALEBUAN

GEODETIC SURVEY OF M.S.W.

CENTRAL MAPPING AUTHORITY

GEODETIC STATION RECONNAISSANCE and MAINTENANCE REPORT

Description:

- Note: Cross out word or words which do not apply*
1. Cleared by ^{ing required} ~~hand-bearing~~ *knock down all surrounding stand trees except the large stand of etc.* from Trig. Mast
 2. Mast & Vanes have been painted white & black respectively.
 3. The station/pillar was unpiled/not unpiled/constructed on 19....., dimensions now being:

Description of mark.....should be explicit, e.g., S/Steel Pillar Plate, Steel plug, Brass plug, Bolt, G.I. Pipe

Height of mark.....m. ^{above} ~~below~~ rock/concrete; Mark is.....m. ^{above} ~~below~~ G.L.

Height of Top Vanes to Top Mark/Pillar plate.....m. Diameter of Vanes (vertical).....m.

Height of Cairn.....m. Diameter of Cairn.....m. Name Plate found/not found/placed.

Length of Mast.....m. ~~Approximate if not unpiled~~

4. A..... set in conc/rock has been placed/found, bearing.....° M from Mast/Plug/Pillar

5. A..... set in conc/rock has been placed/found, bearing.....° M from Mast/Plug/Pillar

6. A..... set in conc/rock has been placed/found, bearing.....° M from Mast/Plug/Pillar

7. A..... set in conc/rock has been placed/found, bearing.....° M from Mast/Plug/Pillar

8. Action required: *Construct pillar. Place 2 red marks. Clear trees on intermediate ridge on line to Gundabri. See report for details.*

STANDPOINT: Site 'A'

STATION: *Site "A" (444-889)* No: 6745

MAP SHEET SCALE 1:250 000

INSPECTED BY: C. ZAHARA

DATE: 16/7/17

AUTHORITY: CMR, NSW 229

FIELD BOOK: 1892

Station Diagram M North

Not to Scale

Checked

Prepared by: C. Zahara

Checked

Notes on U.T.M. Card

STATION: *Site "A" (444-889)* No: 6745

MAP SHEET SCALE 1:250 000

INSPECTED BY: C. ZAHARA

DATE: 16/7/17

AUTHORITY: CMR, NSW 229

FIELD BOOK: 1892


Station Diagram M North

Not to Scale

Checked

Prepared by: C. Zahara

Checked

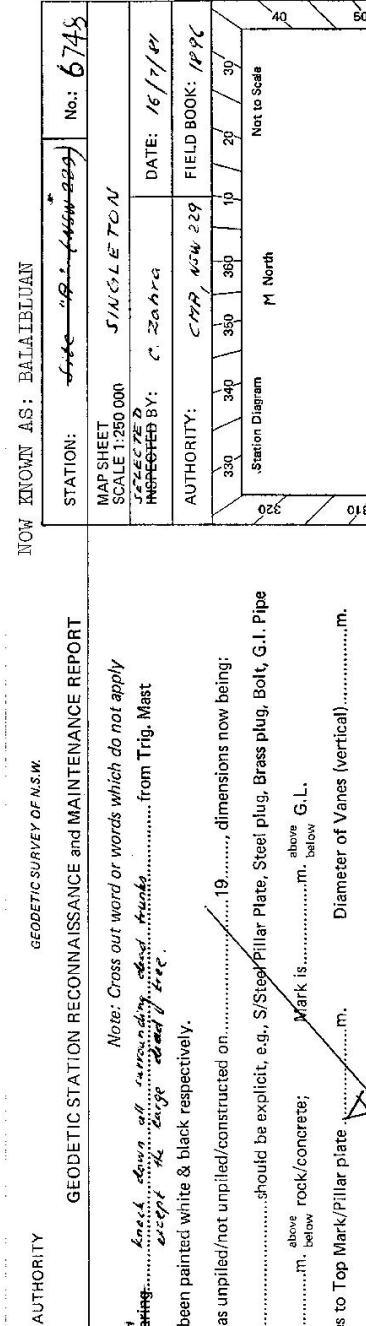

Mark	Direction	Horiz. Distance	Height Difference	Mark	Direction	Horiz. Distance	Height Difference
Balkan	0 00 00		above standpt	Henderson	157 18 06		above standpt
Arthur	9 04 33		above standpt	Henderson	203 30 46		above standpt
Denman N. Pt.	40 47 24		above standpt	Myialungh	228 43 38		above standpt
Ogilvie	22 45 11		above standpt	Myal (approx)	300		above standpt
Dangar	74 24 22		above standpt	Roscoe	341 26 07		above standpt
Gundabri approx	143 55		above standpt	Twin dead trunk	182		above standpt
Watt	144 41 00		above standpt	Large dead tree	172 30		above standpt

ST 2753-1

GS 24

STATION **Balaibuan 6748***

Access owner: Owen Wallace (McQuinn's Co.)
 Current Occupant: Springfield
 Address: Springfield, P.O. Box 2291
 Phone: (049) 61 55 24
 Phone: through GUNDEL Exchange
 Phone: through GUNDEL Exchange
LOCKED GATE - See Access owner

km	Notes
19.6	Access Report of 10/10/10 - was found suitable for use.
20.0	Sandy hollow PO., head towards Meruma
21.8	Turn Right, over grid onto bitumen Rd. (Sign "Pretty Bend Farm")
25.1	Over grid, end of bitumen
19.6	"Springfield" on right. Colored keys for locked gate (at 22.4)
20.2	over grid
21.8	take left fork
22.4	through locked gate
25.7	through gate
26.0	Turn right, over grid & pass old house/road on right, then turn left to gully
26.1	Gully string, follow track up ridge
26.4	Take Right fork
26.75	Through gate, continue with fence on left
27.1	cross small gully, turn Right up spur
27.55	on top of spur see left & continue along top of ridge
28.85	through iron gate at Junction of fences, continue up ridge with fence on left
29.3	Pass small shed & yards, veer Right, continue at 10:45 down to gate
29.3	through gate, then down to gully
29.4	cross gully, veer Right & continue at abt 130:00 to top of grassy hill & GS with a
30.8	GS side "P"

This section to be completed by officer constructing pillar.

Original station mark found/not found.

Description of mark:

Original beacon found/not found.

Description of beacon:

Height Top of Vanes to Top Mark:m.

Height of mark:m. above G.L. below

Diameter of Vanes:m. Height of Cairn:m.

Original Beacon has/not been destroyed by me.

Date	Record of Station
	Permissions for pillar/ access obtained from access owner (16/7/19) and from the owner (by phone 17/7/19)
	for clearing on the site & GUNDEL obtained from MR Angus MARNO of "M.A. GUNDEL" on 18/2/2022

GS 24

STATION Balabulua Conc. obs. Pillar 6748


Owner's Name: Ms. G. Wallace
 Address: 63 Turakull Street
Merevale, Newmarket, N.S.W. 2291
 Phone: (049) 61 5524

Current Occupant:
 Address:
 Phone:

ACCESS

- Access Report of 16/7/1981 was found suitable/unsuitable.
- 0.0 SANDY Hollow Post Office leaved ONWARD MEREVALE
 - 1.8 TURN RIGHT, OVER GRASS AND BITUMEN ROAD, SIGN, PRETTY GOOD FARM.
 - 15.1 OVER GRASS, END OF BITUMEN.
 - 19.6! SPRINGFIELD ON RIGHT, COLLECT KEYS FOR LOCKED GATE AT 22.4 KMS *SEE BELOW.
 - 20.2 OVER GRASS, PARK.
 - 21.8 TAKE LEFT FORK.
 - 22.4! THROUGH LOCKED GATE.
 - 25.7 TURN RIGHT OVER GATE & PASS OLD HOMESTEAD ON RIGHT, THEN TURN LEFT TO GULLY.
 - 26.0 GULLY CROSSING, FOLLOW TRACE UP RIDGE.
 - 26.1 TAKE RIGHT FORK.
 - 26.4 THROUGH GRASS CONTINUE WITH FENCE ON YOUR LEFT.
 - 26.75 CROSS SMALL GULLY TURN RIGHT AND GO UP SLOPE.
 - 27.1 ON TOP OF SLOPE, VEGETATION CONTINUE UP RIDGE WITH FENCE ON LEFT.
 - 28.35 THROUGH IRON GATE AT JUNCTION OF FENCES.
 - 28.85 PASS SMALL SHED & YARDS, VEGETATION CONTINUE UP RIDGE WITH FENCE ON LEFT.
 - 29.3 THROUGH GATE, THEN DOWN TO GULLY.
 - 29.4 CROSS GULLY VEGETATION CONTINUE AT ABOUT 130m. TO TOP GRASSY HILL.
 - 30.8 Balabulua Conc. Pillar.

* 14 November 81. I spoke to Ms. G. Wallace's son Owen and he informed me that he has RENTED out the house at 26.0 kms. While there are people in that house, GATE AT 22.4 KMS WILL NOT BE LOCKED.

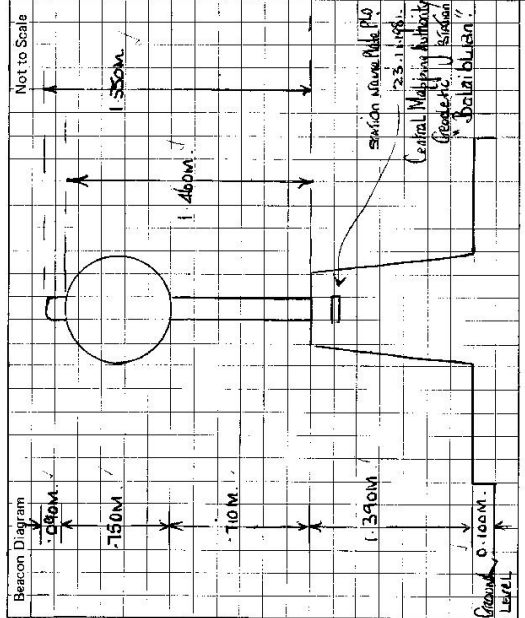

This section to be completed by officer constructing pillar.

Original station mark found/not found. Station

Description of mark:
 Original beacon found/not found. None

Description of beacon:
 Height Top of Vane to Top Markm.
 Height of markm. above G.L.
 below
 Diameter of Vanem. Height of Cairnm.
 Original Beacon has/has not been destroyed by me.

Date	Record of Station