

TS 6750

GEODETIC SURVEY OF N.S.W.

CENTRAL MAPPING AUTHORITY

GEODETIC STATION RECONNAISSANCE and MAINTENANCE REPORT


STATION: LEARD

No.: 2824

MAP SHEET SCALE 1:250 000 MANILLA

INSPECTED BY: G. KEEP DATE: 18/1/81

AUTHORITY: C.M.A. FIELD BOOK:

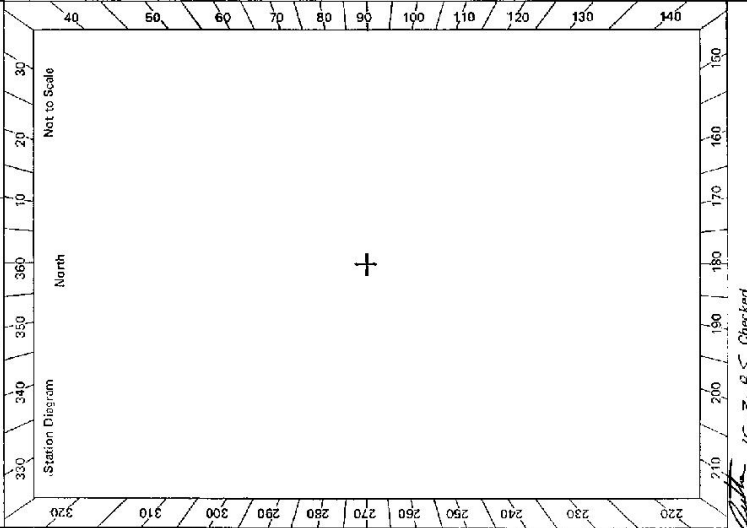

- Description: *Note: Cross out word or words which do not apply*
- Cleared by lanes bearing..... from Trig, Mast
 - ~~Mast & Vanes have been painted white & black respectively.~~
 - The station/pillar was unpiled/not unpiled/constructed on..... 19....., dimensions now being: Description of mark..... should be explicit, e.g., S/Steel Pillar Plate, Steel plug, Brass plug, Bolt, G.I. Pipe Height of mark.....^{above} rock/concrete; Mark is.....^{above} G.L. Diameter of Vanes (vertical).....m. Height of Top Vanes to Top Mark/Pillar plate.....m. Diameter of Cairn.....m. Name Plate: found/not found/placed. Length of Mast.....m. (approximate if not unpiled)
 - A..... SSM n° 1610..... set in conc/rock has been placed/found, bearing.....^{to} M From Mast/Plug/Pillar
 - A..... SSM n° 37724..... set in conc/rock has been placed/found, bearing.....^{to} M From Mast/Plug/Pillar
 - A..... set in conc/rock has been placed/found, bearing.....^{to} M from Mast/Plug/Pillar
 - A..... set in conc/rock has been placed/found, bearing.....^{to} M from Mast/Plug/Pillar
 - Action required: Needs painting black & white, needs clearing in all lanes.....

STANDPOINT:

Mark	Direction	Horiz. Distance	Height Difference	Mark	Direction	Horiz. Distance	Height Difference
			above standpt.				above standpt.
			below				below
			above standpt.				above standpt.
			below				below
Prepared by: Jeff Keep 4/3/81

Checked: King

Noted on U.T.M. Card

GS 24

STATION LEARD TS 6750

Owner's Name:
 Address:
 Phone:
 Current Occupant:
 Address:
 Phone:

ACCESS

Access Report of R. Z. 1981. was found suitable/unsuitable.

km

0.0

3.82

11.55


24.13

25.97

Access
 Boggabri P.O. Take Narrabri Road north from Boggabri
 Turn Right (Manilla Road) (SP) Follow this road and, at
 Turn Left- Maules Creek (signposted). Continue into
 Leard State Forest along main road.
 Turn left at track and follow track to top of hill and trig.
 Leard T.S.

Not to Scale

Beacon Diagram

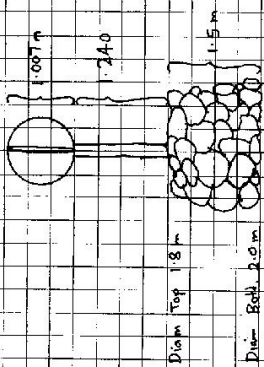

This section to be completed by officer constructing pillar.

Original station mark found/not found.

Description of mark:

Original beacon found/not found.

Description of beacon:

Height Top of Vanes to Top Markm.

Height of markm. above G.L. below rock/conc.m.

Diameter of Vanesm. Height of Cairnm.

Original Beacon has/has not been destroyed by me.

Date

Record of Station

S: 2733-2 D. West, Government Printer Beacon Diagram Not to Scale	STATION LEAY IS 6750	<p>LAND USED BY Current Owner MR. R. B. BURTON Address: "NUMEHAM PARK" MILLPOST C.K. RD. Phone: MANABURAMA IS.</p> <p>Current Occupant: JAIG ASERUVE 20816 Address: NO. 405E OR 405E/12PKY AS AT 6/1/18 Phone: DUNER ON N. SIDE OF FENCE ALAN ADUWARUOS "ROCKVILLE" MANABURAMA IS</p> <p>ACCESS Access Report of 19.12.1981 was found suitable/unsuitable.</p> <p>Feature MANABURAMA PC HEADING SOUTH ON NW WESTERN HWY TURN LEFT "NEVILLE 17 GALLERYMONT II" CROSS RAILWAY LINE WOODEN BRIDGE STRAIGHT AHEAD ON CARVEL ROAD "MILLPOST CK RD." PASS WHITE GATE + GATE ON RIGHT GRID + GATE " " " " TAKE TRACK TO RIGHT CROSS CREEK + GRID "NUMEHAM PARK HS"</p> <p>KM: 6.5 7.05 7.3 7.65 8.0</p> <p>SEE COUNTER ABOUT DRIVE TO ACCESS TO TRIG TOO WET AT TIME OF RECC</p>
		This section to be completed by officer constructing pillar. Original station mark found/not found. Description of mark: Original beacon found/not found. Description of beacon: Height Top of Vanes to Top Mark.....m. Height of mark.....m. above G.L. below Diameter of Vanes.....m. Height of Cairn.....m. Original Beacon has/has not been destroyed by me.
		Date Record of Station

STATION LEARD GS (P) TS 6750	Owner's Name: FARMER, G. G. G. Address: 60 MANAMA LEARD STATE FOREST Phone: 573200	Current Occupant: MISS M. B. B. Address: Phone:	ACCESS Access Report of 27/1/1981 was found suitable/unsuitable. 0 0 BOGARA PO HILL WEN 0 30 TURN RUCHI INTO WEE WIP 3 36 TURN RIGHT SIGN MANILLA 6 28 PASS ROAD ON LEFT VEEL RIGHT 11 29 TURN LEFT SIGN WILLEROY MAULES 14 35 PASS ROAD ON RIGHT SIGN COOPING, DEPTING ROCK 19 21 PASS SIGN LEARD STATE FOREST 24 19 TURN LEFT ONTO TRACK AFTER CREST OF HILL 24 95 PASS TRACK ON RIGHT 25 6 TURN RIGHT 26 00 LEARD GS (P)
Beacon Diagram 		This section to be completed by officer constructing pillar. Original station mark found/feet found: Description of mark: STONE TACK PO Original beacon found/feet found: Description of beacon: CANON POLE + DISK Height Top of Varies to Top Mark: 2.600 m. Height of mark: 0.000 m. above G.L. / 0.000 m. below Diameter of Vases: 0.000 m. / Height of Cairn: 0.000 m. Original Beacon has/has not been destroyed by me.	
		Date	Record of Station

GEODETTIC SURVEY OF M.S.L.M

CENTRAL MAPPING AUTHORITY

GEODETTIC STATION RECONNAISSANCE and MAINTENANCE REPORT

Description:

1. Cleared by lanes bearing $112^{\circ} 00' 00''$ to $162^{\circ} 00' 00''$, $162^{\circ} 00' 00''$ to $192^{\circ} 00' 00''$, $192^{\circ} 00' 00''$ to $225^{\circ} 00' 00''$ from Trig. Mast/Pillar.
 Note: Cross out word or words which do not apply
2. Mast & Vanes have been painted white & black respectively. ✓
3. The ~~station~~ pillar was ~~unpainted~~ ~~constructed~~ ~~on~~ ~~20~~ ~~M.M.A.H.~~ ~~19~~ ~~82~~ dimensions now being: 19.82 m.
 Description of mark: ~~Steel~~ ~~Pillar~~ ~~Plate~~ should be explicit, e.g. S/Steel Pillar Plate, Steel plug, Brass plug, Bolt, G.I. Pipe
 Height of mark: 1.29 m. ^{above} ~~below~~ rock/concrete; Mark is 1.59 m. ^{above} G.L.
 Height of Top Vanes to Top Mast/Pillar plate 1.40 m. Diameter of Vanes (vertical) 155 m.
 Height of Cairn 0 m. Diameter of Cairn 0 m. Name Plate found/~~not found~~/placed.
 Length of Mast 5.30 m. (approximate if not ascertained) C.M.A. Geodetic Station.
 LEARD
4. A $S.S.M.$ No. 1110 set in conc/rock has been ~~placed~~/found, bearing $104^{\circ} 00' 00''$ M from Mast/Plug/Pillar
5. A $S.S.M.$ No. 37724 set in conc/rock has been ~~placed~~/found, bearing $67^{\circ} 00' 00''$ M from Mast/Plug/Pillar
6. A $S.S.M.$ No. 1110 set in conc/rock has been ~~placed~~/found, bearing $117^{\circ} 00' 00''$ M from Mast/Plug/Pillar
7. A $S.S.M.$ No. 1110 set in conc/rock has been ~~placed~~/found, bearing $117^{\circ} 00' 00''$ M from Mast/Plug/Pillar
8. Action required:

STANDPOINT:

Mark	Direction	Horiz. Distance	Height Difference	Mark	Direction	Horiz. Distance	Height Difference
			above standpt				above standpt
			below				below
			above standpt				above standpt
			below				below
Prepared by:

Checked:

Noted on U.T.M. Card

Sr: 2733-1

STATION: LEARD Conc. obs. Pillar. No: 6750


MAP SHEET SCALE 1:250 000

INSPECTED BY: D. J. KNOX

DATE: 20 March 1982

AUTHORITY: C.M.A.

FIELD BOOK: 1932

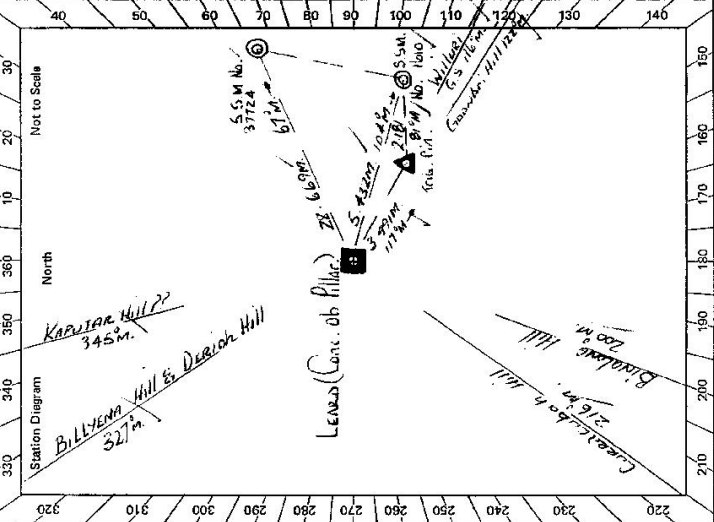


Checked

STATION LEARD CONCRETE OBSERVATION PILLAR 6750

Owner's Name: Forestry Commission, Gunnedah Current Occupant:
 Address: Contract Mr. Brian Kennedy Address:
N.S.W. Forestry Office, Abbott Street Phone:

Access Report of 3 9 81 was found suitable/unsuitable.

- KLMS
- 0.30 Turn Right into WAA Street
 - 3.86 Turn Right Sign MANILLA
 - 11.69 Turn Left Sign Willowby Mangles
 - 14.55 Pass Road on Right Sign Loggion, Drifting Rock
 - 19.21 Pass Sign LEARD STATE FOREST
 - 24.19 Turn Left onto track above crest of hill
 - 24.95 Pass track on Right
 - 25.60 Turn Right
 - 26.00 LEARD Concrete observation pillar.

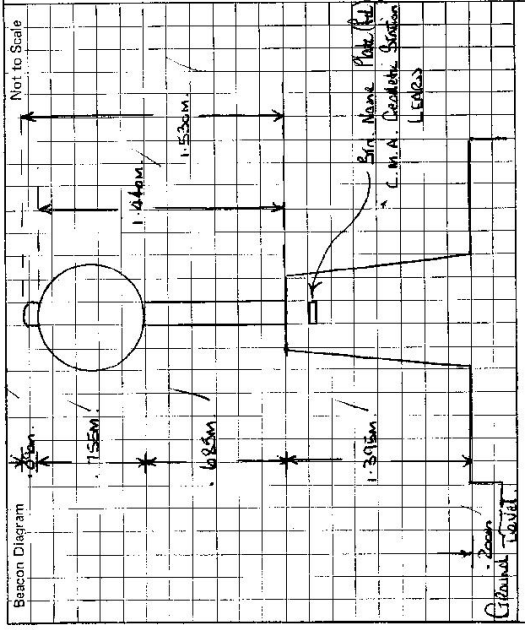

This section to be completed by officer constructing pillar.

Original station mark found/.....

Description of mark:

Original beacon found/not found.

Description of beacon:

Height Top of Vane to Top Mark:m.

Height of mark:m. above G.L.
 below rock/cont.m. below G.L.

Diameter of Vane:m. Height of Cairnm.

Original Beacon has/has not been destroyed by me.

Date	Record of Station