

TS 6751

GEODETTIC SURVEY OF M.S.W.

CENTRAL MAPPING AUTHORITY

GEODETTIC STATION RECONNAISSANCE and MAINTENANCE REPORT

Description: *Note: Cross out word or words which do not apply*


1. Cleared by lanes bearing..... from Trig, Mast
2. Mast & Vanes have been painted white & black respectively.
3. The station/pillar was unpainted/rot unpainted/constructed on..... 19....., dimensions now being: Description of mark..... should be explicitly, eg, S/Steel Pillar Plate, Steel plug, Brass plug, Bolt, G.I. Pipe
- Height of mark.....m. above below rock/concrete; Mark is.....m. above below
- Height of Top Vanes to Top Mark/Pillar plate.....m. Diameter of Vanes (vertical).....m.
- Height of Cairn.....m. Diameter of Cairn.....m. Name Plate found/not found/placed.
- Length of Mast.....m. (approximate if not unplaced)
4. A..... set in conc/rock has been placed/found, bearing.....°M from Mast/Plug/Pillar
5. A..... set in conc/rock has been placed/found, bearing.....°M from Mast/Plug/Pillar
6. A..... set in conc/rock has been placed/found, bearing.....°M from Mast/Plug/Pillar
7. A..... set in conc/rock has been placed/found, bearing.....°M from Mast/Plug/Pillar

8. Action required: *REPAIR TO BE CONSIDERED. WILL TO BE CLEARED FOR M.S.W. STATION STANDPOINT. PERMISSION HAS BEEN OBTAINED AND CLEARANCE.*

Mark	Direction	Horiz. Distance	Height Difference	Mark	Direction	Horiz. Distance	Height Difference
			above standpt.				above standpt.
			below standpt.				below standpt.
			above standpt.				above standpt.
			below standpt.				below standpt.
Prepared by: *924-1781* Checked: *Noted on U.T.M. Card*

SR 2733-1

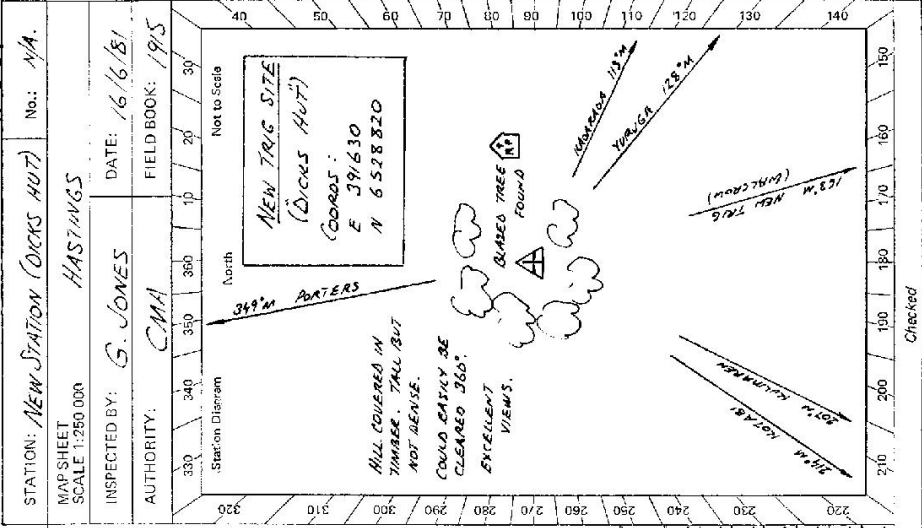

CENTRAL MAPPING AUTHORITY

GEODETIC SURVEY OF M.S.W. GEODETIC STATION RECONNAISSANCE and MAINTENANCE REPORT


Description: Note: Cross out word or words which do not apply

- 1. Cleared by lanes bearing $270^\circ - 240^\circ$ M
- 2. Mast & Vanes have been painted white & black respectively. ✓
- 3. The station/pillar was ~~reconstructed~~ constructed on 19.5×19.5 m, dimensions now being:
 Description of mark: ~~mark~~ should be explicit, e.g., S/Steel Pillar Plate, Steel plug, Brass plug, Bolt, G.I. Pipe
 Height of mark: 1.372 m, above ~~base~~ concrete; Mark is 1.495 m, above G.I.
 Height of Top Vanes to Top ~~mark~~ Pillar plate ... 1.433 m. Diameter of Vanes (vertical) ... 1.36 m.
 Height of ~~Cairn~~ m. Diameter of ~~Cairn~~ m. Name Plate ~~found/not found/placed~~.
 Length of Mast ... m. (approximate if not unpeeled)
- 4. A ~~concrete~~ ~~mark~~ set in conc/rock has been placed/~~found~~, bearing 331° M from ~~Mast/Plug/Pillar~~
- 5. A ~~C.I. Pipe~~ set in conc/~~rock~~ has been placed/~~found~~, bearing 43° M from ~~Mast/Plug/Pillar~~
- 6. A set in conc/rock has been placed/~~found~~, bearing 0° M from Mast/Plug/Pillar
- 7. A set in conc/rock has been placed/~~found~~, bearing 0° M from Mast/Plug/Pillar
- 8. Action required: ~~Mark~~ ~~to~~ ~~be~~ ~~found~~ ~~to~~ ~~be~~ ~~found~~

STANDPOINT: <u>Range Pole</u>				STANDPOINT: <u>Cover Mail</u>			
Mark	Direction	Horiz. Distance	Height Difference	Mark	Direction	Horiz. Distance	Height Difference
Pillar P	0 00 00		above standpt	Pillar P	0 00 00		above standpt
G.I. Pipe	60 07 03	2.718	above standpt	BRASS BRASS P	73 06 50		above standpt
BRASS BRASS P	73 07 00		below	G.I. Pipe	114 05 20	3.645	below
Keystone Fur Tower	134 16 00		above standpt	Keystone Fur Tower	134 15 30		above standpt
Muskele P	153 17 40		below	Muskele P	153 17 35		below
Muskele P	250 24 10		below	Pillar Plate	160 26 30	3.037	below
Cover Mail	340 28 10	1.130	below	Keystone P	230 28 30		below standpt

Prepared by: ASG

Checked: ASG Noted on U.T.M. Card

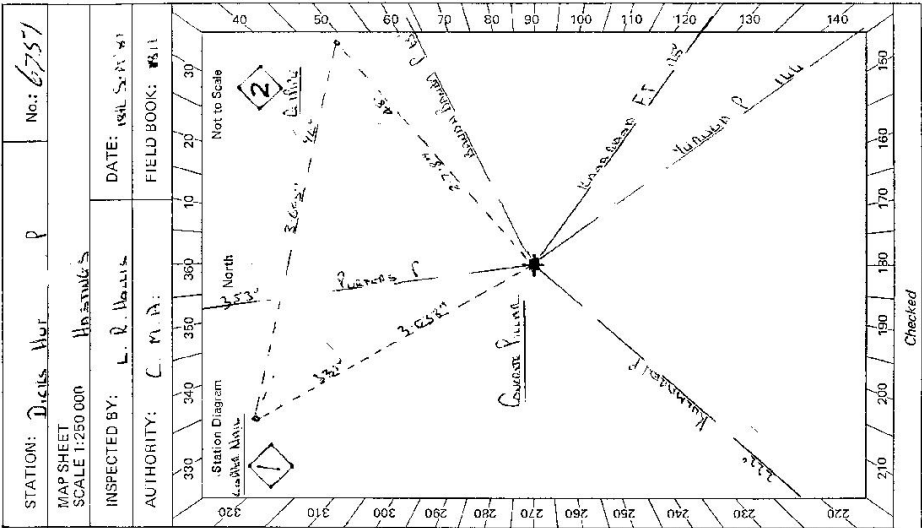

Checked

STATION: Dicks Hill No: 6751

MAP SHEET SCALE 1:250,000

INSPECTED BY: L. R. Housley


AUTHORITY: C.M.A.

DATE: 19th Sept 91

FIELD BOOK: 511

Sr 2793-2 D. West, Government Printer

Beacon Diagram

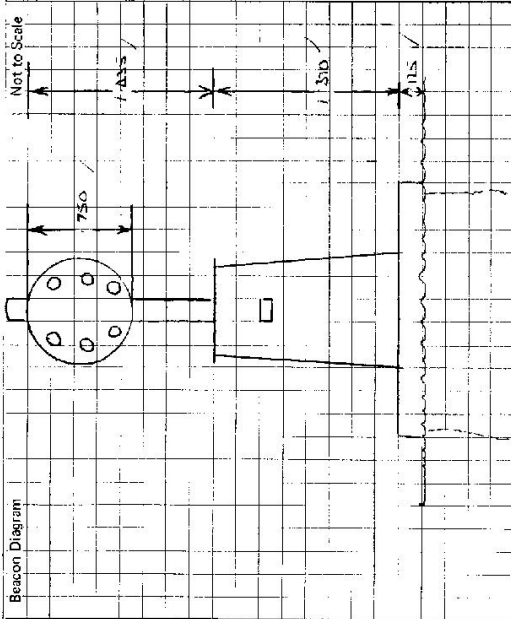

This section to be completed by officer constructing pillar.

Original station mark found/not found.

Description of mark:

Original beacon found/not found.

Description of beacon:

Height Top of Vanes to Top Mark:m.

Height of mark:m. above G.L. below

Diameter of Vanesm. Height of Cairnm.

Original Beacon has/not been destroyed by me.

STATION **Duils Hut, Ruwa TS 6751**

Owner's Name: **Tanaka Construction, Haha...**

Address:

Phone:

Current Occupant: **Tanaka Construction, Haha...**

Address:

Phone:

ACCESS

Access Report of 07/Jan/1981 was found suitable/unsuitable.

- 0 00 Whakara P.O. Tawaia Stn.
- 0 10 Cross Church on Right
- 07 10 Cross Church on Right
- 48 20 Turn Right Side "Snowdon" "Chardons Rd"
- 48 30 Turn Right Side "Upper Harewood"
- 48 70 Turn Left Fork Side "Upper Harewood"
- 49 20 Cross Snowdon Hill on Right
- 50 00 Cross Road on Right
- 59 00 Gate & Shed "Empire Stone Farm"
- 59 10 Cross Forester's Hut on Left
- 60 05 Turn Right Road "Empire Stone Farm"
- 61 20 Cross "Daisy Hill" Forest Rd on Left
- 64 40 Cross Road & Dam on Right
- 67 30 Cross Double Dike Rd on Left, to Dike that has Turn on Right
- 68 30 Turn Right at Barrie on Hill "Whiro White"
- 70 35 Turn Right " "
- 71 60 Geostatic Station

Good Track to Tebe.

Date

Record of Station