


13 6756  
No: 1605

STATION: COOLBAGGIE GS  
MAP SHEET SCALE 1:250 000  
INSPECTED BY: G JONES  
AUTHORITY: CMA

DUBBO  
DATE: 23-6-81  
FIELD BOOK: 1915

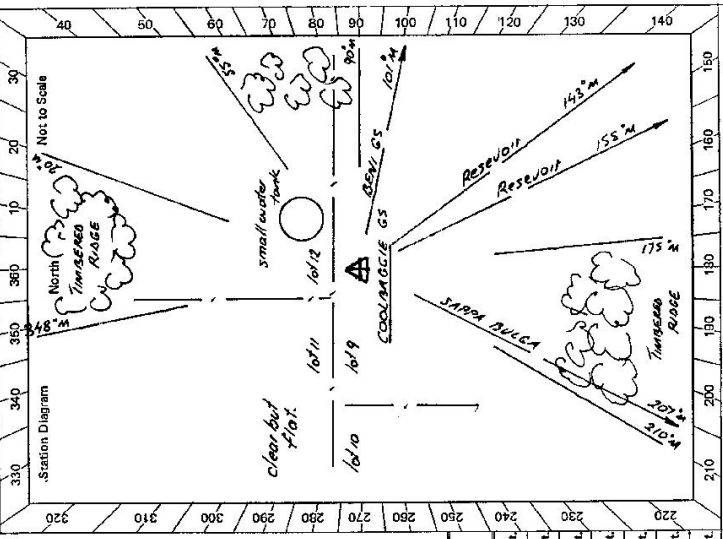

GEODETTIC STATION RECONNAISSANCE and MAINTENANCE REPORT

Description: Note: Cross out word or words which do not apply

1. Cleared by lanes bearing..... SEE DIAGRAM..... from Trig. Mast
2. Mast & Vanes have been painted white & black respectively.
3. The station/pillar was unpiled/not unpiled/constructed on..... 19....., dimensions now being:  
Description of mark..... should be explicit, e.g., S/Steel Pillar Plate, Steel plug, Brass plug, Bolt, G.I. Pipe  
Height of mark.....m. above rock/concrete; Mark is.....m. above G.L.  
Height of Top Vanes to Top Mark/Pillar plate.....m. Diameter of Vanes (vertical).....m.  
Height of Cairn.....m. Diameter of Cairn.....m. Name Plate found/not found/placed.  
Length of Mast.....m. (approximate if not unpiled)
4. A..... set in conc/rock has been placed/found, bearing.....° M from Mast/Plug/Pillar
5. A..... set in conc/rock has been placed/found, bearing.....° M from Mast/Plug/Pillar
6. A..... set in conc/rock has been placed/found, bearing.....° M from Mast/Plug/Pillar
7. A..... set in conc/rock has been placed/found, bearing.....° M from Mast/Plug/Pillar
8. Action required: *Owner to be contacted regarding construction of pillar. No clearing at this stage.*

STANDPOINT:

Mark	Direction	Horiz. Distance	Height Difference	Mark	Direction	Horiz. Distance	Height Difference
			above standpt				above standpt
			below				below
			above standpt				above standpt
			below				below
Prepared by: *92-1-101/81* Checked: *4 funds 21.7.81* Noted on U.T.M. Card


GS 24

STATION **COOLBAGGIE TS-6756**

Owner's Name: "TERRAMUNGAMINE"  
 Address: SUBDIVISION LOT 9  
 Phone: .....  
 Current Company: MR P.G. MCKEAN  
 Address: SANDERSON ST  
 Phone: 824452  
 ACCESS 23-6-1981

Access Report of 15/18/75 was found suitable.  
 0-0 Railway crossing in Dubao on the Newell Highway towards Gilgandra.  
 0-15 Turn right sign "Gilgandra"  
 0-35 Turn left sign "Gilgandra"  
 7-5 at BROCKLEHURST. Turn left sign "Teramungamine 6 Burroway 43"  
 13-85 Teramungamine homestead on left.  
 15-6 Turn left over grid, Furney's road.  
 16-05 Turn left through iron gate.  
 Follow fence to fence intersection and Δ

(2nd all weather access)

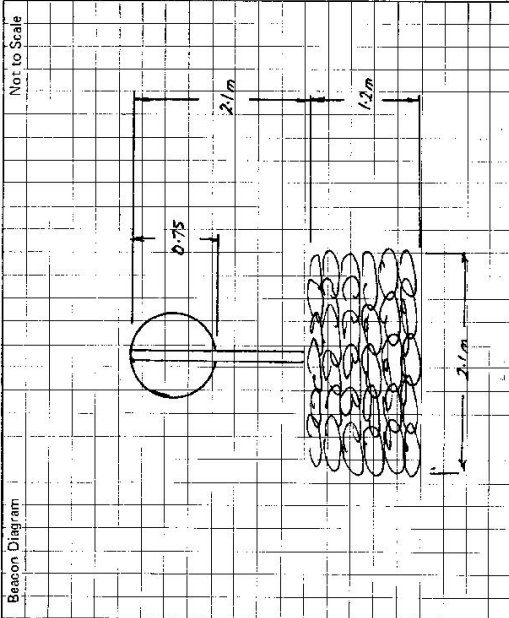

This section to be completed by officer constructing pillar.  
 Original station mark found/not found.  
 Description of mark: .....  
 Original beacon found/not found.  
 Description of beacon: .....  
 Height Top of Vanes to Top Mark .....m.  
 Height of mark .....m. above rock/stone .....m. below G.L.  
 Diameter of Varies .....m. Height of Cairn .....m.  
 Original beacon has/has not been destroyed by me.

Date	Record of Station

CENTRAL MAPPING AUTHORITY

GEODETIC SURVEY OF N.S.W.

GEODETIC STATION RECONNAISSANCE and MAINTENANCE REPORT

Description:

Note: Cross out word or words which do not apply

1. Cleared by lances bearing..... from Trig. Mast
2. Mast & Vanes have been painted white & black respectively. ✓
3. The ~~station~~/pillar was ~~used~~/constructed on 16th September 1981, dimensions now being: 1.395 m. above ~~rock~~/concrete; Mark is 1.545 m. above G.L.
4. A BRASS TRIG. PLUG set in ~~conc~~/rock has been ~~found~~/found, bearing 284 °M from ~~Mast/Plug~~/Pillar
5. A G.I. PIPE set in ~~conc~~/rock has been placed/~~found~~, bearing 193 °M from ~~Mast/Plug~~/Pillar
6. A ..... set in ~~conc~~/rock has been placed/~~found~~, bearing ..... °M from Mast/Plug/Pillar
7. A ..... set in ~~conc~~/rock has been placed/~~found~~, bearing ..... °M from Mast/Plug/Pillar
8. Action required: .....

STANDPOINT: <u>Conc Obs here</u>				STANDPOINT: <u>BRASS TRIG PLUG</u>			
Mark	Direction	Horiz. Distance	Height Difference	Mark	Direction	Horiz. Distance	Height Difference
Dubbo Res (C)	0 00 00		above standpt	Dubbo Res (SP)	0 00 00		above standpt
G.I. PIPE	07 33 20	15.400	above standpt	G.I. PIPE	29 07 05	17.005	below standpt
MINORE (C)	0 35 35		below	MINORE (C)	0 35 30		below
BRASS TRIG PLUG	04 40 40	5.965	above standpt	BENI (C)	316 26 50		above standpt
BENI (C)	316 25 40		below	BRASS TRIG PLUG	324 41 30	5.966	above standpt
TOWER	331 51 20		above standpt	TOWER	331 52 20		below

Prepared by: P.B.T. 29th September 81. Checked: P.B.T. Noted on U.T.M. Card

S. 2733-1

STATION: COOLGARRIE (S.S.P) No.: 6756  
 MAP SHEET SCALE 1:250 000 Dubbo  
 INSPECTED BY: P.B.T. DATE: 18.9.81  
 AUTHORITY: CM A. FIELD BOOK: 01925

Station Diagram  
 Not to Scale  
 Checked

GS 24


STATION (Cool Base/E GTC) TS- 6756

Owner's Name: *Lot 9 TERRAMUNGAMINE*  
 Address: *Siddons*  
 Phone: *02 4433*

Current Occupant: *Mr. P.G. McKEAN*  
 Address: *SANDERSON ST*  
 Phone: *02 4433*

ACCESS

Access Report of 18/9/1981 was found suitable/unsuitable.  
 FEATURE  
 4.00 KM. *KEY OFFICE DUNDS HEAD NORTH EAST ON ALBUQUARIE STREET*  
 0.20 *UNDER RAIL LINE BRIDGE ERSKINE STREET*  
 0.35 *TURN RIGHT INTO ERSKINE STREET*  
 1.05 *TURN LEFT SIGN BULGANDRA*  
 8.08 *TURN LEFT OVER TERRAMUNGAMINE, BARRANAY ROAD*  
 17.14 *TURN LEFT OVER GUYA SIGN, KURNEY'S ROAD*  
 17.71 *TURN LEFT OVER TERRA ROAD*  
 17.06 *(CLOCKWISE GTC)*

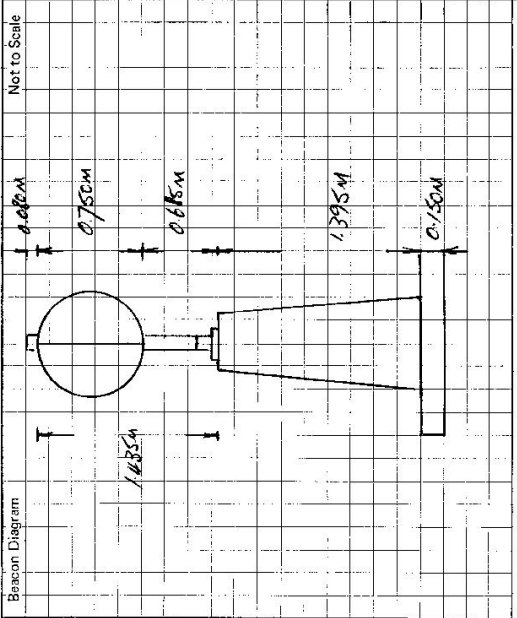

This section to be completed by officer constructing pillar.

Original station mark found/~~replaced~~.  
 Description of mark: *BANKS TRIG PUG*  
 Original beacon found/~~replaced~~.  
 Description of beacon: *CAIRN PILE & DISC*  
 Height Top of Vanes to Top Mark: *3.370* m.  
 Height of mark: *0.050* m. above rock/~~base~~ below / above G.L.  
 Diameter of Vanes: *0.165* m. Height of Cairn: *1.470* m.  
 Original Beacon has/has not been destroyed by me.

Date	Record of Station

CENTRAL MAPPING AUTHORITY

GEODETIC SURVEY OF N.S.W.

GEODETIC STATION RECONNAISSANCE and MAINTENANCE REPORT

Description: Note: Cross out word or words which do not apply

- Cleared by lanes bearing..... from Trig. Mast
- Mast & Vanes have been painted white & black respectively.
- The station/pillar was unpiled/not unpiled/constructed on..... 19....., dimensions now being: Description of mark..... should be explicit, e.g., S/Steel Pillar Plate, Steel plug, Brass plug, Bolt, G.I. Pipe  
Height of mark.....m. above below rock/concrete; Mark is.....m. above G.L.  
Height of Top Vanes to Top Mark/Pillar plate.....m. Diameter of Vanes (vertical).....m.  
Height of Cairn.....m. Diameter of Cairn.....m. Name Plate found/not found/placed.  
Length of Mast.....m. (approximate if not unpiled)
- A..... set in conc/rock has been placed/found, bearing.....°M from Mast/Plug/Pillar
- A..... set in conc/rock has been placed/found, bearing.....°M from Mast/Plug/Pillar
- A..... set in conc/rock has been placed/found, bearing.....°M from Mast/Plug/Pillar
- A..... set in conc/rock has been placed/found, bearing.....°M from Mast/Plug/Pillar

8. Action required:.....

STANDPOINT: CONCRETE PILLAR (6756-0) STANDPOINT: G.I. PIPE IN CONC FOUND (6756-3)

Mark	Direction	Horiz. Distance	Height Difference	Mark	Direction	Horiz. Distance	Height Difference
BENI (6756-0)	0 00 00		above standpt.	BENI (6756-0)	0 00 00		above standpt.
DUBBO (5270-0)	43 29 30Z		above standpt.	DUBBO (5270-0)	53 56 55Z		above standpt.
G.I. PIPE IN CONC FOUND (6756-3)	93 01 50	15.402	below standpt.	G.I. PIPE IN CONC FOUND (6756-3)	224 19 16	22.114	0.192
G.I. PIPE IN CONC FOUND (6756-3)	346 06 50	12.008	below standpt.	PILLAR SPAGOR (6756-0)	166 06 20	12.008	1.634

Prepared by: AA 1985

Checked: Noted on U.T.M. Card

STATION: COOL BAGGIE No.: 6756

MAP SHEETS SCALE 1:250 000 DUBBO

INSPECTED BY: M.L. MARRISON DATE: 22-6-1985

AUTHORITY: CMA FIELD BOOK: C.391

Station Diagram

Not to Scale

North

BENI (6756-0)

DUBBO (5270-0)

G.I. PIPE IN CONC FOUND (6756-3)

PILLAR SPAGOR (6756-0)

Trig. Mast

CONCRETE PILLAR (6756-0)

Direction

Horiz. Distance

Height Difference

STANDPOINT: G.I. PIPE IN CONC FOUND (6756-2)