

GEODETTIC SURVEY OF N.S.W.

CENTRAL MAPPING AUTHORITY GEODETTIC STATION RECONNAISSANCE and MAINTENANCE REPORT

STATION: **BAGDAD** No.: **676**

MAP SHEET SCALE 1:250 000 **RATHUAST**

INSPECTED BY: **A. GARSIDE** DATE: **26-8-81**

AUTHORITY: **C.M.A.** FIELD BOOK: **1987**

Note: Cross out word or words which do not apply

1. Cleared by lanes bearing... **THIS COULD BE BY SURVEYING THE GRASS AND PINES SHOULD BE PAINTED TO CLEAR 300**

2. Mast & Vanes have been painted white & black respectively.

3. The station/pillar was ~~unplied~~ not unplied/constructed on... **2.6**... **19.81**... dimensions now being:

Description of mark... should be explicit, e.g., S/Steel Pillar Plate, Steel plug, Brass plug, Bolt, G.I. Pipe

Height of mark... **2.0**... m. **2.0**... m. **0.9**... m. **0.9**... m.

Height of Top Vanes to Top Mark/Pillar plate ... m. Diameter of Vanes (vertical) ... m.

Height of Cairn... m. Diameter of Cairn... m. Name Plate found/not found/placed.

Length of Mast... m. (approximate if not unplied)

4. A... set in conc/rock has been placed/found, bearing... M from Mast/Plug/Pillar

5. A... set in conc/rock has been placed/found, bearing... M from Mast/Plug/Pillar

6. A... set in conc/rock has been placed/found, bearing... M from Mast/Plug/Pillar

7. A... set in conc/rock has been placed/found, bearing... M from Mast/Plug/Pillar


8. Action required: **OK TO CONSTRUCT PILLAR AND C.A.P.A.**

STANDPOINT:

Mark	Direction	Horiz. Distance	Height Difference	Mark	Direction	Horiz. Distance	Height Difference
			above standpt.				above standpt.
			below standpt.				below standpt.
			above standpt.				above standpt.
			below standpt.				below standpt.
			above standpt.				above standpt.
			below standpt.				below standpt.
			above standpt.				above standpt.
			below standpt.				below standpt.

Prepared by: *[Signature]* 14/10/81 Checked: *[Signature]*

Noted on U.T.M. Card

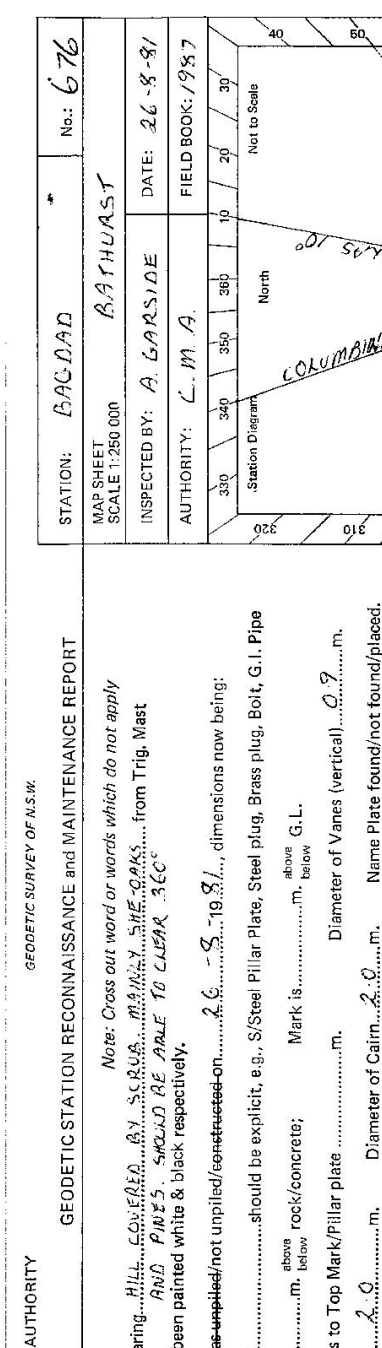

Checked

210 200 190 180 170 160 150

