


CENTRAL MAPPING AUTHORITY

STATION: **TERRAWINDA GS (P)** No.: **6760**

MAP SHEET SCALE 1:250 000 **GILGANDRA**

INSPECTED BY: **L HITCHINS** DATE: **3/11/81**

AUTHORITY: **C.M.A** FIELD BOOK: **1820**

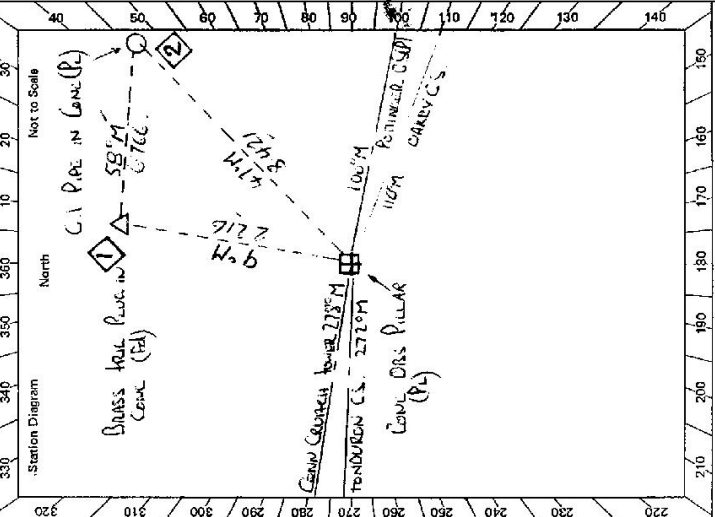

GEODETIC STATION RECONNAISSANCE and MAINTENANCE REPORT

- Description: **360°**
 Note: *Cross out word or words which do not apply*
1. Cleared by lanes bearing **360°** from Trig. Mast
 2. Mast & Vanes have been painted white & black respectively.
 3. The station/pillar was ~~unplaced~~ ^{not omitted} /constructed on **7-9-1981**, dimensions now being: Description of mark **S/S PILLAR** should be explicit, e.g., S/Steel Pillar Plate, Steel plug, Brass plug, Bolt, G.I. Pipe
 Height of mark **1.370** m. ^{above} ~~below~~ **rock/concrete**; Mark is **1.542** m. ^{above} ~~below~~ **G.L.**
 Height of Top Vanes to Top Mark/Pillar plate **1.435** m. Diameter of Vanes (vertical) **0.751** m.
 Height of Cairn **0** m. Diameter of Cairn **0** m. Name Plate ~~found~~ /not found/placed.
 Length of Mast **0** m. (approximate if not upiled)
 4. **BRASS HAIR PILE** set in conc/rock has been placed/found, bearing **90°** M from Mast/Plug/Pillar
 5. **G.I. PIPE** set in conc/rock has been placed/found, bearing **47°** M from Mast/Plug/Pillar
 6. **A** set in conc/rock has been placed/found, bearing **0°** M from Mast/Plug/Pillar
 7. **A** set in conc/rock has been placed/found, bearing **0°** M from Mast/Plug/Pillar
 8. Action required: **BRASS HAIR PILE**

Mark	Direction	Horiz. Distance	Height Difference	Mark	Direction	Horiz. Distance	Height Difference
CONC CHURCH TOWER	0 00 00		above standpt.	CONC CHURCH TOWER	0 00 00		above standpt.
BRASS PILE	91 49 40	2.215	1.447 below standpt.	G.I. PIPE	139 32 30	0.766	0.234 below standpt.
G.I. PIPE	128 18 30	3.421	1.683 below standpt.	ATKINSON CS (P)	183 18 00		above standpt.
POTINGER CS (P)	183 18 00		above standpt.	OAKLEY CS	193 30 50		above standpt.
OAKLEY CS	193 30 50		above standpt.	S/S PILLAR PLATE	271 50 00	2.218	1.448 below standpt.
TONDURON CS	354 07 16		above standpt.	TONDURON	354 06 50		above standpt.

STANDPOINT: **S/S PILLAR PLATE** STANDPOINT: **BRASS HAIR PILE**

Prepared by: *[Signature]* Checked: *[Signature]* Noted on U.T.M. Card

G:

STATION TERRAWINDA G.S. (P) TS 6760	Access Occupant: MR D BIBBY Address: "WOOLSHED CREEK" PURLEWAUGH RO BINNAWAY Phone: BINNAWAY 34	Owner's Name: TR 47880 Address: DURRO LANDS BOARD OFFICE Phone: 068 - 825100	ACCESS Access Report of 27/1/1981 was found suitable/unsuitable. COONJABARABAN. PO HEAD SOUTH ALONG HIGHWAY 34-39 TURN LEFT OPPOSITE SWIMMING POOL EDWARDS STREET. 13.72 TURN RIGHT SIGN "BINNAWAY 35" 14.41 TURN LEFT ONTO DIRT ROAD "SIGN BINNAWAY 34" 24.94 PASS ROAD ON RIGHT SIGN "WILLACOMBS ROAD" 25.18 PASS ROAD ON LEFT SIGN "BROOKS RD3 PURLEWAUGHES" 31.35 TURN RIGHT SIGN "BINNAWAY 17" 36.07 TURN RIGHT OFF ROAD (OWNERS HOUSE NEXT HOUSE ON RIGHT ALONG ROAD) 36.08 THROUGH WIRE GATE, FOLLOW TRACK ALONG FENCE STRAIGHT AHEAD 36.83 THROUGH WIRE GATE IN CORNER, FOLLOW TRACK ALONG FENCE STRAIGHT AHEAD 37.97 VEER LEFT AWAY FROM FENCE AND FOLLOW TRACK AS FAR AS POSSIBLE UP HILL TERRAWINDA G.S. (P) POSSIBLE 3 MIN WALK.	Date Record of Station
Beacon Diagram 		Not to Scale 0.258 0.179 0.684 1.370 0.179		This section to be completed by officer constructing pillar. Original station mark found/ not found . Description of mark: BRASS TRIG PIN Original beacon found/ not found . Description of beacon: CAIRN POLE & DISCS Height Top of Vanes to Top Mark: 6.570 m. Height of mark: 0.258 m. above G.L. / below G.L. Diameter of Vanes: 0.767 m. Height of Cairn: 1.130 m. Original Beacon has/ has not been destroyed by me.