

GEODETTIC SURVEY OF N.S.W.

CENTRAL MAPPING AUTHORITY

GEODETTIC STATION RECONNAISSANCE and MAINTENANCE REPORT

Description:

- Note: Cross out word or words which do not apply*
1. Cleared by lances bearing.....13-65.....67-180.....215-250.....*from Trig. Mast*
 2. Mast & Vanes have been painted white & black respectively. Broken mast & vanes on ground *set 1978 at next re-rod according to record name*
 3. The station/pillar was unpiled/~~not unpiled~~/~~constructed~~ on.....19....., dimensions now being:

Description of mark ~~Base~~ **△ Plug** should be explicit, e.g., S/Steel Pillar Plate, Steel plug, Brass plug, Bolt, G.I. Pipe

Height of mark.....~~3.23~~.....m. ^{above} ~~rock~~/^{below} concrete; Mark is.....m. ^{above} ~~G.L.~~/^{below} G.L.

Height of Top Vanes to Top Mark/Pillar plate.....m. Diameter of Vanes (vertical).....~~0.92~~.....m.

Height of Cairn.....m. Diameter of Cairn.....m. Name Plate ~~found~~/~~not found~~/~~placed~~.

Length of Mast.....~~4.195~~.....m. (approximate if not unpiled)

4. A.....~~set in conc/rock has been placed~~/~~found~~/~~bearing~~.....°M from Mast/Plug/Pillar

5. A.....~~set in conc/rock has been placed~~/~~found~~/~~bearing~~.....°M from Mast/Plug/Pillar

6. A.....~~set in conc/rock has been placed~~/~~found~~/~~bearing~~.....°M from Mast/Plug/Pillar

7. A.....~~set in conc/rock has been placed~~/~~found~~/~~bearing~~.....°M from Mast/Plug/Pillar

8. Action required:.....**TOWRANG**.....
1:25,000

STANDPOINT:

Mark	Direction	Horiz. Distance	Height Difference	Mark	Direction	Horiz. Distance	Height Difference
			above standpt.				above standpt.
			below				below
			above standpt.				above standpt.
			below				below
Prepared by: *[Signature]*

Checked: *[Signature]*

Noted on U.T.M. Card

st 2759-1

STATION: **GAP RANGE** TS: **6762**
 MAP SHEET: **Goulburn** No: **258**
 SCALE 1:250 000
 INSPECTED BY: **A Sivertsen** DATE: **14-10-78**
 AUTHORITY: **CMA** FIELD BOOK: **1709**

Station Diagram North

A is good pillar site
 Owner in objection to clearing
 Good △ site +

Not to Scale

CENTRAL MAPPING AUTHORITY

GEODETIC SURVEY OF N.S.W.

GEODETIC STATION RECONNAISSANCE and MAINTENANCE REPORT

Description:

Note: Cross out word or words which do not apply


1. Cleared by lines bearing $15^{\circ} 25' 28.0''$ / $324^{\circ} 0' 32.0''$ from Trig. Mast
2. Mast & Vanes have been painted white & black respectively.
3. The station/pillar was unpiled/not unpiled/constructed on $26 - 9 - 1981$, dimensions now being: **STEEL PILLAR**
4. Description of mark: **STEEL PILLAR** could be explicit, e.g., S/Steel Pillar Plate, **Steel-plate, Brass-plate, Bolt, G.L.**
5. Height of mark: 1.375 m. ^{above rock/concrete;} Mark is 1.525 m. ^{above G.L.}
6. Height of Top Vanes to Top **Mast**/Pillar plate 1.445 m. Diameter of Vanes (vertical) 0.750 m.
7. Height of Cairn..... m. Diameter of Cairn..... m. Name Plate found/not found/placed.
8. Length of Mast..... m. (approximate if not unpiled)
9. **BRASS TRIG. PLUG** set in **rock**/rock has been **placed**/found, bearing 253° M from **Mast/Plug**/Pillar
10. **COPPER NAIL** set in **conc**/rock has been **placed**/found, bearing 183° M from **Mast/Plug**/Pillar
11. **A** set in **conc**/rock has been **placed**/found, bearing..... M from **Mast**/Plug/Pillar
12. **A** set in **conc**/rock has been **placed**/found, bearing..... M from **Mast**/Plug/Pillar
13. Action required:.....

STANDPOINT: CONC PILLAR		STANDPOINT: BRASS TRIG PLUG	
Mark	Direction	Horiz. Distance	Height Difference
BAW BAW	$0 00 00$		above standpt.
TRIG PLUG	$8 57 40$	$3 724$	below
WAYO	$44 48 40$	$1 739$	above standpt.
TOWRANG	$260 49 00$	$3 723$	below
COPPER NAIL	$302 22 20$	$3 966$	above standpt.
			below

Prepared by: **J. Zand 12/10/87** Checked: **Noted on U.T.M. Card**

S: 2738-1

STATION: **GAP RANGE** No.: **6762**
 MAP SHEET **G OULBURN**
 SCALE 1:250 000
 INSPECTED BY: **G. Ford** DATE: **28-9-81**
 AUTHORITY: **C. M. A.** FIELD BOOK: **1929**

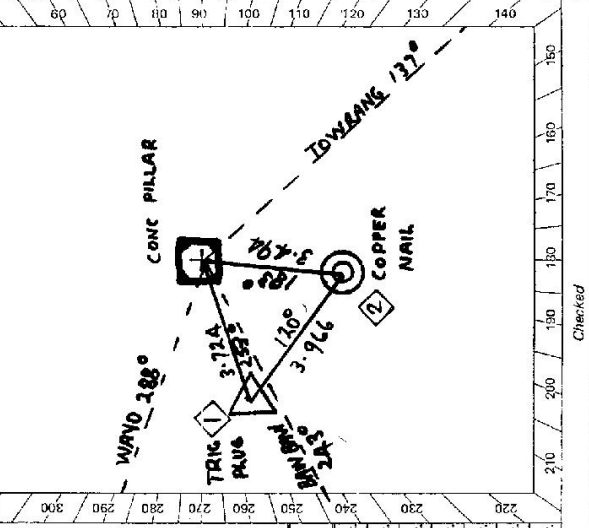

Checked

GEODETIC SURVEY OF N.S.W.

CENTRAL MAPPING AUTHORITY

GEODETIC STATION RECONNAISSANCE and MAINTENANCE REPORT

Description:

Note: Cross out word or words which do not apply

1. Cleared by lanes bearing... 14° 13' M, 71° 25' M, 22° 28' M, 322° 32' M, from Trig. Mast
2. Mast & Vanes have been painted white & black respectively.
3. The station/pillar was ~~replaced~~ on 16 April 1984, dimensions now being:
 - Description of mark: ~~Steel Pillar~~ **Steel Pillar Plate** should be explicit, e.g., S/Steel Pillar Plate, Steel plug, Brass plug, Bolt, G.I. Pipe
 - Height of mark: 1.315 m above rock/concrete; Mark is 1.525 m above G.L.
 - Height of Top Vanes to Top Mark/Pillar plate 1.445 m. Diameter of Vanes (vertical) 1.75 m.
 - Height of Cairn: m. Diameter of Cairn: m. Name Plate found ~~and~~ placed.
 - Length of Mast 1.525 m. (approximate if not emptied)
4. A **BONA FIDE** mark set in conc/rock has been placed/found, bearing 253° M from Mast/Pillar
5. A **CAPRE** mark set in conc/rock has been placed/found, bearing 183° M from Mast/Pillar
6. A mark set in conc/rock has been placed/found, bearing ° M from Mast/Pillar
7. A mark set in conc/rock has been placed/found, bearing ° M from Mast/Pillar
8. Action required:

STANDPOINT:


Mark	Direction	Horiz. Distance	Height Difference
			above standpt
			below
			above standpt
			below
STANDPOINT:

Mark	Direction	Horiz. Distance	Height Difference
			above standpt
			below
			above standpt
			below
Prepared by: D. J. Kain

Checked: Noted on U.T.M. Card

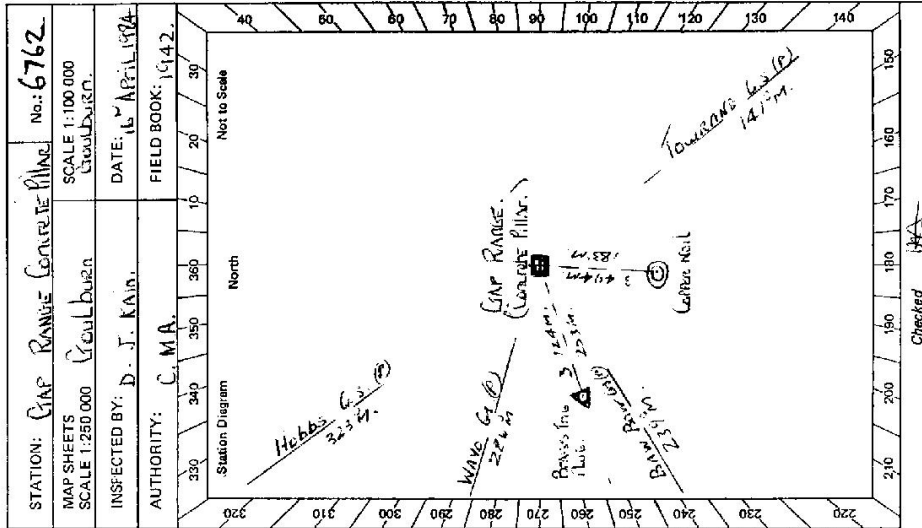

Checked

