

TS 6765
No. 1827

STATION: *DIBALAMBLE.*

MAP SHEET
SCALE 1:250 000


INSPECTED BY: *G Jones*

AUTHORITY: *CMA*

DATE: *24/6/81*

FIELD BOOK: *1915*

Not to Scale

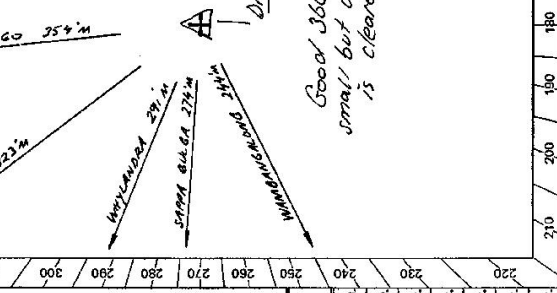

CENTRAL MAPPING AUTHORITY
GEODETTIC SURVEY OF N.S.W.
GEODETTIC STATION RECONNAISSANCE and MAINTENANCE REPORT

Description:
Cleared by lanes bearing.....*See diagram*..... from Trig. Mast

Mast & Vanes have been painted white & black respectively.

The station/pillar was unpiled/not unpiled/constructed on..... 19....., dimensions now being:

Description of mark.....should be explicit, e.g., S/Steel Pillar Plate, Steel plug, Brass plug, Bolt, G.I. Pipe

Height of mark.....m. above below rock/concrete; Mark is.....m. above below G.L.

Height of Top Vanes to Top Mark/Pillar plate.....m. Diameter of Vanes (vertical).....m.

Height of Cairn.....m. Diameter of Cairn.....m. Name Plate found/not found/placed.

Length of Mast.....m. (approximate if not unpiled)

A.....set in conc/rock has been placed/found, bearing.....° M from Mast/Plug/Pillar

A.....set in conc/rock has been placed/found, bearing.....° M from Mast/Plug/Pillar

A.....set in conc/rock has been placed/found, bearing.....° M from Mast/Plug/Pillar

A.....set in conc/rock has been placed/found, bearing.....° M from Mast/Plug/Pillar

Action required: *Trig. to be cleared 360° Maintenance of station*.....

STANDPOINT:		STANDPOINT:		STANDPOINT:		STANDPOINT:	
Mark	Direction	Horiz. Distance	Height Difference	Mark	Direction	Horiz. Distance	Height Difference
			above standpt.				above standpt.
			below				below
			above standpt.				above standpt.
			below				below
Prepared by: *GLJ* - *24/7/81* Checked: *G Jones 21-7-81* Noted on U.T.M. Card

Checked

SR 2733-1

CENTRAL MAPPING AUTHORITY
 GEODETIC SURVEY OF N.S.W.
 GEODETIC STATION RECONNAISSANCE and MAINTENANCE REPORT

STATION: DIALALAMBLE G.S.G. No.: 6765
 MAP SHEET SCALE 1:250 000 D2686
 INSPECTED BY: P. Potts DATE: 8.6.82
 AUTHORITY: C.M.A. FIELD BOOK: 01927

- Description:
 Note: Cross out word or words which do not apply
- Cleared by lanes bearing..... from Trig. Mast
 - Mast & Vanes have been painted white & black respectively.
 - The station/pillar was unpiled/not unpiled/constructed on..... dimensions now being:
 Description of mark..... should be explicit, e.g., S/Steel Pillar Plate, Steel plug, Brass plug, Bolt, G.I. Pipe
 Height of mark.....m. above rock/concrete; Mark is.....m. above G.L.
 Height of Top Vanes to Top Mark/Pillar plate.....m. Diameter of Vanes (vertical).....m.
 Height of Cairn.....m. Diameter of Cairn.....m. Name Plate found/not found/placed.
 Length of Mast.....m. (approximate if unpiled)
 - A..... set in conc/rock has been placed/found, bearing.....° M from Mast/Plug/Pillar
 - A..... set in conc/rock has been placed/found, bearing.....° M from Mast/Plug/Pillar
 - A..... set in conc/rock has been placed/found, bearing.....° M from Mast/Plug/Pillar
 - A..... set in conc/rock has been placed/found, bearing.....° M from Mast/Plug/Pillar
 - Action required: NEW POINT

STANDPOINT:		STANDPOINT:					
Mark	Direction	Horiz. Distance	Height Difference	Mark	Direction	Horiz. Distance	Height Difference
			above standpt.				above standpt.
			below standpt.				below standpt.
			above standpt.				above standpt.
			below standpt.				below standpt.
Prepared by: P. Potts 15-6-82 Checked: 18/7/82 Stored on U.T.M. Card

