


STATION TS 6770 (EMERALD BEACH)

Owners Name... Crown Land
 Address... Portion 237 - Dedicated for Public Recreation
 Gaz. 18.10.74. Vol. 4080


Current Occupant.....
 Address.....

Not to Scale

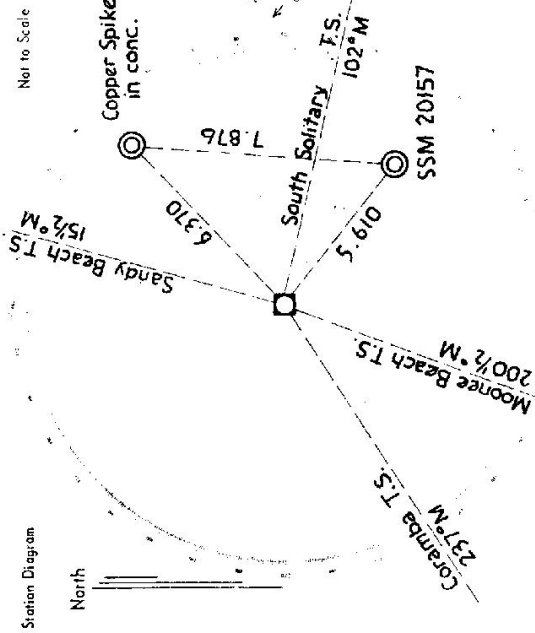

List of Observed Directions:-

Station	Direction	Standpoint:	Station	Direction
		Concrete pillar		

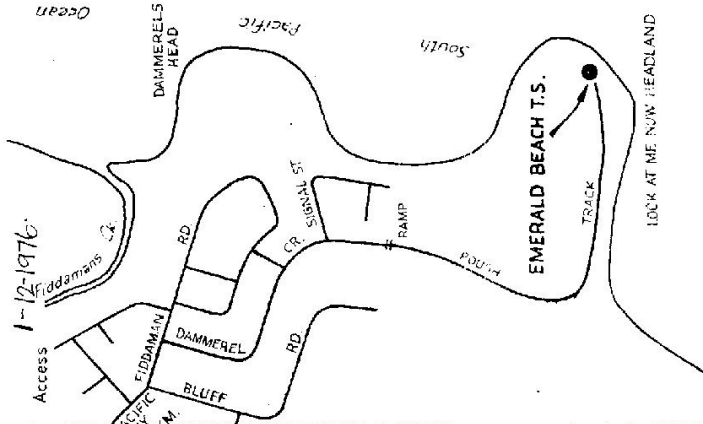

From Coff's Harbour travel north along the Pacific Highway for 19 km; then turn right along Fiddaman Road to the Village of Emerald Beach for 0.6 km; then turn right along Dammerel Crescent and follow for 0.6 km to reach above. Follow along beach beyond ramp to follow on beach. Station is accessible by two wheel drive vehicle.

D. West, Measurement Printer, New South Wales 1976

CENTRAL MAPPING AUTHORITY

GEODETIC SURVEY OF N.S.W.
 GEODETIC STATION RECONNAISSANCE and MAINTENANCE REPORT

Description:

Note: Cross out word or words which do not apply

1. Cleared by lances bearing..... **360°** from Trig. Mast
2. Mast & Vanes have been painted white & black respectively. ✓
3. The station/pillar was unplied/not unplied/constructed on..... **19**....., dimensions now being:
 Description of mark: **S/S PLATE**..... should be explicit, e.g., S/Steel Pillar Plate, Steel plug, Brass plug, Bolt, G.I. Pipe
 Height of mark..... **3.75**.....m. above ~~below~~ **mark** is.....m. ~~above~~ **below** G.L.
 Height of Top Vanes to Top Mark/Pillar plate..... **1.90**.....m. Diameter of Vanes (vertical)..... **0.650**.....m.
 Height of Cairn.....m. Diameter of Cairn.....m. Name Plate ~~found~~/not found/~~placed~~
 Length of Mast..... **1.570**.....m. (approximate if not unplied)
 4. **SSM N° 20157** set in conc/~~rock~~ has been ~~placed~~/found, bearing..... **128°**.....M from ~~Mast/Plug~~/Pillar
 5. **COPPER NAIL**..... set in conc/~~rock~~ has been ~~placed~~/found, bearing..... **46°**.....M from ~~Mast/Plug~~/Pillar
 6. **A**..... set in conc/~~rock~~ has been placed/found, bearing.....°M from Mast/Plug/Pillar
 7. **A**..... set in conc/~~rock~~ has been placed/found, bearing.....°M from Mast/Plug/Pillar
 8. Action required:.....


STANDPOINT: **PILLAR PLATE** STANDPOINT: **SSM N° 20157**

Mark	Direction	Horiz. Distance	Height Difference	Mark	Direction	Horiz. Distance	Height Difference
WOODGOOLGA RES 359 59 60			above standpt.	WOODGOOLGA RES 359 59 60			above standpt.
COPPER NAIL 45 56 49		6.372	below	COPPER NAIL 01 07 05		7.830	above standpt.
SSM N° 20157 127 53 45		5.613	below	MOONJEE PILLAR 200 38 10			above standpt.
MOONJEE PILLAR 200 32 19			above standpt.	EMERALD BEACH 307 55 49		5.616	below
			above standpt.				above standpt.
			below				below
			above standpt.				above standpt.
			below				below

Prepared by:

Checked: **4/41**

Noted on U.T.M. Card **41 638**

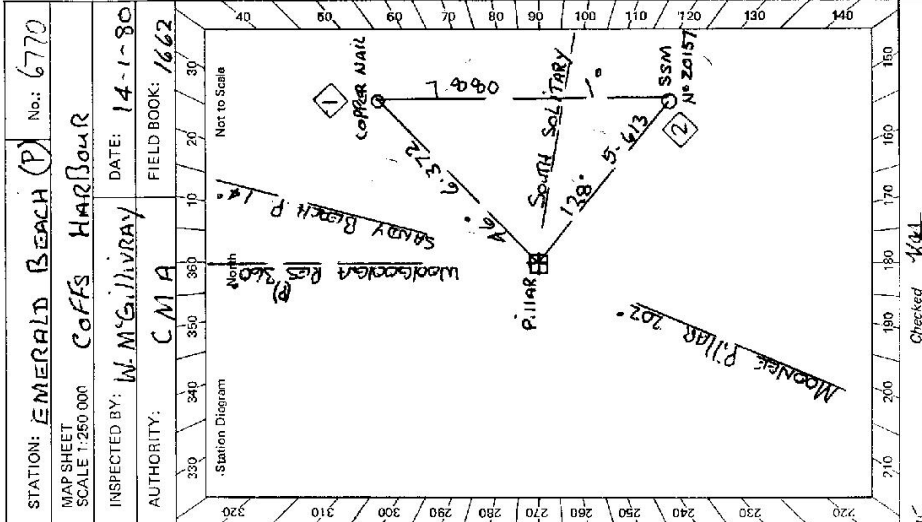

STATION: **EMERALD BEACH (P)** No.: **6770**

MAP SHEET SCALE 1:250 000 **COFFS HARBOUR**

INSPECTED BY: **W. McILVRA** DATE: **14-1-80**


AUTHORITY: **CMA** FIELD BOOK: **1662**

STATION EMERALD BEACH PILLAR 75-6770

Current Occupant:
 Address:
 Phone:

Owner's Name: CRONIN LAND
 Address:
 Phone:

ACCESS
 Access Report of 1/12/19 was found suitable/unsuitable:

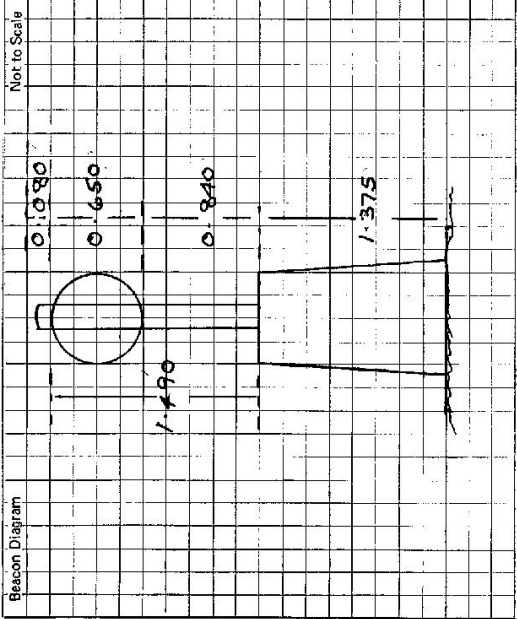

This section to be completed by officer constructing pillar.

Original station mark found/not found.

Description of mark:

Original beacon found/not found.

Description of beacon:

Height Top of Vanes to Top Mark:m.

Height of mark:m. ^{above} rock/conem. ^{G.L.} below

Diameter of Vanesm. Height of Cairnm.

Original Beacon has/has not been destroyed by me.

Date	Record of Station