






CENTRAL MAPPING AUTHORITY

STATION: Woolooloolga (RUS) (P) No: 6771

MAP SHEET SCALE 1:250 000

INSPECTED BY: D SHARDBOLT DATE: 22.1.80

AUTHORITY: CMA FIELD BOOK: 1662

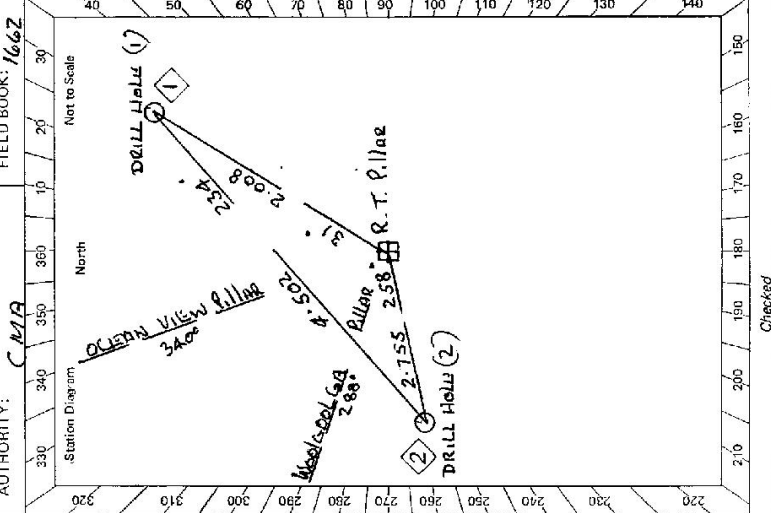

GEODETIC STATION RECONNAISSANCE and MAINTENANCE REPORT

- Description: *Note: Cross out word or words which do not apply*
- Cleared by Jans bearing 340 from Trig. Mast
  - Mast & Vanes have been painted white & black respectively.
  - The station/pillar was unpiled/not unpiled/constructed on 19 dimensions now being: Description of mark R.T. PILLAR should be explicit, e.g. S/Steel Pillar Plate, Steel plug, Brass plug, Bolt, G.I. Pipe
  - Height of mark 1.368 m. above ~~rock~~ rock/concrete; Mark is above G.L.
  - Height of Top Vanes to Top Mark/Pillar plate 1.332 m. Diameter of Vanes (vertical) 0.525 m.
  - Height of Cairn 1.912 m. Diameter of Cairn 0.15 m. Name Plate found/not found/lost/damaged.
  - Length of Mast 1.912 m. (approximate if not unpiled)
  - A DRILL HOLE (1) set in conc/rock has been placed/removed, bearing 31 °M from Mast/Plug/Pillar
  - A DRILL HOLE (2) set in conc/rock has been placed/removed, bearing 258 °M from Mast/Plug/Pillar
  - A WOODWOOLGA PILLAR set in conc/rock has been placed/removed, bearing 271 °M from Mast/Plug/Pillar
  - A R.T. PILLAR set in conc/rock has been placed/removed, bearing 258 °M from Mast/Plug/Pillar

Mark	Direction	Horiz. Distance	Height Difference	Mark	Direction	Horiz. Distance	Height Difference	STANDPOINT:	
								Mark	Height Difference
CLEAN VIEW P.	359 59 60		above standpt.						
DRILL HOLE (1)	53 22 45	2.008	below standpt.						
DRILL HOLE (2)	271 09 50	2.755	below standpt.						
WOODWOOLGA PILLAR	297 21 30		above standpt.						

Prepared by: U.T.M. Cart Checked: U.T.M. Cart

STATION <b>WOODGEORGE RES</b> <del>TS 6771</del>	Owner's Name: ..... Address: ..... Phone: ..... Current Occupant: ..... Address: ..... Phone: ..... Access Report of ...../19..... was found suitable/unsuitable. ACCESS <b>KEY FROM WATER &amp; SEWERAGE BOARD</b> <b>WOODGEORGE</b>
Beacon Diagram 	Not to Scale This section to be completed by officer constructing pillar. Original station mark found/not found. Description of mark: ..... Original beacon found/not found. Description of beacon: ..... Height Top of Vanes to Top Mark: .....m. Height of mark: .....m. above G.L. below G.L. Diameter of Vanes: .....m. Height of Cairn .....m. Original Beacon has/has not been destroyed by me.
	Date Record of Station