


6774
STATION TS 10322 (DIGGERS CAMP)

Co: CLARENCE Ph: SCOPE
Map Sheet: BARE POINT No: 9538-11-N
Inspected by: P.R. Edwards Date: 3-12-76
Authority: Field Book:

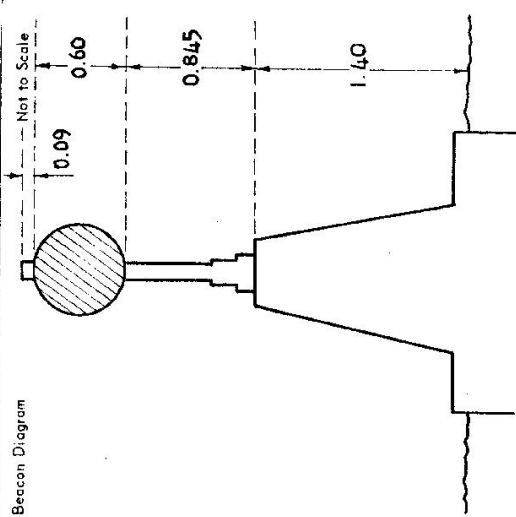

Date	Record of Station
Oct 76	Pillar erected

Department of Lands
NON-GEODETIC
Integrated Survey of N.S.W.
RECONNAISSANCE and MAINTENANCE REPORT

This Trig. Station has been:
Note: Cross out word or words which do not apply

1. Completely cleared to permit 360° vision to surrounding Trigs.
2. Cleared by ~~lance-bearing~~ ^{from Trig-Mast}
3. Trig. Mast & Vanes have been painted white & black respectively.
4. The Trig. was unpiled/not unpiled, dimensions now being:
Description of mark: **Steel Plate on Conc. Pillar** should be explicit, e.g. Steel plug, Brass plug, Bell, Concrete Pillar
Height of mark: ^{above} _{below} m. rock/concrete ^{above} _{below} G.L.
Height of Top Vanes to ~~Top Mast~~ ^{Top pillar plate}: ^{1.40} m. Diameter of Vanes (vertical) ^{0.60} m.
Height of Cairn: m. Diameter of Cairn: m.
Length of Mast: ^{1.535} m. (approximate if not unpiled)
5. A ~~SSM~~ ^{Copper} set in conc/rock has been placed ~~at~~ ⁷⁶⁴² m. bearing ²⁴⁴ m. from ~~Trig-Mast~~ ^{Trig. Mast} pillar
6. A ~~Spike~~ ^{Copper} set in conc/rock has been placed ~~at~~ ⁸⁰²⁰ m. bearing ¹³⁸ m. from ~~Trig-Mast~~ ^{Trig. Mast} pillar
7. A set in conc/soil has been placed ~~at~~ m. bearing m. from Trig. Mast pillar
8. A set in conc/rock has been placed ~~at~~ m. bearing m. from Trig. Mast pillar
9. Connection ~~SSM~~ ^{Copper} to ~~Spike~~ ^{Spike}: ¹¹⁴⁶ m. bearing ¹⁰³ m.
10. Connection to : m. bearing m.
11. Connection to : m. bearing m.
12. Connection to : m. bearing m.
13. Diff. Ht. ~~SSM 23333~~ ^{SSM 23333} is ^{1.64} m. ~~below~~ ^{below} ^{Pillar Plate}
14. Diff. Ht. ~~Copper Spike~~ ^{Copper Spike} is ^{2.03} m. ~~below~~ ^{below} ^{Pillar Plate}
15. Diff. Ht. is m. ~~above~~ ^{above}
16. Diff. Ht. is m. ~~above~~ ^{above}

Prepared by: P.R. Edwards Checked: L.J. Griffin

GEOGETIC SURVEY OF N.S.W.

CENTRAL MAPPING AUTHORITY

GEOGETIC STATION RECONNAISSANCE and MAINTENANCE REPORT

Description:

Note: Cross out word or words which do not apply

1. Cleared by lanes bearing..... 360..... from Trig. Mast
2. Mast & Vanes have been painted white & black respectively.
3. The station/pillar was unpiled/not unpiled/constructed on..... 19..... dimensions now being:
Description of mark S.S.M. PLATE should be explicit, e.g., S/Steel Pillar Plate, Steel plug, Brass plug, Bolt, G.I. Pipe
Height of mark..... 1.370..... m. above ~~rock~~ concrete; Mark is..... m. above G.L.
Height of Top Vanes to Top ~~Mark~~/Pillar plate..... 1.445..... m. Diameter of Vanes (vertical)..... 0.600..... m.
Height of Cairn..... m. Diameter of Cairn..... m. Name Plate found/not found/~~placed~~
4. A..... S.S.M. N° 23333..... set in conc/~~rock~~ has been placed/found, bearing 233.3° M. from Mast/~~Trig~~/Pillar
5. A..... COPPER NAIL..... set in conc/~~rock~~ has been placed/found, bearing 144.4° M. from Mast/~~Trig~~/Pillar
6. A..... set in conc/rock has been placed/found, bearing.....° M. from Mast/Plug/Pillar
7. A..... set in conc/rock has been placed/found, bearing.....° M. from Mast/Plug/Pillar
8. Action required:.....


STANDPOINT: PILLAR PLATE STANDPOINT: S.S.M N° 23333

Mark	Direction	Horiz. Distance	Height Difference	Mark	Direction	Horiz. Distance	Height Difference
BROWNS KNOB	359 59 60		above standpt.	BROWNS KNOB	359 59 60		above standpt.
S.S.M N° 23333	09 39 55	7644	below standpt.	DIGGERS CAMP	189 40 15	7 645	above standpt.
COPPER NAIL	278 56 35	80243	below standpt.	COPPER NAIL	235 42 00	11 153	above standpt.
WOODI PILLAR	323 54 55		above standpt.	WOODI PILLAR	323 51 10		above standpt.
			below standpt.				below standpt.
			above standpt.				above standpt.
			below standpt.				below standpt.

Prepared by:


Checked:

Sr 2733-1

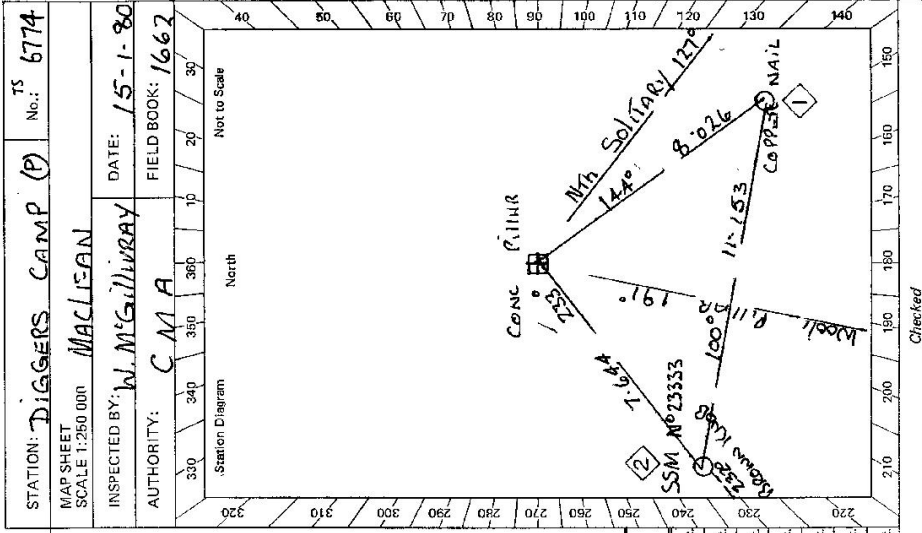

Checked

STATION **DIGGERS CAMP PILLARS 6774**

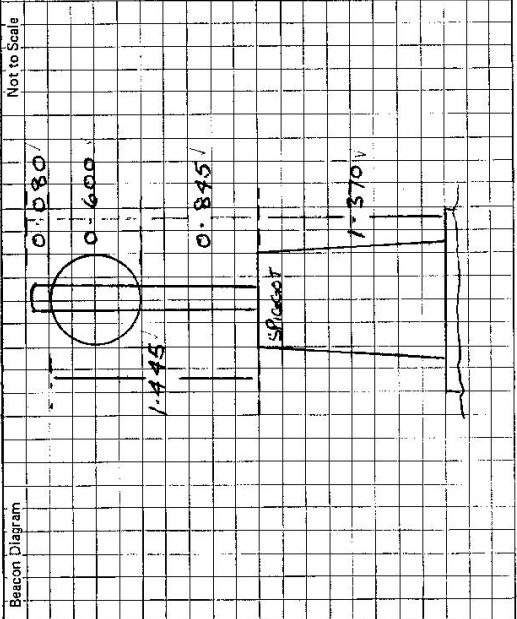

Owner's Name: **CROWN LAND**
 Address:
 Phone:

Current Occupant:
 Address:
 Phone:

ACCESS
 Access Report of 3/12/19 was found suitable.

This section to be completed by officer constructing pillar.

Original station mark found/not found.

Description of mark:

Original beacon found/not found.

Description of beacon:

Height Top of Vanes to Top Mark m.
 above below
 Height of mark m. rock/cont. m. above G.L. below

Diameter of Vanes m. Height of Cairn m.

Original Beacon has/has not been destroyed by me.

Date	Record of Station