





STATION  
 (PROPOSED SITE)  
 BROOMS HEAD TS. 6.175

Owners Name: .....  
 Current Occupant: .....  
 Address: .....  
 Address: .....

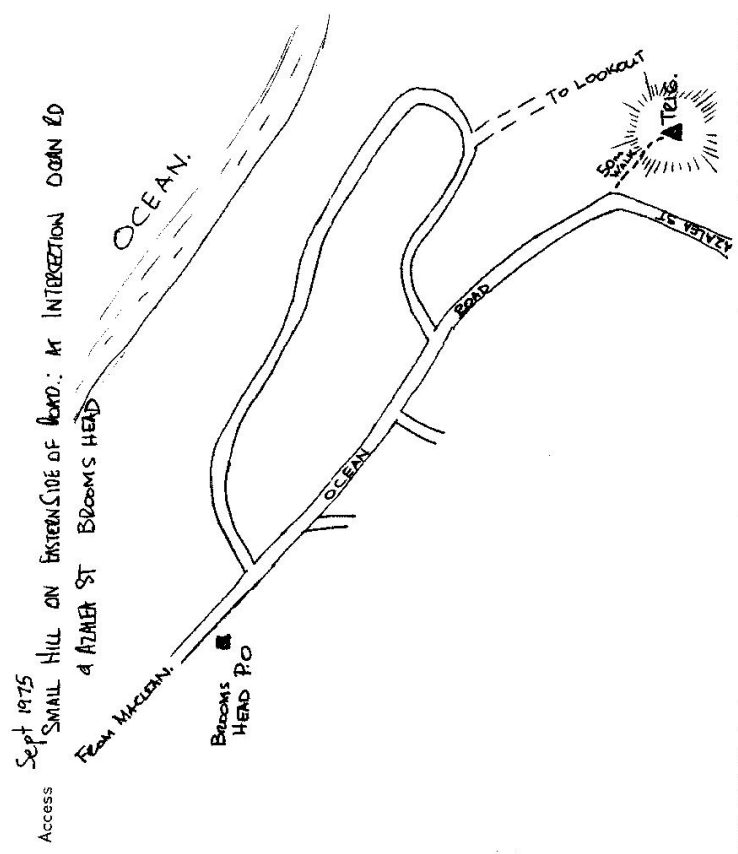

Sept 1975  
 Access

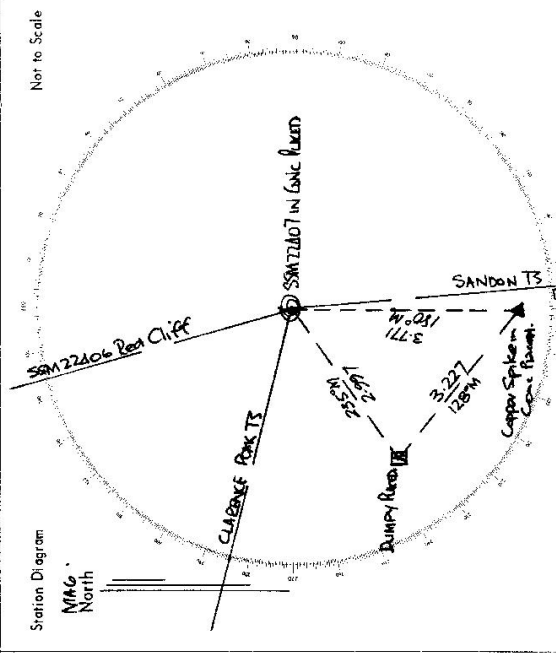

List of Observed Directions:-

Station	Direction	Station	Direction
Standpoint: SSM 22407			
SANDON TS	58° 59' 60"	SANDON TS	389° 59' 60"
CLARENCE ROCK TS	110° 16' 31"	DUMPY (PROPOSED PILE SITE)	58° 58' 27.5"
RED CLIFF TS. SSM 22406	170° 59' 00.5"	CLARENCE ROCK TS	110° 16' 30"
SSM 22407			
SANDON TS	389° 59' 60"	RED CLIFF TS. SSM 22406	170° 58' 58.5"
COPPER SPIKE IN CONC	2° 59' 27.5"		
DUMPY (PROPOSED PILE SITE)	58° 58' 27.5"		
CLARENCE ROCK TS	110° 16' 30"		
RED CLIFF TS. SSM 22406	170° 58' 58.5"		

CENTRAL MAPPING AUTHORITY

GEODETIC SURVEY OF M.S.W.  
 GEODETIC STATION RECONNAISSANCE and MAINTENANCE REPORT

Description:

Note: Cross out word or words which do not apply


1. Cleared by lances bearing..... from Trig, Mast
2. Mast & Vanes have been painted white & black respectively. ✓
3. The station/pillar was unpiled/not unpiled/constructed on..... 19....., dimensions now being:  
 Description of mark: SS Pillar Plate should be explicit, e.g., S/Steel Pillar Plate, Steel plug, Brass plug, Bolt, G.I. Pipe  
 Height of mark: 3.70 m. <sup>above</sup> ~~below~~ rock/concrete; Mark is.....m. <sup>above</sup> ~~below~~ G.L.  
 Height of Top Vanes to Top Mark/Pillar plate 4.45 m. Diameter of Vanes (vertical) 4.25 m.  
 Height of Cairn.....m. Diameter of Cairn.....m. Name Plate found/~~not found~~/placed.  
 Length of Mast 1.525 m. (approximate if not unpiled)
4. SSM N° 22407 set in conc/rock has been ~~placed~~/found, bearing.....°M from Mast/Plug/Pillar
5. Copper Nail set in conc/rock has been ~~placed~~/found, bearing.....°M from Mast/Plug/Pillar
6. A set in conc/rock has been placed/found, bearing.....°M from Mast/Plug/Pillar
7. A set in conc/rock has been placed/found, bearing.....°M from Mast/Plug/Pillar
8. Action required:.....

Mark	Direction	Horiz. Distance	Height Difference	Mark	Direction	Horiz. Distance	Height Difference
CLARENCE (P)	359 59 60		above standpt.	CLARENCE (P)	359 59 60		below standpt.
SSM N° 22407	128 26 05	3.060	above standpt.	SANDON (P)	249 43 35		above standpt.
COPPER NAIL	201 40 05	3.259	below	COPPER NAIL	252 40 05	3.772	above standpt.
SANDON (P)	249 41 00		below	BROOMS HEAD (P)	308 27 55	3.062	above standpt.
			below				below
			below				below
			below				below
			below				below

STANDPOINT: Pillar Plate      STANDPOINT: SSM N° 22407

Prepared by: PH      Checked: PH  
 Noted on U.T.M. Card

S: 2733-1

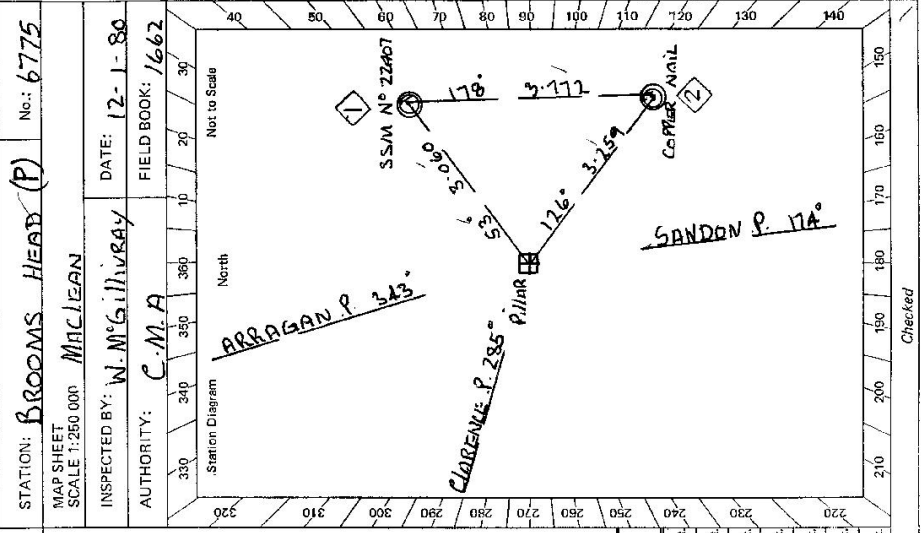

Checked

STATION **BROOMS HEAD PILLAR 6775**



Owner's Name: **CRANMAN LAND**  
 Address: .....  
 Phone: .....

Current Occupant: .....  
 Address: .....  
 Phone: .....

ACCESS  
 Access Report of **3/12/19/14** was found suitable/unsuitable:

From Maclean Post Office travel south along the old Pacific Highway for 1.2km; then turn left on to the Brooms Head road and follow for 27km to village of Brooms Head; follow Ocean Rd to its intersection with Azalea St; then follow sandy track for about 30m to pillar. Station is accessible with care by two wheel drive vehicle.

ACCESS

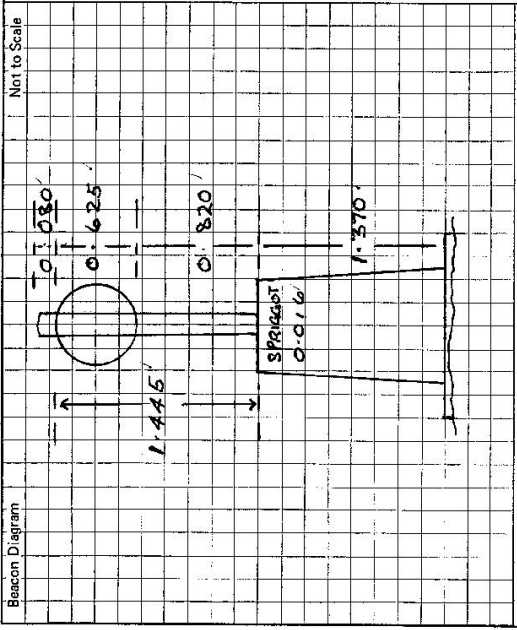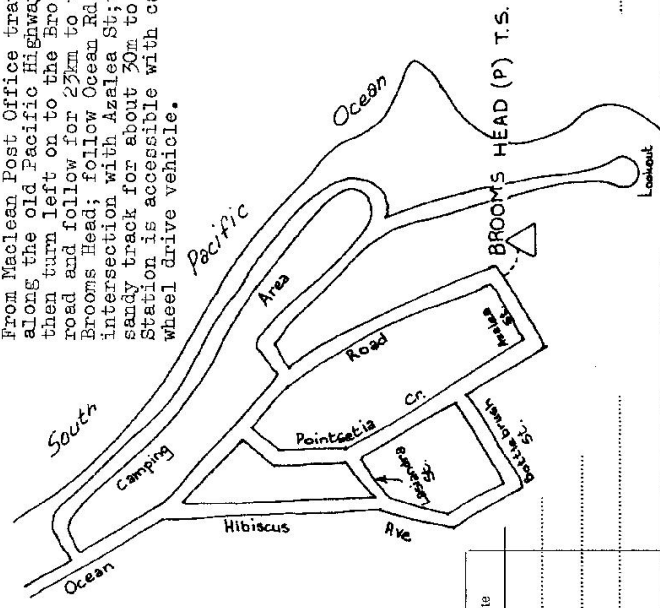

This section to be completed by officer constructing pillar.

Original station mark found/not found.  
 Description of mark: .....  
 Original beacon found/not found.  
 Description of beacon: .....  
 Height Top of Vanes to Top Mark .....m.  
 Height of mark .....m above G.L. below  
 Diameter of Vanes .....m. Height of Cairn .....m.  
 Original Beacon has/has not been destroyed by me.

Date