

CENTRAL MAPPING AUTHORITY

GEODETIC SURVEY OF N.S.W.

GEODETIC STATION RECONNAISSANCE and MAINTENANCE REPORT

Description:

1. ~~Cleared by trees bearing~~ No visibility to box 1.2m ^{are} ~~from Trig. Mast~~ are ~~have been~~ painted white & black respectively.
2. Mast & Vanes ~~have been~~ painted white & black respectively.
3. The station/~~either was unplaced~~/not unplaced/~~constructed~~ on 2nd May, 1972, dimensions now being:

Note: Cross out word or words which do not apply

Description of mark: ~~.....~~ should be explicit, e.g., S/Steel Pillar Plate, Steel plug, Brass plug, Bolt, G.I. Pipe

Height of mark: ~~.....~~ m. ^{above} rock/concrete; Mark is ~~.....~~ m. ^{above} G.L.

Height of Top Vanes to Top Mark/Pillar plate: ~~.....~~ m. Diameter of Vanes (vertical) 0.76 m.

Height of Cairn: 1.6 m. Diameter of Cairn: 2.7 m. ~~Name Plate found/not found/placed~~

Length of Mast: 3.57 m. (approximate if not unplaced)

4. A SSM 151 set in conc/~~rock~~ has been ~~placed~~ found, bearing 234° M from Mast/~~Plug/Pillar~~

5. A ~~.....~~ set in conc/rock has been placed/found, bearing ~~.....~~° M from Mast/Plug/Pillar

6. A ~~.....~~ set in conc/rock has been placed/found, bearing ~~.....~~° M from Mast/Plug/Pillar

7. A ~~.....~~ set in conc/rock has been placed/found, bearing ~~.....~~° M from Mast/Plug/Pillar

8. Action required: Clearing around station

STANDPOINT:

STANDPOINT:

Mark	Direction	Horiz. Distance	Height Difference	Mark	Direction	Horiz. Distance	Height Difference
			above standpt				above standpt
			below				below
			above standpt				above standpt
			below				below
Prepared by: J. SUTTON

Checked:


Noted on U.T.M. Card

Checked

STATION: BONE No.: 5782
 MAP SHEET SCALE 1:250 000 GILGANDRA

INSPECTED BY: J. SUTTON DATE: 23rd May, 1972

AUTHORITY: CMA FIELD BOOK: ---

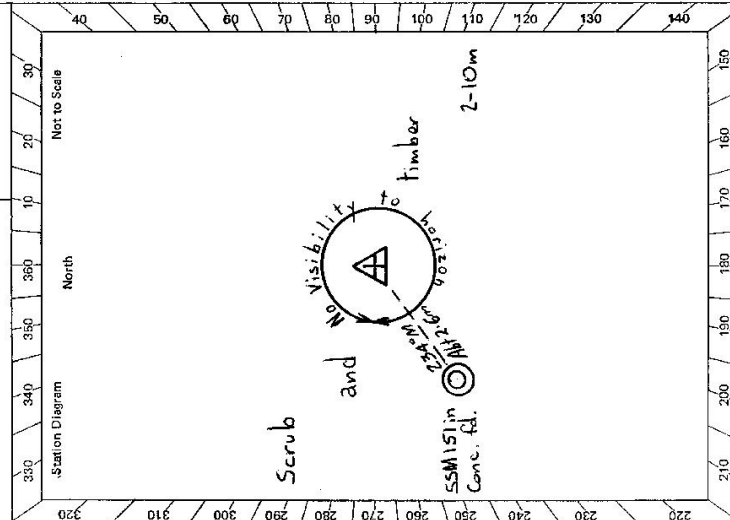

GS 24

STATION		BONE	6782
Owner's Name: C.R. Hickey & Co. Ltd. Address: "Springfield" Spring Ridge Spring Ridge Phone: Spring Ridge 11	MINER Current Occupant: Barry Litchfield Address: "Telargra" Bundella Via Quicini Phone: Bundella 476 221	<p>ACCESS</p> <p>Access Report of 2/2/1966 was found suitable/unsuitable</p> <p>Alternative Access:</p> <p>From Coolah P.O. by the Cassilis Road for 1.85km then turn left on to the Pandora Road and follow for 31.4 km to the "Pandora" Homestead. Turn right at junction on to the "Telargra" property road and follow through for about 5.5km to homestead.</p> <p>From "Telargra" homestead proceed 80m, through gate and swing left along track for 220m to causeway in creek. Cross creek and follow track for 1.5km stopping vehicle at grid on fence line in saddle.</p> <p>Follow fence line to NW to Bone G.S.</p> <p>Approx. 65 minutes walk with a 10m high cliff to negotiate.</p>	
<p>Beacon Diagram</p> <p>Not to Scale</p> <p>0.05</p> <p>0.76</p> <p>1.16</p> <p>1.6</p> <p>0.125m Diam</p> <p>1.65</p> <p>2.17</p>		<p>This section to be completed by officer constructing pillar.</p> <p>Original station mark found/not found.</p> <p>Description of mark:</p> <p>Original beacon found/not found.</p> <p>Description of beacon:</p> <p>Height Top of Vanes to Top Mark.....m.</p> <p>Height of mark.....m. above below</p> <p>Diameter of Vanes.....m. Height of Cairn.....m.</p> <p>Original Beacon has/has not been destroyed by me.</p>	
		Date	Record of Station

CENTRAL MAPPING AUTHORITY		GEODETTIC SURVEY OF M.S.W.																																																																	
GEODETTIC STATION RECONNAISSANCE and MAINTENANCE REPORT		STATION: BONE G.S.	No.: 6782-4052																																																																
Description: 1. Cleared by lanes bearing Not cleared 2. Mast & Vanes have been painted white & black respectively. 3. The station marker was omitted not unpiled/constructed on 11th Sept 80 , dimensions now being: Description of mark..... should be explicit, e.g., S/Steel Pillar Plate, Steel plug, Brass plug, Bolt, G.I. Pipe Height of mark..... m. above below rock/concrete; Mark is..... m. above below G.L. Height of Top Vanes to Top Mark/Pillar plate..... m. Diameter of Vanes (vertical) 0.765 m. Height of Cairn..... m. Diameter of Cairn 2.5 m. Name Plate found not found placed . Length of Mast spare 2.55 m. (approximate if not unpiled) 4. A SSM N° 151 set in conc/rock has been placed found, bearing 246 ° M from Mast/ Plug/Pillar 2.782 m. 5. A..... set in conc/rock has been placed/found, bearing.....° M from Mast/Plug/Pillar 6. A..... set in conc/rock has been placed/found, bearing.....° M from Mast/Plug/Pillar 7. A..... set in conc/rock has been placed/found, bearing.....° M from Mast/Plug/Pillar 8. Action required: Paint mark & vanes 1st day clearing for 360°		MAP SHEET SCALE 1:250 000 INSPECTED BY: J. FANNING DATE: 11th Sept 80 AUTHORITY: C.M.A. NSW 229 FIELD BOOK: _____																																																																	
Note: Cross out word or words which do not apply from Trig. Mast		Station Diagram North Not to Scale																																																																	
STANDPOINT: <table border="1" style="width: 100%; border-collapse: collapse;"> <thead> <tr> <th>Mark</th> <th>Grid Direction</th> <th>Mark</th> <th>Grid Direction</th> <th>Height Difference</th> <th>Horiz. Distance</th> <th>Height Difference</th> <th>Horiz. Distance</th> </tr> </thead> <tbody> <tr> <td>Previously Observed</td> <td></td> <td></td> <td></td> <td></td> <td></td> <td></td> <td></td> </tr> <tr> <td>Tamarang</td> <td>20 57 19</td> <td>17.5</td> <td>above standpt.</td> <td>below</td> <td>16</td> <td>Hill</td> <td>above standpt.</td> </tr> <tr> <td>Booyemurno</td> <td>215 35 08</td> <td>22.5</td> <td>above standpt.</td> <td>below</td> <td>18</td> <td>Hill</td> <td>above standpt.</td> </tr> <tr> <td>Dakey</td> <td>253 39 38</td> <td>11.2</td> <td>above standpt.</td> <td>below</td> <td></td> <td></td> <td>above standpt.</td> </tr> <tr> <td>Brennan</td> <td>289 20 03</td> <td>10.6</td> <td>above standpt.</td> <td>below</td> <td></td> <td></td> <td>above standpt.</td> </tr> <tr> <td>Bomera</td> <td>320 28 32</td> <td>18.1</td> <td>above standpt.</td> <td>below</td> <td></td> <td></td> <td>above standpt.</td> </tr> <tr> <td>Merrigula</td> <td>357 18 50</td> <td>31.1</td> <td>above standpt.</td> <td>below</td> <td></td> <td></td> <td>above standpt.</td> </tr> </tbody> </table>		Mark	Grid Direction	Mark	Grid Direction	Height Difference	Horiz. Distance	Height Difference	Horiz. Distance	Previously Observed								Tamarang	20 57 19	17.5	above standpt.	below	16	Hill	above standpt.	Booyemurno	215 35 08	22.5	above standpt.	below	18	Hill	above standpt.	Dakey	253 39 38	11.2	above standpt.	below			above standpt.	Brennan	289 20 03	10.6	above standpt.	below			above standpt.	Bomera	320 28 32	18.1	above standpt.	below			above standpt.	Merrigula	357 18 50	31.1	above standpt.	below			above standpt.	Checked: P. Holden Noted on U.T.M. Card	
Mark	Grid Direction	Mark	Grid Direction	Height Difference	Horiz. Distance	Height Difference	Horiz. Distance																																																												
Previously Observed																																																																			
Tamarang	20 57 19	17.5	above standpt.	below	16	Hill	above standpt.																																																												
Booyemurno	215 35 08	22.5	above standpt.	below	18	Hill	above standpt.																																																												
Dakey	253 39 38	11.2	above standpt.	below			above standpt.																																																												
Brennan	289 20 03	10.6	above standpt.	below			above standpt.																																																												
Bomera	320 28 32	18.1	above standpt.	below			above standpt.																																																												
Merrigula	357 18 50	31.1	above standpt.	below			above standpt.																																																												
Prepared by: J. FANNING		Checked:																																																																	

GS 24

6:2732-2 D. West, Government Printer

STATION BONE G.S. 6782


Owner's Name: C. R. Hickey & Co. Ltd
 Address: Springfield
 Phone: Spring Ridge
 Address: Spring Ridge
 Phone: Spring Ridge

Manager: Barry Littlefield
 Current Occupant: Telara
 Address: Rindella via Guirindi
 Phone: (067) 476 221

ACCESS

Access Report of 21/11/1986 was found suitable Accessible

- 0.0 Coolah Valley Hotel Coolah travel east
- 1.73 Turn left Signpost Pandora Pass 32
- 31.13 Pandora Homestead turn right Norfolk Falls 37
- 36.10 Homestead on left Telara (Managers House)
- 43.50 Iron gate. Stop vehicle in saddle at gate
- Follow fence line to N west to Bone G.S.
- 65 minute walk no road

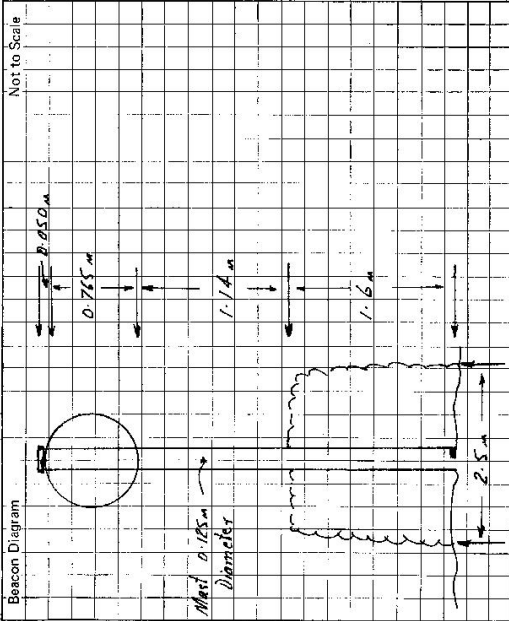

This section to be completed by officer constructing pillar.

Original station mark found/not found.

Description of mark:

Original beacon found/not found.

Description of beacon:

Height Top of Vanes to Top Mark:m.

Height of mark:m. above below G.L.

Diameter of Vanes:m. Height of Cairn:m.

Original Beacon has/has not been destroyed by me.

Date

Record of Station

11/4/88 Permission of Managers to clear 360° & any other work necessary.

CENTRAL MAPPING AUTHORITY

GEODETIC SURVEY OF N.S.W.

GEODETIC STATION RECONNAISSANCE and MAINTENANCE REPORT

Description:

1. Cleared by lanes bearing 360° *Note: Cross out word or words which do not apply* from Trig. Mast

2. Mast & Vanes have been painted white & black respectively. ✓

3. The station/ ~~pillar~~ was unpainted/~~not applied/constructed~~ on $3-8-81$, dimensions now being:

Description of mark **BRASS PLUG** should be explicit, e.g., **Steel Pillar/Plate, Steel plug, Brass plug, Bolt, G.L. Pipe**

Height of mark 0.080 m. ^{above rock/} ~~below~~ Mark is $---$ m. ^{above} ~~below~~ G.L.

Height of Top Vanes to Top Mark/~~Pillar/plate~~ 3.190 m. Diameter of Vanes (vertical) 0.250 m.

Height of Cairn 3.000 m. Diameter of Cairn 3.200 m. Name Plate found/not found/placed.

Length of Mast 3.260 m. ~~(approximate if not applied)~~

4. A **SSM** 151 set in conc/rock has been placed/found, bearing 244° M from Mast/Plug/Pillar

5. A **DRILL HOLE** set in conc/rock has been placed/found, bearing 336° M from Mast/Plug/Pillar

6. A set in conc/rock has been placed/found, bearing $---$ M from Mast/Plug/Pillar

7. A set in conc/rock has been placed/found, bearing $---$ M from Mast/Plug/Pillar

8. Action required: $---$

STANDPOINT:

BRASS TRIG PLUG

STANDPOINT:

SSM

Mark	Direction	Horiz. Distance	Height Difference	Mark	Direction	Horiz. Distance	Height Difference
OAKEY GS	0 00 00		above standpt.	OAKEY GS	0 00 00		above standpt.
SSM	359 58 40	2.795	0.126	BRENNAN (P)	35 41 00		above standpt.
BRENNAN (P)	35 40 50		below	DRILL HOLE	125 17 10	4.651	below
DRILL HOLE	88 22 00	3.796	0.327	PIGEON (P)	181 41 10		above standpt.
PIGEON (P)	161 41 30		below	TRIG PLUG	180 00 20	2.796	0.128
			above standpt.				above standpt.
			below				below

Prepared by:

G. Ford


Checked:

Noted on U.T.M. Card

Checked

S: 2753-1

STATION: **BONE** No. **6782**
 MAP SHEET
 SCALE 1:250 000
 INSPECTED BY: **G. FORD** DATE: **3-8-81**
 AUTHORITY: **C. M. A** FIELD BOOK: **1928**

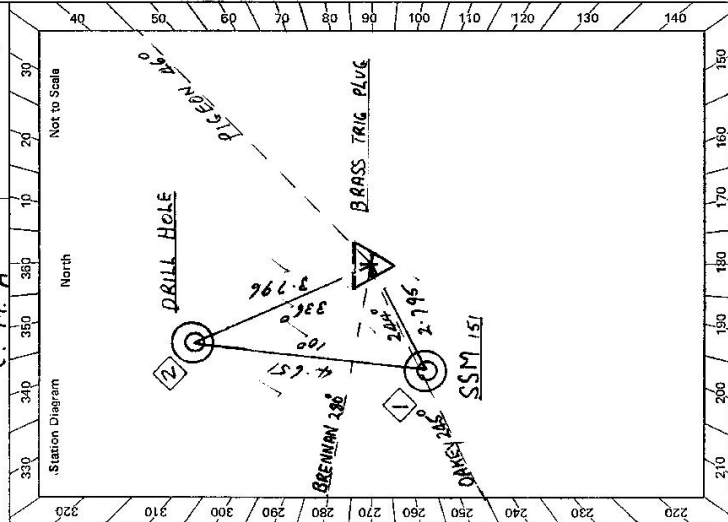

[illegible]

St 2733-2 D. West, Government Printer