

GEODETTIC SURVEY OF M.S.W.

CENTRAL MAPPING AUTHORITY

STATION: EAST BLUFF (CARD 2)	TS No: 6783
MAP SHEET SCALE 1:250 000	
INSPECTED BY:	DATE:
AUTHORITY:	FIELD BOOK:

Station Diagram

North

Not to Scale

SEE OVER FOR ALTERNATE ACCESS

NOTE:

At Present access to East Bluff is 25 per card. However Mr Corley Haggerty (timber getter) phone 065 437 375 [timber mill] has applied to log Liverspool Range near East Bluff. If he has begun operations, his access track will probably pass within 200m of trig.

GEODETIC SURVEY OF NS.I.W.

CENTRAL MAPPING AUTHORITY

GEODETIC STATION RECONNAISSANCE and MAINTENANCE REPORT

Description: *Not clear*
 1. ~~Clear~~ by James bearing *Not clear* from Trig. Mast
 Note: *Cross out word or words which do not apply*

2. Mast & Vanes have been painted white & black respectively.
 3. The station ~~is not unspiled~~ not unspiled/constructed on *2.3rd Sept 19.20.*, dimensions now being:

Description of mark should be explicit, e.g., S/Steel Pillar Plate, Steel plug, Brass plug, Bolt, G.I. Pipe
 Height of mark m. ^{above} _{below} G.L.
 Height of Top Vanes to Top Mark/Pillar plate m. Diameter of Vanes (vertical) m.
 Height of Cairn m. Diameter of Cairn *2.0* m. Name Plate ~~found~~ not found/placed.

Length of Mast m. (approximate if not unspiled)
 4. *No witness marks found* set in conc/rock has been placed/found, bearing ° M from Mast/Plug/Pillar
 5. A set in conc/rock has been placed/found, bearing ° M from Mast/Plug/Pillar
 6. A set in conc/rock has been placed/found, bearing ° M from Mast/Plug/Pillar
 7. A set in conc/rock has been placed/found, bearing ° M from Mast/Plug/Pillar

8. Action required: *Place 2 witness marks 2-3 days to clear 360°*

STANDPOINT:

Mark	Observed	Horiz. Distance	Height Difference	Grid Direction	Mark	Horiz. Distance	Height Difference
Moan	91° 40'	5.5	above standpt Hill	217	25	below standpt	below standpt
Tereil	97 34	24.5	above standpt Hill	226	17	below standpt	below standpt
Wered	104 20	10.3	above standpt Hill	244	38	above standpt Hill	above standpt
Diamond	127 55	25.2	above standpt Hill	275	15	below standpt	below standpt
Borambit	227 46	32.6	above standpt Hill	262	26	below standpt	below standpt
Booyamurna	273 12	41.2	above standpt Hill			above standpt	above standpt
Black Mountain	338 31	13.0	above standpt Hill			below standpt	below standpt

Prepared by: *J. Fanning* Checked: *R. Holden* Noted on U.T.M. Card

SI 2733-1

STATION: **EAST BLUFF** TS 6783 No.: *1924*
 MAP SHEET SCALE 1:250 000
 INSPECTED BY: **J. FANNING** DATE: **23rd Sept 20**
 AUTHORITY: **C.M.A. NSW 229** FIELD BOOK: **1877**

Station Diagram
 Not to Scale
 Mag North
 Horizon blocked
 190°
 100m
 G.S.
 205°
 25°
 Horizon blocked by ridge

GS 24

STATION EAST BLUFF G.S. TS. 6783

Owner's Name: Trig Records N° 49174
 Address: Porton 237
 Phone: Uralla
 Current Occupant: Crown Lease to John Carols
 Address: Salisbury Court
 Phone: (087) 784654

ACCESS

No Access Report of 23.11.1988, was found ~~unsatisfactory~~
 D.O P.O Merriwa travel west towards Casanils
 25.16 Cross "Kuri River"
 26.47 Turn right follow road
 Iron gate
 62.84 Blazed trees on track. Follow blazed trail East to top of ridge
 make way along ridge to small cliffs. Leave vehicle here WALK
 along ridgeline to trig. Approx 6 km


WALK 2 HOURS VERY DIFFICULT
 NO LOAD

NOTE

Area around G.S. is not under "Protected Land". Therefore there are no
 restraints on clearing. To avoid environmental protection groups in
 area. Advise lane clearing be carried out 8 not 360° clearing

Date	Record of Station

SI 2733-2-D, West, Government Printer

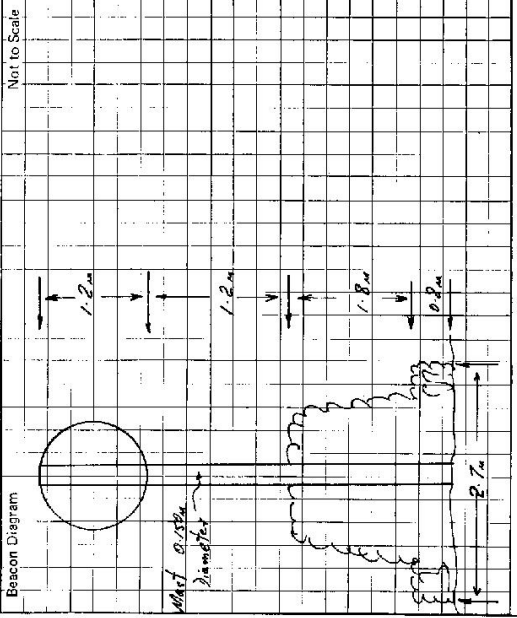

This section to be completed by officer constructing pillar.
 Original station mark found/not found.
 Description of mark:
 Original beacon found/not found.
 Description of beacon:
 Height Top of Vanes to Top Mark m.
 Height of mark m. above G.L. below G.L.
 Diameter of Vanes m. Height of Cairn m.
 Original Beacon has/has not been destroyed by me.

GEODETIC SURVEY OF N.S.W.

CENTRAL MAPPING AUTHORITY

GEODETIC STATION RECONNAISSANCE and MAINTENANCE REPORT

Description:

Note: Cross out word or words which do not apply

1. Cleared by lanes bearing..... from Trig. Mast
2. Mast & Vanes have been painted white & black respectively.
3. The station/pillar was unpiled/not unpiled/constructed on.....19....., dimensions now being:
Description of mark.....should be explicit, e.g., S/Steel Pillar Plate, Steel plug, Brass plug, Bolt, G.I. Pipe
Height of mark.....m. ^{above} rock/concrete; Mark is.....m. ^{above} G.L.
Height of Top Vanes to Top Mark/Pillar platem. Diameter of Vanes (vertical).....m.
Height of Cairn.....m. Diameter of Cairn.....m. Name Plate found/not found/placed.
Length of Mastm. (approximate if not unpiled)
4. A.....set in conc/rock has been placed/found, bearing.....° M from Mast/Plug/Pillar
5. A.....set in conc/rock has been placed/found, bearing.....° M from Mast/Plug/Pillar
6. A.....set in conc/rock has been placed/found, bearing.....° M from Mast/Plug/Pillar
7. A.....set in conc/rock has been placed/found, bearing.....° M from Mast/Plug/Pillar
8. Action required:.....

STANDPOINT:

Mark	Direction	Horiz. Distance	Height Difference	Mark	Direction	Horiz. Distance	Height Difference
			above standpt.				above standpt.
			below				below
			above standpt.				above standpt.
			below				below
Prepared by: Michael Clark, 21-0-8. Checked:

Noted on U.T.M. Card *Shullington 4/8/81* Checked

SI 2738-1

STATION: East Bluff No. 6783 No. 1924

MAP SHEET SCALE 1:250 000 TAPWORTH

INSPECTED BY: M CLARK DATE: 16/2/81

AUTHORITY: CMA FIELD BOOK:

Station Diagram

Not to Scale

GS 24

<p>ST 2732-2 D. West, Government Printer</p> <p>Beacon Diagram</p> <p style="text-align: right;">Not to Scale</p>	<p>STATION</p> <p>ENST GLOFF (N) IS: 6783</p> <p>Owner's Name: <i>Trig Reserve No 1974</i></p> <p>Current Occupant: <i>John Croft</i></p> <p>Address: <i>Salisbury Court</i></p> <p>Phone: <i>(087) 704654</i></p> <p>Phone: <i>Shalla</i></p> <p>Phone: <i>(087) 704654</i></p> <p>ACCESS</p> <p>Access Report # 11111981 was found autotablet-inhabitable</p> <p><i>Alternative</i></p> <p>0.0 <i>Carilah Valley Hotel</i></p> <p>1.72 <i>Turn left Sp</i></p> <p>20.24 <i>Turn right Sp</i></p> <p>44.47 <i>Pass turnoff on left to Bundella C.S.</i></p> <p>58.71 <i>Take left fork</i></p> <p>59.55 <i>Blazed trees on track. Follow blazed trail East to top of ridge</i></p> <p>61.26 <i>make way along ridge to small cliffs. Leave vehicle here. Walk along ridgeline to trig. Approx 6 km (Follow fence for abt 4km)</i></p> <p><i>Blazed trees on track. Follow blazed trail East to top of ridge</i></p> <p><i>make way along ridge to small cliffs. Leave vehicle here. Walk along ridgeline to trig. Approx 6 km (Follow fence for abt 4km)</i></p> <p><i>2 hours difficult walk no load</i></p> <p>No Access Report of/19..... was found</p> <p>0.0 <i>P.O. Murrumbidgee</i></p> <p>25.16 <i>Cross Keri River</i></p> <p>26.47 <i>Turn right follow road</i></p> <p>62.84 <i>Blazed trees on track. Follow blazed trail East to top of ridge</i></p> <p><i>make way along ridge to small cliffs. Leave vehicle here. WALK</i></p> <p><i>along ridgeline to trig. Approx 6 km (Follow fence for abt 4km)</i></p> <p>WALK 2 HOURS VERY DIFFICULT</p> <p>NO LOAD</p>
<p>This section to be completed by officer constructing pillar.</p> <p>Original station mark found/not found.</p> <p>Description of mark: <i>BRASS BACK FOR CANTONMENTS</i></p> <p>Original beacon found/not found.</p> <p>Description of beacon: <i>CAIRN MADE OF BRICKS</i></p> <p>Height Top of Vanes to Top Mark:m.</p> <p>Height of mark: <i>5.5m</i> above conc. pt. <i>above G.L.</i></p> <p>Diameter of Vanes: <i>1.20m</i> Height of Cairn:m.</p> <p>Original Beacon has/not been destroyed by ms. /</p>	<p>STATION</p> <p>ENST GLOFF (N) IS: 6783</p> <p>Owner's Name: <i>Trig Reserve No 1974</i></p> <p>Current Occupant: <i>John Croft</i></p> <p>Address: <i>Salisbury Court</i></p> <p>Phone: <i>(087) 704654</i></p> <p>Phone: <i>Shalla</i></p> <p>Phone: <i>(087) 704654</i></p> <p>ACCESS</p> <p>Access Report # 11111981 was found autotablet-inhabitable</p> <p><i>Alternative</i></p> <p>0.0 <i>Carilah Valley Hotel</i></p> <p>1.72 <i>Turn left Sp</i></p> <p>20.24 <i>Turn right Sp</i></p> <p>44.47 <i>Pass turnoff on left to Bundella C.S.</i></p> <p>58.71 <i>Take left fork</i></p> <p>59.55 <i>Blazed trees on track. Follow blazed trail East to top of ridge</i></p> <p>61.26 <i>make way along ridge to small cliffs. Leave vehicle here. Walk along ridgeline to trig. Approx 6 km (Follow fence for abt 4km)</i></p> <p><i>Blazed trees on track. Follow blazed trail East to top of ridge</i></p> <p><i>make way along ridge to small cliffs. Leave vehicle here. WALK</i></p> <p><i>along ridgeline to trig. Approx 6 km (Follow fence for abt 4km)</i></p> <p>WALK 2 HOURS VERY DIFFICULT</p> <p>NO LOAD</p>

CENTRAL MAPPING AUTHORITY

GEODETIC SURVEY OF M.S.W.
 GEODETIC STATION RECONNAISSANCE and MAINTENANCE REPORT

Description:

1. Cleared by lanes bearing 210° to 331° , 16° to 110° W.A. Note: Cross out word or words which do not apply from Trig. Mast

2. Mast & Vanes have been painted white & black respectively.

3. The ~~station~~ pillar was ~~erected~~ not ~~erected~~ constructed on 22° to 4° , 19° to 10° , dimensions now being:

Description of mark ~~erected~~ ~~erected~~ should be explicit, e.g., S/Steel Pillar Plate, Steel plug, Brass plug, Bolt, G.I. Pipe

Height of mark \dots m. above rock/concrete; Mark is \dots m. above G.L.

Height of Top Vanes to Top Mark/Pillar plate \dots m. Diameter of Vanes (vertical) \dots m.

Height of Cairn \dots m. Diameter of Cairn \dots m. Name Plate found/not found/placed.

Length of Mast \dots m. (approximate if not unpled)

4. A. \dots set in conc/rock has been placed/found, bearing \dots° M from Mast/Plug/Pillar

5. A. \dots set in conc/rock has been placed/found, bearing \dots° M from Mast/Plug/Pillar

6. A. \dots set in conc/rock has been placed/found, bearing \dots° M from Mast/Plug/Pillar

7. A. \dots set in conc/rock has been placed/found, bearing \dots° M from Mast/Plug/Pillar

8. Action required: ~~May need~~ ~~Surveyors~~ ~~with~~ ~~Measurements~~ ~~to~~ ~~be~~ ~~done~~ ~~some~~ ~~re-erect~~

STANDPOINT:


Mark	Direction	Horiz. Distance	Height Difference	Mark	Direction	Horiz. Distance	Height Difference
			above standpt.				above standpt.
			below				below
			above standpt.				above standpt.
			below				below
Prepared by: *[Signature]*

Checked:

Noted on U.T.M. Card

Sr 2793-1

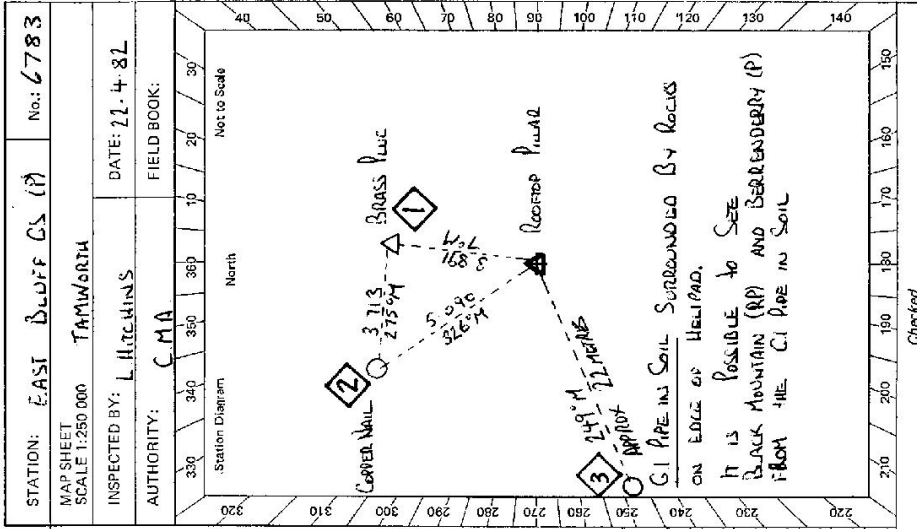

Checked