

GS 24

STATION GORA GILLA TS 6784	
<p>Owner's Name: TR 48040</p> <p>Address:</p> <p>Phone:</p>	<p>Current Occupant: Mr. F.A. Rice</p> <p>Address: "Bairns brae"</p> <p>Via: Ulamambi</p> <p>Phone:</p> <p style="text-align: center;">ACCESS 11-7-1979</p> <p>Access Report of...../1956 was found unsuitable/unsuitable.</p> <p>0.0 From Tambar Springs P.O. head towards Gunnedah.</p> <p>2.85 Turn left on road signposted Coonabarabran 58km, Mullaley 27km, Gunnedah 66km, Tambar Springs 3km; Coolah 60 km.</p> <p>8.35 Turn left at road signposted Oxley Highway 24km, Rocky Glenn 40, Tambar Springs 9, Premier 26, Coonabarabran 56, Pottlewagh 32.</p> <p>13.55 At quarry on right, turn right through quarry.</p> <p>15.15 At end of quarry stop vehicle.</p> <p>Follow ridgelines to Trig - 20 minutes walk (easy).</p>
<p>km</p>	<p>Date</p> <p>Record of Station</p>
<p>This section to be completed by officer constructing pillar.</p> <p>Original station mark found/not found.</p> <p>Description of mark:</p> <p>Original beacon found/not found.</p> <p>Description of beacon:</p> <p>Height Top of Vanes to Top Mark m.</p> <p>Height of mark m. above/below rock/cone</p> <p>Diameter of Vanes m. Height of Cairn m.</p> <p>Original Beacon has/has not been destroyed by me.</p>	

CENTRAL MAPPING AUTHORITY

GEODETIC SURVEY OF R.S.W.

GEODETIC STATION RECONNAISSANCE and MAINTENANCE REPORT

Description:


1. Cleared by lances bearing $S88^{\circ}$ to 230° 163° to 10° 21° to $S4^{\circ}$ MAG from Trig. Mast
Note: Cross out word or words which do not apply
2. Mast & Vanes have been painted white & black respectively.
3. The station/pillar was ~~upplied/not supplied~~/constructed on 26.11 19.81 , dimensions now being:
Description of mark: ~~SSM No 147~~ 19.81 should be explicit, e.g., S/Steel Pillar Plate, Steel plug, Brass plug, Bolt, G.I. Pipe
Height of mark 1.372 1.520 1.520 1.520 m. above ~~rock~~ 1.520 1.520 m. above G.L.
Height of Top Vanes to Top Mast/Pillar plate 1.445 m. Diameter of Vanes (vertical) 0.760 m.
Height of Cairn 0.760 m. Diameter of Cairn 0.760 m. Name Plate ~~found/not found~~/placed.
Length of Mast 0.760 m. (approximate if not unplied)
4. ~~SSM No 147~~ 19.81 set in ~~conc~~/rock has been ~~placed~~/found, bearing 126° 126° M from Mast/Plug/Pillar
5. SSM No 147 set in ~~conc~~/rock has been ~~placed~~/found, bearing 198° 198° M from Mast/Plug/Pillar
6. A set in ~~conc~~/rock has been ~~placed~~/found, bearing 282° 282° M from Mast/Plug/Pillar
7. A set in ~~conc~~/rock has been ~~placed~~/found, bearing 287° 287° M from Mast/Plug/Pillar
8. Action required:

STANDPOINT: SS PILLAR PLATE				STANDPOINT: SSM TRIG. PIN			
Mark	Direction	Horiz. Distance	Height Difference	Mark	Direction	Horiz. Distance	Height Difference
TAMBAR CS (P)	060 000	060 000	above standpt	TAMBAR CS (P)	060 000	060 000	above standpt
BRASS BRG PIN	24 45 40	4 330 7 404	above standpt	SSM No 147	150 32 25	4 987 0 384	below standpt
SSM No 147	95 30 30	4 286 7 789	below standpt	SS PILLAR PLATE	104 45 15	4 329 1 407	above standpt
GARRAVILLA CS (P)	243 26 50	243 26 50	below standpt	GARRAVILLA CS (P)	243 26 10	243 26 10	above standpt
			above standpt				below standpt
			below standpt				above standpt
			above standpt				below standpt
			below standpt				above standpt
			above standpt				below standpt
			below standpt				above standpt

Prepared by: *[Signature]*

Checked: *[Signature]*

Notes on U.T.M. Card

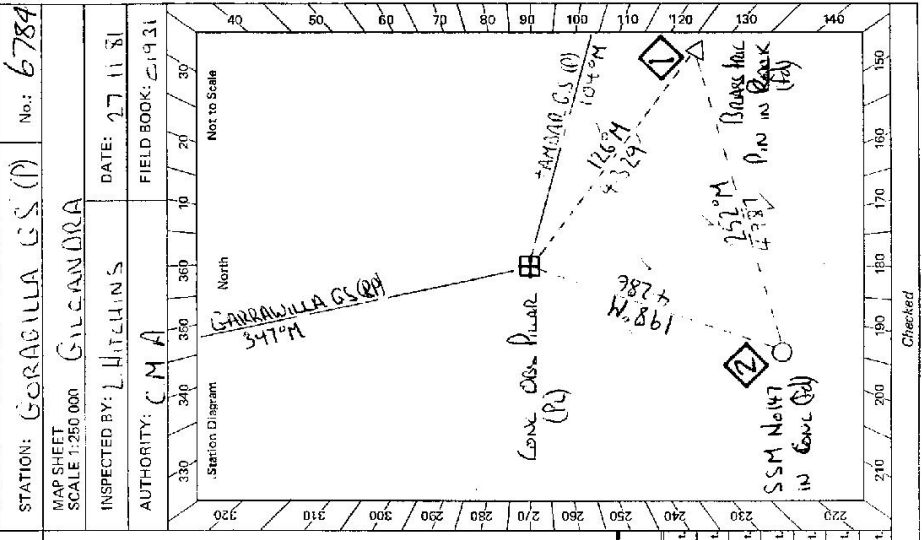

Checked

GS 24

<p>88 2733--2 D. West, Government Printer</p>	<p>STATION GORABALLA G.S. (P) TS 6784</p> <p>LE SAIE & ACCESS CAMPUS GEMMANGANGA Address: "SARANSORAE" SARLEWAUCH VIA GORABALLA</p> <p>Phone:</p> <p>ACCESS 27-11-1981</p>	<p>Owner's Name: TRIC. RESERVAE</p> <p>Address: TAMWORTH LBO</p> <p>TR 4804C</p> <p>Phone:</p> <p>Access Report of 11/1181 was found not suitable/unsuitable.</p>	<p>LEAD SOUTH ALONG HIGHWAY.</p> <p>TURN LEFT ONTO PURLEWAUCH ROAD</p> <p>PASS THROUGH PURLEWAUCH</p> <p>TURN LEFT ONTO GUNDEL ROAD GEN TAMBAR SPRINGS</p> <p>TURN RIGHT S/CN "TAMBAR SPRINGS"</p> <p>PASS TRACK TO OWNERS HOUSE ON LEFT [0.95 ALONG TRACK AND 0.30 ON LEFT CALL IN]</p> <p>TURN LEFT ONTO TRACK AT BLAZED TREE BEFORE BOUNDARY.</p> <p>TURN RIGHT ONTO BUSH TRACK AT BLAZED TREE</p> <p>POSSIBLY NEED TO WINCH HERE</p> <p>GORABALLA G.S. (P)</p>	<table border="1" style="width:100%; border-collapse: collapse;"> <tr> <th style="width: 10%;">Not to Scale</th> <th style="width: 90%;">Record of Station</th> </tr> <tr> <td style="text-align: center;">0.070</td> <td></td> </tr> <tr> <td style="text-align: center;">0.760</td> <td></td> </tr> <tr> <td style="text-align: center;">0.695</td> <td></td> </tr> <tr> <td style="text-align: center;">1.370</td> <td></td> </tr> <tr> <td style="text-align: center;">0.150</td> <td></td> </tr> </table>	Not to Scale	Record of Station	0.070		0.760		0.695		1.370		0.150	
Not to Scale	Record of Station															
0.070																
0.760																
0.695																
1.370																
0.150																
<p>This section to be completed by officer constructing pillar.</p>																
<p>Original station mark found not found.</p>																
<p>Description of mark: BOSS TRIC. PIN IN ROCK</p>																
<p>Original beacon found not found.</p>																
<p>Description of beacon: CAIRN POLE + DISK</p>																
<p>Height Top of Vanes to Top Mark: 3.630 m.</p>																
<p>Height of mark: 0.76 m. ^{above} rock/stone. at ^{above} G.L. _{below}</p>																
<p>Diameter of Vanes: 0.750 m. Height of Cairn: 2.880 m.</p>																
<p>Original Beacon has not been destroyed by me.</p>																