
CENTRAL MAPPING AUTHORITY	ING AUTHORITY		GEODETIC SUF	GEODETIC SURVEY OF N.S.W.	ı			_	
	GE	ODETIC STATION	RECONNAISSANCE	GEODETIC STATION RECONNAISSANCE and MAINTENANCE REPORT	EPORT	STATION: MAAA	STATION: MGAN ROOF. TOP UBS PILLE	6 Pllac No. 6785	785
Description: 1. Cleared by lanes	Description: 1. Cleared by Janes hearing	Me primit	ote: Cross out word or	Note: Cross our word or words which do not apply !!	ly sither	MAP SHEET SCALF 1:250 000 AM MG A INSPECTED BY: D. T. KALL	T KAIS	DATE: 12 Normal	24
2. Mast & Vanes ha	ave been painted white	ধ black respectivel)	\ \ \ \ \ \ \ \ \ \ \ \ \ \ \ \ \ \ \	2. Mast & Vanes have been painted white & black respectively.		AUTHORITY:	V. Maid.	FIELD BOOK: 1827	- C
3. The starten/pills	ar was with the truck with	dia d/constructed on.	9. November 19. 8	I, dimensions now bein	Г :Б	330 340	360	/ pc / pc / pl	
Description of m	nark, Pillar PLK (2) sin	ould be explicit, e.g.	., S/Steel Pillar Plate, St	eel plug, Brass plug, Bolt		Station Diagram	North	Not to Scale	4
Height of mark	Height of markk.3.15m. actor coek/concrete;	k/concrete;	Mark is	above G.L.	/_		3. Park		٧
Height of Top V	Height of Top Vanes to Top Mack/Pillar plate13.75m.	ar plate 1.375		Diameter of Vanes (vertical)ヿ゚ゔ゙゚゙゙゙゙゙゙゙゙゙゙゙゙゙゙゙゙゙゙゙゙゚゚゙ゕ゚゚m.		/ 0	55 M	₹	\ !
Height of Cairn.	Height of Caimm.		Diameter of Cairnm.	Name Plate fourth/not found/placed.		16 /	 hr(0)	S () () () () () () () () () (50,
Length of Mast.	1.465 v m.	(approximate if no	Eumpile d)			00	two for		/ 6
4. A. ST/ST. 10	F. P.13 set in como/re	ock has been p lane d?	/found, bearing. 357	4. A.St. St. Joy. P. V. set in conc. rock has been pleased found, bearing. 357 on from Mast Plug. Pillar		,,	(Salst fee P.) 2 2	E. St.	ie /
5. A / 5.S.	M. set in cone/re	ock has been p hae ed/	/found, bearing33	°M from M asst/Plu g/Pill		16ź /	\$\langle \chi \chi \chi \chi \chi \chi \chi \chi	**************************************	7p \
6. A	set in conc/rc	ock has been placed/	/found, bearing	A	,	08z	MISSE	9	80
7. A	set in conc/rd	ock has been placed	/found, bearing	7. Aset in conc/rock has been placed/found, bearing"M from Mast/Plug/Pillar		NICAM CO.	Noan.	Waxers as	90
8. Action required:				8. Action required:		lei coox	obs filler.)	i.	100
STANDPOINT:	STANDPOINT: Rood-Tor Obs	Pillar.	STANDPOINT:	ST. STARL THE DIS	Ì	700			<u>) </u>
Mark	Direction Distance	Height Difference	Mark	Direction Distance	Height Difference	SE SE			y10 /
WERE O RT. (P) O DO OO	, 00 00 , 0	ahove standpt.	WEREIN 841 (P)	, 0 00 00	1	240		25	120
Parry R/T (P) 253 29 40	253.29.40	above standpt. below		253 22 65	_ \				Z
ST ST 1/19 D.A.	264 43 46 1321	1.247 below		32 13 30 2.670	499 topow standpt.	sác			130
S. S. M. C.	5. S. M. 1 299 43 25 3 435	1.747	Mr. Bos (P)	320 45 10	above standpt,				
MT. Boo (P) 320 46 00	320 46 00		1	NOTE: - REASON FOR NO COSUNATIONS	above standpt.	-			
		above standpt.		The CLASE for Instrument	HUCLES HELOW STANDER,	ez			40
		above standpt.	- -		above standpt.	2,10 / 200	1 180 1 180 /	150 160 150	
Prepared by:		Checked:	35.0	Noted on U.T.M. Card	T.M. Card		Checked		
1 2733 1			7						

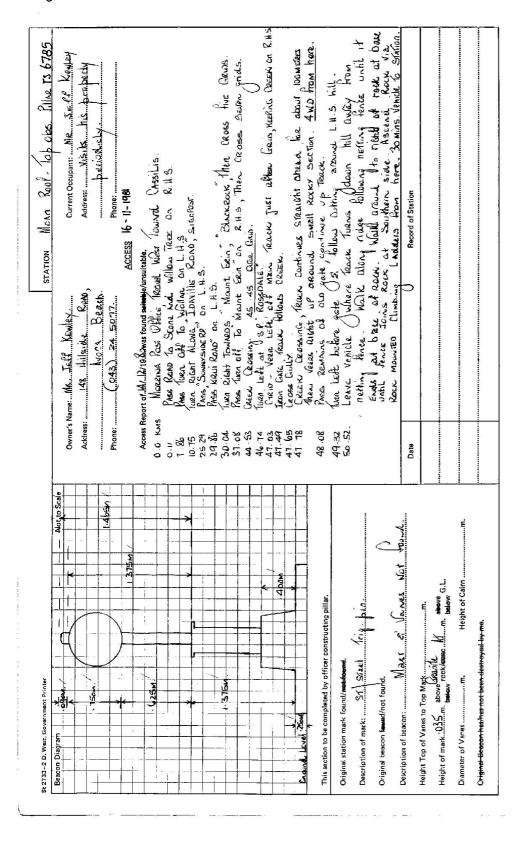

CENTRAL MAPF	CENTRAL MAPPING AUTHORITY			GEODETIC SURVEY OF M.S.W	VEY OF N.S.W.		_				
		GEO	DETIC STATION	GEODETIC STATION RECONNAISSANCE and MAINTENANCE REPORT	ind MAINTENA	ANCE REPO	JRT	STATION:	MOAN (P)	No.:	6785
Description:		,		Note: Crass out word ar words which do not apply	vords which do	not apply		MAP SHEET SCALE 1:250 000	OO TAMWORTH		
1. Cleared by lane	Cleared by lanes bearing	360		•	from Trig. Mast	g. Mast		INSPECTED BY:	: G. FOKP	DATE: 2 - /2 -	12 - 82
2. Mast & Vanesh	Mast & Vanes have been painted white &	i white &	black respectively.	٠٠٠/				AUTHORITY:	C. M.A.	FIELD BOOK:	1
3. The station/pill	lar was unpiled/no	ot unpile	d/constructed on.	The station/pillar was unpiled/not unpiled/constructed on	, dimensions n	ow being:		330		/ pz / dı	,óc
Description of r	mark fool for Pull	nous "suon	ild be explicit, a.g.	Description of mark الإسرائيل الإسرائيل المناطقة و Systeel Pillar Plate, Steel plug, Brass plug, Bolt, G.I. Pipe	eel plug, Brass p	ilug, Bolt, C	3.1. Pipe	Station Diagram	ram North	Not to Scale	
Height of mark	Height of markm. m. below rock/concrete;	ove low rock/e	concrete;	Mark is G.L.	bove G.L.						o .
Height of Top 1	Vanes to Top Mer	#k/Pillar ;	Height of Top Vanes to Top Mark/Pillar plate		Diameter of Vanes (vertical)750 m.	cal) 0.7s	.m.m.	7 0,			'
Height of Cairn	Height of Cairn	Ë	Diameter of Ca	Diameter of Cairnm.	Name Plate found/not found/placed.	d/not foun	d/placed.	16 /			šo
Length of Mast		Ę	Length of Mastm. (approximate if not unpiled)	t unpiled)				200	Ment) ė(
4. A	Aset in conc/rock	conc/roc		has been placed/found, bearing" M from Mast/Plug/Pillar	°M from Mast/	/Plug/Pillar		/ OI	MEW MARK	* VANC	8 7
5. A	Aset in conc/rock	conc/roc		has been placed/found, bearing"M from Mast/Piug/Pillar	°M from Mast	/Plug/Pillar	·	şź /	ONKY		<u> </u>
6. A	Aset in conc/rock	conc/roc		has been placed/found, bearing" M from Mast/Piug/Pillar	°M from Mast	/Piug/Piltar		oġz			80
7. Aset in conc/rock	set in c	conc/roc		has been placed/found, bearing" M from Mast/Piug/Pillar	°M from Mast	/Plug/Pillar		ożz	+		90
8. Action required:	£							şen			100
STANDPOINT:				STANDPOINT:				Os			1
Mark	Direction	Horiz. Distance	Height Difference	Mark	Direction	Horiz. Distance	Height Difference	ş			jio /
			above standpt				above below standpt.	540			120
			above standpt.				above below standpt.	<u></u>			_
	J		above standpt.				above below standpt.	oèz			<u>130</u>
			above standpt.				above standpt.	_			
			above below standpt.				below standpt.				
			ubove standpt. below				above standpt.	टट्			<u>46</u>
			above standpt.		-		above standpt.	7 012	180	170 160	150
Prepared by:	6 Fond		Cheuked:	Land Mayor	14/1/83 NOT	188 Noted on U.T.M. Card &	4	anning 26 ge	en 63 Checked		
St 2733-1	7			F	11		,	,			

STATION MOAN (?) TS 6785	Address:	Record of Station		
	Owner's h Address:	Date		
St 2733-2 D. West, Government Printer	Beacon Diagram 6.750 7.375 This section to be completed by officer constructing pillar. Original station mark found/not found. Original beacon found/not found.	Description of beacon:	ck/conc	Ulameter of Vanesmmm. Usiginal Beacon has/has not been destroyed by me.