

STATION WICKHAM T.S. 6791

Owners Name..... Current Occupant.....

Address..... Address.....

Miles 1/5/1975

ACCESS
 0-0 SANDY HOLLOW P.O. TRAVEL TOWARDS MERIWA.
 0-65 BRIDGE OVER GIANTS CREEK
 1-1 TURN RIGHT OVER GRID.
 2-7 GRID
 3-4 GRID
 4-3 GRID
 5-1 GRID
 5-65 GRID
 5-7 GRID


9th March, 1972
 H.P. R. Hills

TURN RIGHT THRU WOODEN POSTS & FOLLOW FAINT TRACK TO CREEK
 (NEW FENCE BEING CONSTRUCTED ALONG ROAD)
 NATURAL CREEK CROSSING (Rock bottom, possible to cross in Hobbs S/Section)
 Year to right, keeping small rocky knob on L.H.S. Drive to fence at base of
 steep ridge. (Hobbs Tree in line with Natural Crossing - rocky knob)
 From fence follow first blazed line up rocky face of hill veering to right as you go.
 When you reach top follow blazed track in northerly direction thence easterly thru a
 saddle, stay in center of ridge. Thence follow blazed track in a northerly direction
 to T.R.C. WALKING TIME: 30 mins without load
 60 mins with load.

Paul Naylor 1/5/75.

Not to Scale

Station Diagram

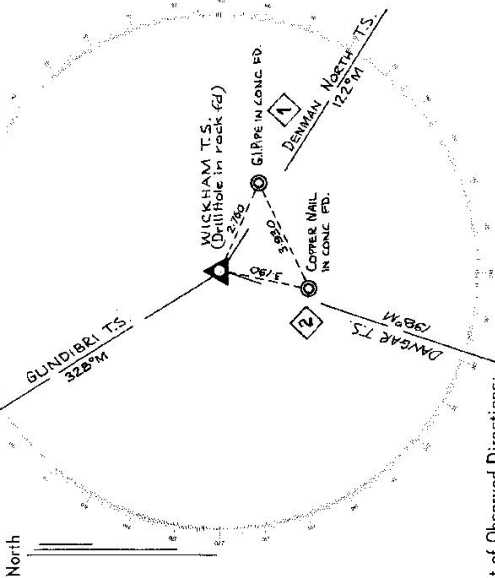

List of Observed Directions:-

Standpoint: DRILL HOLE IN ROCK FD. Standpoint: DRILL HOLE IN ROCK FD.

Station	Direction	Station	Direction
DANGAR T.S.	359° 59' 60"	DANGAR T.S.	359° 59' 60"
GUNDBEL T.S.	123° 15' 21.3"	GIPIPE IN CONG. PD.	224° 23' 10"
DENIMAN NORTH T.S.	283° 02' 54.0"	COPPER NAIL IN CONG. PD.	356° 45' 26"

Station	Direction	Station	Direction

GS 24

<p>STATION WICKHAM (P) TS 6791</p>	<p>Owner's Name: Address: Phone:</p> <p>Current Occupant: Address: Phone:</p> <p style="text-align: center;">ACCESS</p> <p>Access Report of...../19.....was found suitable/unsuitable.</p>
<p>Not to Scale</p>	<p>This section to be completed by officer constructing pillar.</p> <p>Original station mark found/not found.</p> <p>Description of mark: DRILL HOLE IN BRICK PAVEMENT</p> <p>Original beacon found/not found.</p> <p>Description of beacon:</p> <p>Height Top of Vanes to Top Markm.</p> <p>Height of mark 0.05m above rock/enc. ATm. ^{above} below G.L.</p> <p>Diameter of Vanesm. Height of Cairnm.</p> <p>Original Beacon has/has not been destroyed by me.</p>
	<p>Date</p> <p>4-11-81</p>
	<p>Record of Station</p> <p>DRILL MARK - HOLE IN ROAD HAS BEEN DRILLED OUT AND A STAINLESS STEEL PIN HAS BEEN RACED ✓</p>

GS 24

STATION Widdowin C.S. TS 6791	Owner's Name: Mr. Maxims Moyses Address: Spring Hill Phone: 47 4512 ACCESS 29-9-1981
Owner's Name: Valiant Cream Landa Address: Maitland L.B.D. Phone: (049) 33-7790	Access Report of 19/10/81 was found suitable/ unsuitable . FEATURES: Sandy Hollow Post Office, Take Road to Merriwa. Giants Creek Bridge. Turn Right and over (road) Sign Pretty Bend Farm. Take General Track to right (Access/owners house boom along bitumen on right). Creek Crossing. House at highway on left. Gate. Creek Crossing. 4.05 - 4.15, 4.35, Fence openings. 4.60, 4.7, 4.8, fence openings. 4.90, Fence on right. 5.4, Fence on left. 6.25 Old Creek Crossing 6.40 Creek Crossing. 6.50 Creek Crossing. Through opening in fence follow fence keep on your left. 6.60 Cross gully & follow track to left. 11.00 Stop at PLAZED pine trees. Walk HP ROCKS IN RIGHT & FOLLOW BLAZES TO C.S. (DO NOT WALK WITHOUT LEAD)
Beacon Diagram Milemark Access from Merriwa Feature 0.0 Merriwa Post Office Take Road to Denman 23.05 General Post Office 23.70 Railway Crossing 24.15 General Bridge 24.7 Turn left and over Road & over road 25.85 Turn right and bitumen road 26.95, 28.45, 29.4 Grass 30.45 Access under on left 30.60 Take General Road on left. This point is 2.95 kms. on Sandy hollow access	This section to be completed by officer constructing pillar. Original station mark found/not found. Description of mark: Original beacon found/not found. Description of beacon: Height Top of Vanes to Top Mark.....m. Height of mark.....m. above G.L. below Diameter of Vanes.....m. Height of Cairn.....m. Original Beacon has/has not been destroyed by me.