


STATION: **NEENAH** 6793
 No: **10740**

MAP SHEET
 SCALE 1:250 000 (M) ALL ACCEPTA
 INSPECTED BY: **S. GREENING** DATE: **14/5/80**

AUTHORITY: **D.M.R.** FIELD BOOK:

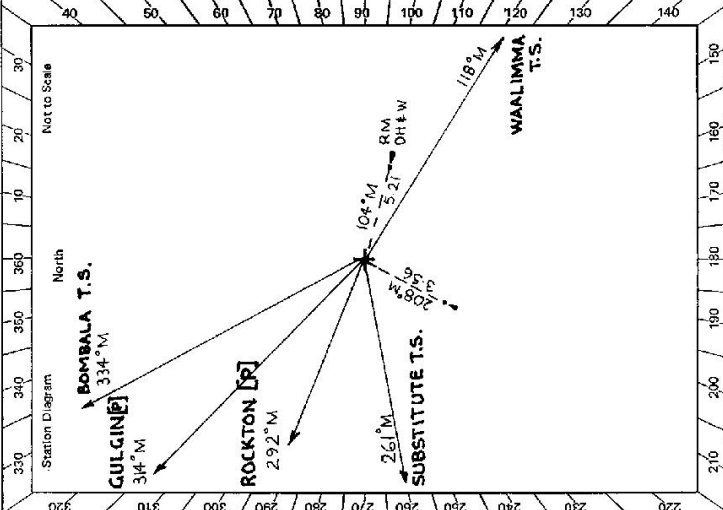

CENTRAL MAPPING AUTHORITY
 GEODETIC SURVEY OF N.S.W.
 GEODETIC STATION RECONNAISSANCE and MAINTENANCE REPORT

- Description: *Note: Cross out word or words which do not apply*
- Cleared by lanes bearing **250° to 338° 115° to 120° MAGNETIC** from Trig. Mast
 - Mast & Vanes have been painted white & black respectively.
 - The ~~station~~/pillar was ~~unplaced/not unplaced~~/constructed on **13/5/1980**, dimensions now being: **STEEL PILLAR** should be explicit, e.g., S/Steel Pillar Plate, Steel plug, Brass plug, Bolt, G.I. Pipe
 - Height of mark **1.47** m. ^{above} rock/concrete; Mark is **1.8** m. ^{above} G.L.
 - Height of Top Vanes to Top Mark/Pillar plate **1.53** m. Diameter of Vanes (vertical) **0.75** m.
 - Height of Cairn **N/A** m. Diameter of Cairn **N/A** m. Name Plate found/not found/placed.
 - Length of Mast **1.61** m. (approximate if not unplaced)
 - A. DH 4 1/2** set in ~~conc~~/rock has been placed/found, bearing **104°** M from ~~Mast/Plug~~/Pillar
 - A. DH 4 1/2** set in ~~conc~~/rock has been placed/found, bearing **208°** M from ~~Mast/Plug~~/Pillar
 - A.** set in conc/rock has been placed/found, bearing **°** M from Mast/Plug/Pillar
 - A.** set in conc/rock has been placed/found, bearing **°** M from Mast/Plug/Pillar
 - Action required:

STANDPOINT:		STANDPOINT:			
Mark	Direction	Horiz. Distance	Height Difference	Direction	Height Difference
SUBSTITUTE GS 0° 00' 00"			above standpt		above standpt
ROCKTON [P] 30° 24' 34"			below standpt		below standpt
DH 4 W ROCK 203° 43' 32"	5.21	1.48	below standpt		below standpt
DH 4 W ROCK 307° 39' 40"	3.56	1.51	below standpt		below standpt
			above standpt		above standpt
			below standpt		below standpt
			above standpt		above standpt
			below standpt		below standpt

Prepared by: **DMR** Checked: *[Signature]* *Noted on U.T.M. Card*

68

STATION KEENAH NUNGATTA MOUNTAIN [P] 6793	Owner's Name: NATIONAL PARKS Address: Phone: Current Occupant: Address: Phone: ACCESS Access Report of 14/5/1980 was found suitable/unsuitable. ACCESS BY HELICOPTER OR 4 HOUR TREK THROUGH ROUGH STEEP BUSHLAND FOLLOWING CREEKS AND RIDGES.
Beacon Diagram Not To Scale 	This section to be completed by officer constructing pillar. Original station mark found/not found. Description of mark: STEEL PILLAR Original beacon found/not found Description of beacon: Height Top of Vanes to Top Mark: 1.53 m. Height of mark: 1.43 m. above 0.2 m. below G.L. Diameter of Vanes: 0.75 m. Height of Cairn: STEEL PILLAR m. Original Beacon has/have not been destroyed by me.
Date 13/5/80	Record of Station ROOFTOP PILLAR ERECTED BY DMR HELIPAD & LINES CLEARED