


CENTRAL MAPPING AUTHORITY

GEODETIC SURVEY OF A.S.W. GEODETIC STATION RECONNAISSANCE and MAINTENANCE REPORT

STATION: *ROSENEATH* No.: *TS 6797*
 MAP SHEET SCALE 1:250 000 *MANILLA*
 INSPECTED BY: *W.R. HARRIS* DATE: *20-5-81*
 AUTHORITY: FIELD BOOK:

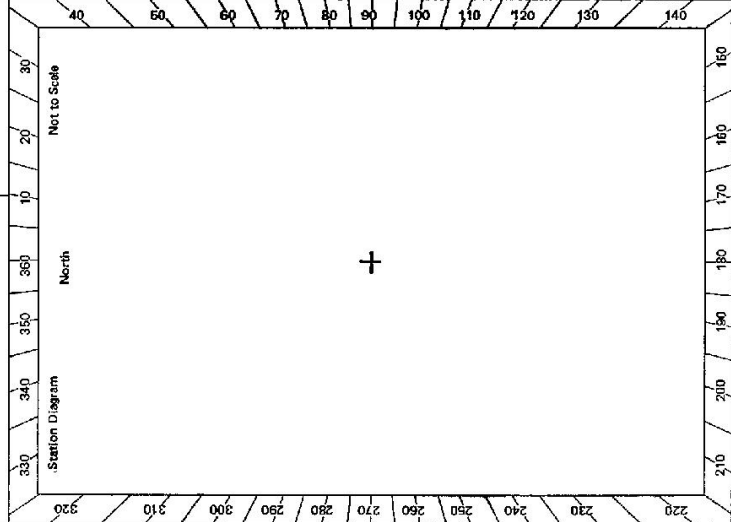

- Description:
- Cleared by lanes bearing..... *Note: Cross out word or words which do not apply*
 - Mast & Vanes have been painted white & black respectively.
 - The station/pillar was unpiled/not unpiled/constructed on.....19....., dimensions now being: Description of mark.....should be explicit, e.g., S/Steel Pillar Plate, Steel plug, Brass plug, Bolt, G.I. Pipe Height of mark.....m, ^{above}/_{below} rock/concrete; Mark is.....m, ^{above}/_{below} G.L.
 - Height of Top Vanes to Top Mark/Pillar platem. Diameter of Vanes (vertical).....m.
 - Height of Cairn.....m. Diameter of Cairn.....m. Name Plate found/hot found/placed.
 - Length of Mast.....*3.6*.....m. (approximate if not unpiled)
 - A.....*1.1*.....set in conc/rock has been placed/found, bearing.....°M from Mast/Plug/Pillar
 - A.....set in conc/rock has been placed/found, bearing.....°M from Mast/Plug/Pillar
 - A.....set in conc/rock has been placed/found, bearing.....°M from Mast/Plug/Pillar
 - A.....set in conc/rock has been placed/found, bearing.....°M from Mast/Plug/Pillar
 - Action required.....

STANDPOINT:			
Mark	Direction	Horiz. Distance	Height Difference
			above standpt.
			below standpt.
			above standpt.
			below standpt.
Prepared by: Checked:
 Noted on U.T.M. Card

SI 2733-2 D. West, Government Printer

STATION ROSENEATH (P) TS 6797

Owner's Name: M. J. MAXWELL Current Occupant:

Address: MANUKAWA Address:

Phone: HILLS CREEK Phone:


Phone: SHALBAY Phone: 22-12-1981

Access Report of: 19 ~~was found suitable/unsuitable~~

DIRECTION

K.M.

0-0 ROSENEATH RD HEAD BEACH ALONG NEW ENGLAND HIGHWAY ✓
 0-20 TURN RIGHT SIGN MARULLA ✓
 36-80 TURN RIGHT SIGN WATSONS CREEK (DANGER'S HOUSE STRAIGHT AHEAD: DUNN'S MARULLA
 38-00 CURVE ✓
 38-60 CURVE ✓
 38-70 TURN LEFT OFF MAIN RD CROSS CREEK + FOLLOW TRACK PAST CATTLE YARDS ✓
 39-10 CREEK CROSSING ✓
 39-45 IRONS GATE ✓
 39-60 FOLLOW TRACK BETWEEN SHED + HOUSE (AND CATTLE PAST) ✓
 39-85 IRONS GATE ✓
 40-00 PAST WOODSHED + USER LEFT ACCESS GULLY ✓
 40-25 IRONS GATE ✓
 40-80 IRONS GATE + FOLLOW TRACK STRAIGHT AHEAD PAST WOODMILL ✓
 40-95 CROSS GULLY ✓
 41-00 STRAIGHT AHEAD OFF RIDGE PAST KUMARATOUA TREE ✓
 41-20 TURN LEFT UP ANDR CONTINUA ✓
 IRONS GATES AT 42-40 + 43-50 ✓
 44-40 STRAIGHT AHEAD ✓
 45-20 TURN LEFT + FOLLOW TRACK TO RIDGE TO TRIG ✓
 45-30 ROSENEATH C.S. PILLAR ✓

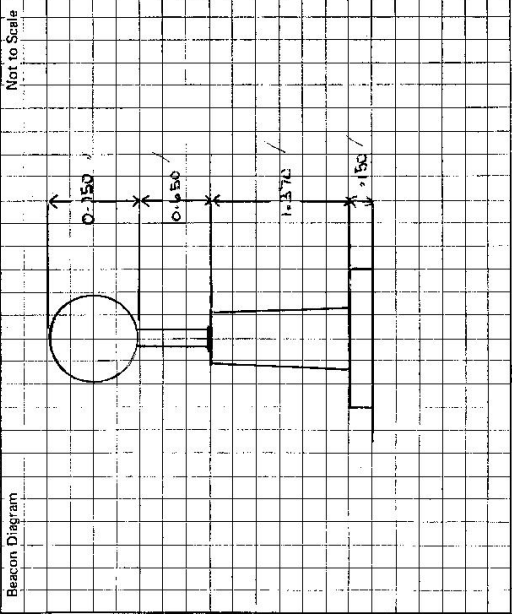

This section to be completed by officer constructing pillar.

Original station mark found/~~not found~~:

Description of mark: STEEL PILLAR WITH IRON CROSS ✓

Original beacon found/~~not found~~:

Description of beacon: CALC. CONCRETE PILLAR ✓

Height Top of Vanes to Top Mark: 3.62 m. ✓

Height of mark: 0.47 m. ^{above} ~~below~~ peak/conc. ^{at} ~~below~~ G.L. ✓

Diameter of Vanes: 0.15 m. Height of Cairn: 1.170 m. ✓

Original Beacon has/~~has not~~ been destroyed by me. ✓

Date:

Record of Station: