

CENTRAL MAPPING AUTHORITY

GEODETTIC SURVEY OF N.S.W.

GEODETTIC STATION RECONNAISSANCE and MAINTENANCE REPORT

Description:

1. Cleared by lanes bearing..... *Note: Cross out word or words which do not apply*
2. Mast & Vanes have been painted white & black respectively.
3. The station/pillar was unpiled/not unpiled/constructed on..... 19....., dimensions now being:  
Description of mark.....should be explicit, e.g., S/Steel Pillar Plate, Steel plug, Brass plug, Bolt, G.I. Pipe  
Height of mark.....m, above below rock/concrete; Mark is.....m, above below G.I.  
Height of Top Vanes to Top Mark/Pillar plate .....m. Diameter of Vanes (vertical).....m.  
Height of Cairn.....m. Diameter of Cairn.....m. Name Plate found/not found/placed,  
Length of Mast .....m. (approximate if not amplified)
4. A.....set in conc/rock has been placed/found, bearing.....° M from Mast/Plug/Pillar
5. A.....set in conc/rock has been placed/found, bearing.....° M from Mast/Plug/Pillar
6. A.....set in conc/rock has been placed/found, bearing.....° M from Mast/Plug/Pillar
7. A.....set in conc/rock has been placed/found, bearing.....° M from Mast/Plug/Pillar
8. Action required:.....

STANDPOINT:

Mark	Direction	Horiz. Distance	Height Difference	Mark	Direction	Horiz. Distance	Height Difference
			above standpt.				below standpt.
			below				above standpt.
			above standpt.				below standpt.
			below				above standpt.
Prepared by: *S. Hanna* 14/3/79

Checked: *KA*

Noted on U.T.M. Card

S:2783-1

STATION: **COCKROFT** No.: **1524**  
 MAP SHEET SCALE 1:250 000  
 INSPECTED BY: **G. C. HANNA** DATE: **14/2/79**  
 AUTHORITY: **C. M. A.** FIELD BOOK:


Station Diagram  
 North  
 Not to Scale

Checked





St 2753-2 D. West, Government Printer

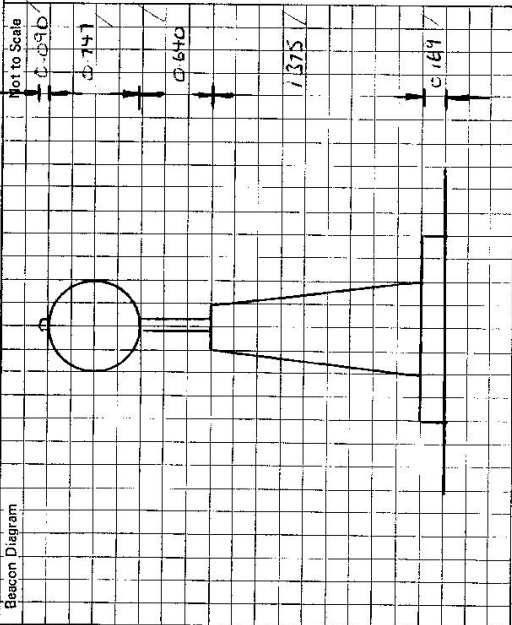

This section to be completed by officer constructing pillar.

Original station mark found/~~not found~~.

Description of mark: ROCK IN A ROCK

Original beacon found/~~not found~~.

Description of beacon: CAIRN POLE + DISCS

Height Top of Vanes to Top Mark: 3.545 m.

Height of mark: 0.65m above rock/~~same~~ 4.1m above G.L. below

Diameter of Vanes: 0.165 m.

Original Beacon has ~~been~~ been destroyed by me.

STATION <u>COCKROFT GS (P) IS 6799</u>	
Owner's Name: <u>THE RESERVE 48476</u>	ACCESS OWNER <u>Mr Ross Walker</u>
Address: <u>TAMWORTH, L.B.D.</u>	Address: <u>KOZKIEWICZ</u>
LEASE: <u>P. D. CARROLLS, BALLOONIE</u>	Phone: <u>CORLEWIS 6720</u>
Phone: <u>CORLEWIS 441507</u>	Phone: .....
ACCESS	
<p>Access Report of <u>17/1/1981</u> was found suitable for <u>access</u>.</p> <p>0-0 CORLEWIS PD HEAD TOWARDS RAILWAY LINE</p> <p>0-10 TURN RIGHT INTO RAILWAY STREET</p> <p>0-34 TURN RIGHT INTO PINE STREET</p> <p>1-16 TURN LEFT OPPOSITE YELLOW HOUSE</p> <p>1-33 TURN RIGHT</p> <p>3-26 PASS GAN ON LEFT "GREEN FIELDS ON RIGHT"</p> <p>5-71 TURN RIGHT AT "INTERSECTION"</p> <p>6-15 TURN LEFT INTO "ROCKWELL"</p> <p>6-43 PASS ACCESS OWNED HOUSE ON RIGHT</p> <p>Go THROUGH 1 FT IRON GATE TOWARDS HAYSHED</p> <p>6-54 PASS DAM ON RIGHT THROUGH IRON GATE</p> <p>6-68 TURN LEFT DOWN LANE</p> <p>6-94 TURN RIGHT THROUGH IRON GATE + FOLLOW FENCE ON RIGHT</p> <p>7-45 TURN LEFT FOLLOW FENCE ON RIGHT</p> <p>7-75 THROUGH IRON GATE ON RIGHT</p> <p>8-17 FOLLOW TRACK</p> <p>8-79 THROUGH WIRE GATE IN GAP</p> <p>9-11 TURN LEFT OFF TRACK AT "GRAZED FLEECE" SMALL DAM ON RIGHT TURN LEFT AT GRAZED FLEECE FOLLOW GRAZED TRACK</p>	<p>10-01 THROUGH SLIP RAILS TURN LEFT AND FOLLOW FENCE</p> <p>10-09 TURN RIGHT + MAKE WAY THROUGH LARGE PINEWOODS TO STRAIGHT ALLEYSIDE STAIRWAY IN CLEARING.</p> <p>11-27 FOLLOW CLEARING FENCE STRAIGHT ON AND BLAZES.</p> <p>11-91 TURN RIGHT AT FENCE FOLLOW FENCE AND BLAZES.</p> <p>12-58 TURN RIGHT FOLLOW BLAZES</p> <p>12-45 COCKROFT GS</p> <p>ACCESS 0 SHARPSHOUT 22/1/81</p>
Date	Record of Station

CENTRAL MAPPING AUTHORITY  
 GEODETIC SURVEY OF M.S.W.  
 GEODETIC STATION RECONNAISSANCE and MAINTENANCE REPORT

STATION: **COCK ROFT G.S. (P)** No.: **6799**  
 MAP SHEET SCALE 1:250 000  
 INSPECTED BY: **L. HITCHINS** DATE: **25.3.82**  
 AUTHORITY: **C.M.A.** FIELD BOOK: **01935**

Station Diagram

Not to Scale

Description: *Note: Cross out word or words which do not apply*

- Cleared by lanes bearing **340° to 348° + 40° to 50° MAG.** from Trig. Mast
- Mast & Vanes have been painted white & black respectively.
- The station/pillar was unpiled/not unpiled/constructed on .....19....., dimensions now being: Description of mark.....should be explicit, e.g., S/Steel Pillar Plate, Steel plug, Brass plug, Bolt, G.I. Pipe  
 Height of mark.....m. <sup>above</sup> rock/concrete; Mark is.....m. <sup>above</sup> G.L.
- Height of Top Vanes to Top Mark/Pillar plate .....m. Diameter of Vanes (vertical).....m.
- Height of Cairn.....m. Diameter of Cairn.....m. Name Plate found/not found/placed.
- Length of Mast.....m. (approximate if not unpiled)
- A.....set in conc/rock has been placed/found, bearing.....°M from Mast/Plug/Pillar
- A.....set in conc/rock has been placed/found, bearing.....°M from Mast/Plug/Pillar
- A.....set in conc/rock has been placed/found, bearing.....°M from Mast/Plug/Pillar
- A.....set in conc/rock has been placed/found, bearing.....°M from Mast/Plug/Pillar

8. Action required: **COMPLETE CLEARANCE; LANES + BACKLANES; CLEAR SOCKETS ALSO.**

STANDPOINT:

Mark	Direction	Horiz. Distance	Height Difference	Mark	Direction	Horiz. Distance	Height Difference
			above standpt.				above standpt.
			below				below
			above standpt.				above standpt.
			below				below
Prepared by: *[Signature]* Checked: *[Signature]* Noted on U.T.M. Card






St 2733-2 D. Winst. Government Printer

Beacon Diagram

Not to Scale

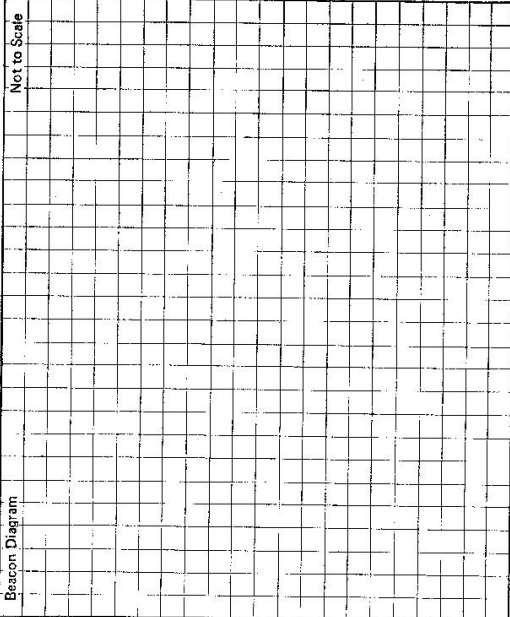

This section to be completed by officer constructing pillar.

Original station mark found/not found.

Description of mark: .....

Original beacon found/not found.

Description of beacon: .....

Height Top of Vane to Top Mark .....m.

Height of mark .....m. above rock/cone .....m. below G.L.

Diameter of Vane .....m. Height of Cairn .....m.

Original Beacon has/has not been destroyed by me.

STATION

Geck, rock

Pillar IS 6799

LESBE

Client/Owner: Mr. Peter G. Higgins

Address: BAHAMAS, GAILBERTS

Phone: MFA - 44 1507

Owner's Name: Sarah L. Smith

Address: L.A.M. Smith

Phone: (0107) 461 388

Phone: L.S.O.

ACCESS

Access Report of 12/17/19 was found suitable/unavailable.

Date

Record of Station