

75 103

STATION TS BAIRNE 681


Co: CUMBERLAND Ph: BROKEN BAY

Map Sheet: COAL & CANOLE CREEK No: U1875

Inspected by: J. L. FEITCHER Date: 23.1.74

Authority: DEPT. OF LANDS Field Book: 68L 68

Beacon Diagram Not to Scale

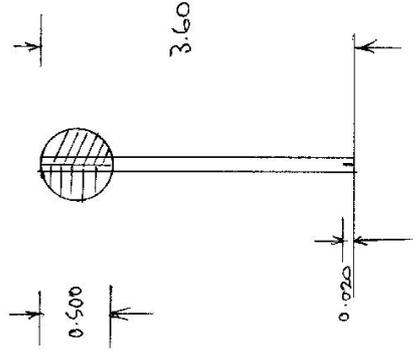

RECONNAISSANCE and MAINTENANCE REPORT

Note: Cross out word or words which do not apply

This Trig. Station has been:-

1. Completely cleared to permit 360° vision to surrounding Trigs.
2. Cleared by lanes bearing..... from Trig. Mast
3. Trig. Mast & Vanes have been painted white & black respectively.
4. The Trig. was unpiled/not unpiled, dimensions now being:

Description of mark: TRM, LUG. should be explicit, e.g. Steel plug, Brass plug, Bolt, Concrete Pillar
 Height of mark: 0.025 m above rock-concrete m above G.L.
 Height of Top Vanes to Top Mark/Top-pillar-top: 3.58 m Diameter of Vanes (vertical) 0.50 m.
 Height of Cairn..... m. Diameter of Cairn..... m.
 Length of Mast 3.60 m. (approximate if not unpiled)

5. A..... set in conc/rock has been placed/fd m. bearing.....°M from Trig. Mast/pillar
6. A..... set in conc/soil has been placed/fd m. bearing.....°M from Trig. Mast/pillar
7. A..... set in conc/soil has been placed/fd m. bearing.....°M from Trig. Mast/pillar
8. A..... set in conc/rock has been placed/fd m. bearing.....°M from Trig. Mast/pillar

9. Connection..... to..... m. bearing.....°M
10. Connection..... to..... m. bearing.....°M
11. Connection..... to..... m. bearing.....°M
12. Connection..... to..... m. bearing.....°M

13. Diff. Ht. is..... m. above/below
14. Diff. Ht. is..... m. above/below
15. Diff. Ht. is..... m. above/below
16. Diff. Ht. is..... m. above/below

Prepared by: Stedden Checked: W

Date	Record of Station
23.1.74	These stations situated from C.P.M. main station, towards Coal and Canole Creek observations. This report first prepared 22-6-74.

STATION 681 TS BAIRNE

Current Occupant


Owners Name: KJ BING-GAL EXASE

NATIONAL PARK

Address: COMMODORE HEIGHTS ROAD

23-1-74

Access TAKE COMMODORE HEIGHTS ROAD TOWARDS COMMODORE HEIGHTS. AT ABOUT 600M SOUTH OF TS TOPHAM TAKE A WHEEL DRIVE ON THE RIGHT AND DRIVE FOR 2 KM TILL YOU REACH TS BAIRNE.

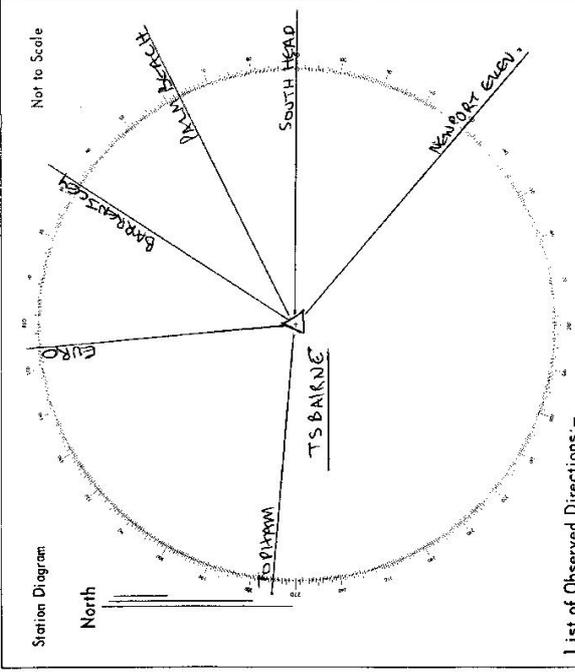


List of Observed Directions:-

Standpoint: TS BAIRNE		Standpoint: CONT'D.	
Station	Direction	Station	Direction
TS SOUTH HEAD	0° 00' 00"	TS EURO	265° 36' 42"
TS NEWPORT EVEN	39° 58' 32"	TS BARRENTOEY	304° 03' 47"
TS TORREMETTA	63° 37' 14"	TS PALM BEACH	333° 32' 14"
TS TERRY HILLS	112° 04' 31"		
TS TOPHAM	185° 16' 12"		

STATION **BAIRNE T.S.** 681

Owners Name: STATE GOVERNMENT
 NATIONAL PARKS & WILDLIFE SERVICE.
 (KURINGAI CHASE)
 Address:
 Current Occupant:
 Address:

Station Diagram

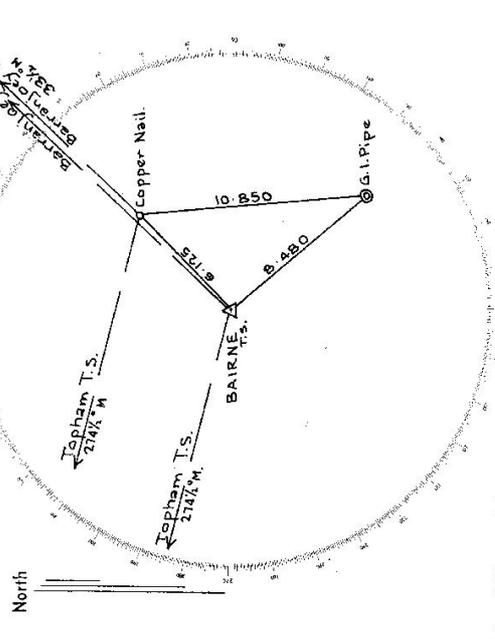


List of Observed Directions:-

Station	Direction	Station	Direction
Topham T.S.	0° 00' 00"	Topham T.S.	0° 00' 00"
Barranjoey T.S.	118° 53' 13"	Barranjoey T.S.	119° 01' 32"
Copper Nail	126° 25' 30"	G.I. Pipe	249° 22' 30"
G.I. Pipe	214° 59'	BAIRNE T.S.	300° 35'

- Mileage
- 0-0 Mona Vale Road & McCarrs Creek Road.
 - 1-3 Proceed along McCarrs Creek Road
 - 3-15 Continue along main road. It curve to right
 - 4-1 Turn off onto West Head Road
 - Take road to right at junction with Coal & Candie Creek Road.
 - 6-4 Salvation Creek
 - 8-1 Turn off onto Track 7
 - * Require key to open barrier post
 - Proceed along wall formed track (suitable for all 2 wheel drive vehicles in all weather condition)
 - 2-7 White Painted blazed tree
 - Align vehicle and walk approx. 300 to 400 metres in a south-westerly direction through madergate sub.

Note * Key obtainable from -
 Integration Surveys Division,
 Department of Lands
 or
 Trigonometrical Survey Division,
 Central Mapping Authority
 Park Ranger, Kuringai Chase
 at West Head (Commodore Heights).

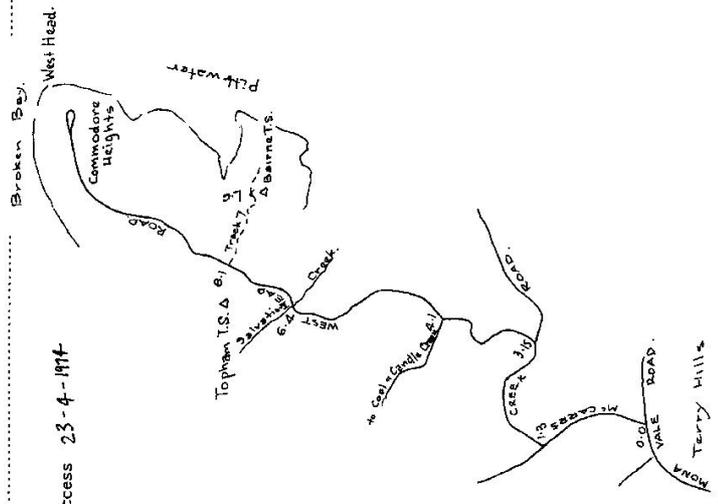

Access 23-4-1974