

LAND INFORMATION CENTRE

GEODETTIC SURVEY OF A.S.M.

GEODETTIC STATION RECONNAISSANCE and MAINTENANCE REPORT

Description:

1. Cleared by lanes bearing.....
 Note: *Cross out word or words which do not apply*
 from Trig. Mast

2. Mast & Vanes have been painted white & black respectively.

3. The station/pillar was unplied/not unplied/constructed on..... 19....., dimensions now being:

Description of mark..... should be explicit, e.g., S/Steel Pillar Plate, Steel plug, Brass plug, Bolt, G.I. Pipe

Height of mark.....m. ^{above} rock/concrete; Mark is.....m. ^{above} _{below} G.L.

Height of Top Vanes to Top Mark/Pillar platem. Diameter of Vanes (vertical).....m.

Height of Cairn.....m. Diameter of Cairn.....m. Name Plate found/not found/placed.

Length of Mastm. (approximate if not unplied)

4. A.....set in conc/rock has been placed/found, bearing.....°M from Mast/Plug/Pillar

5. A.....set in conc/rock has been placed/found, bearing.....°M from Mast/Plug/Pillar

6. A.....set in conc/rock has been placed/found, bearing.....°M from Mast/Plug/Pillar

7. A.....set in conc/rock has been placed/found, bearing.....°M from Mast/Plug/Pillar

8. Action required:.....

STANDPOINT:

STANDPOINT:

Mark	Direction	Horiz. Distance	Height Difference	Mark	Direction	Horiz. Distance	Height Difference
			above standpt. below				above standpt. below
			above standpt. below				above standpt. below
Prepared by: *J. J. J.* 10/4/91

Checked: *J. J. J.* 2/5/91

Noted on U.T.M. Card

STATION: *TUON* No.: *TS 6825*

MAP SHEET SCALE 1:250-000 *EMONGONIA*

INSPECTED BY: *G FORD* DATE: *MARCH 1991*

AUTHORITY: *L.I.C* FIELD BOOK: *---*

Station Diagram

Checked

TUON DAPPLE STATION
ENNGONIA 1:100.00

ACCESS

- 0.00 ENNGONIA HOTEL HEAD NORTH
- 20.73 TURN RIGHT INTO LANE JUST AFTER GRID MAILBOX 'BIRIMBA'
- 25.33 IRON GATE
- 28.05 TAKE RIGHT FORK
- 31.63 IRON GATE
- 38.52 IRON GATE
- 40.63 IRON GATE
- 41.61 TURN LEFT BEFORE MAIN HOUSE COTTAGE ON R.H.S.
- 43.55 GATE FOLLOW TRACK STRAIGHT AHEAD.
- 43.93 STRAIGHT AHEAD
- 48.77 CROSS BORE DRAIN (CULVERT)
- 49.81 BORE FOLLOW TRACK
- 51.56 TUON C.S.

1 HOUR FROM ENNGONIA.

All 3 R.M Marks found (Deep chain marks) about 0.2 out of ground. They can move side ways (as do all other deep chain marks).
Centre Mark = 10722 is set in one and stable corner box
one Mark held in place by roots.

No Obstructions for G. P. S.


Lead Owner: Mr. Bill Rudge (UHF channel 36)
"Tuon"

PH. 747591 (063) next Sign of area code.

STATION TUON TS 6825

Owner's Name:
Current Occupant:
Address:
Phone:
Phone: March 1991

ACCESS

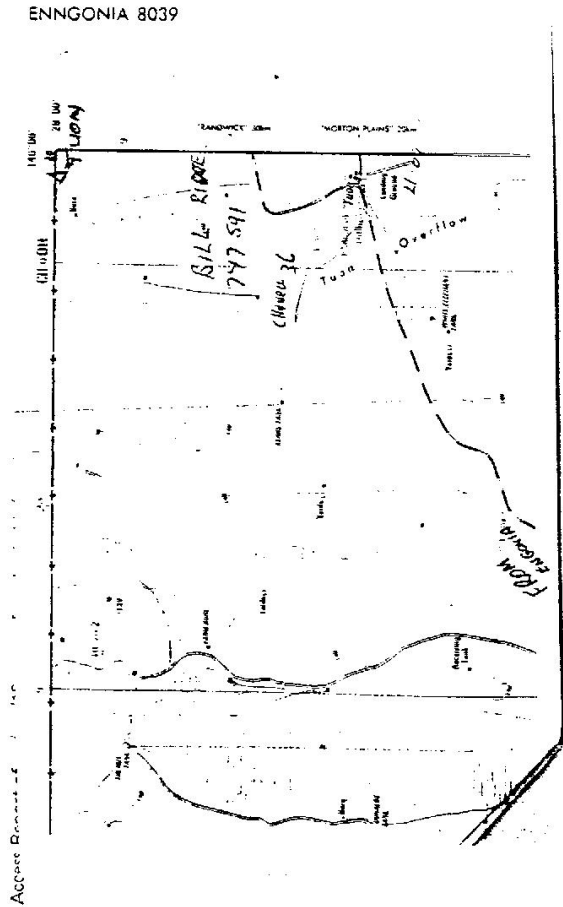

Date

Record of Station