

CENTRAL MAPPING AUTHORITY

Trigonometrical Survey of N.S.W.

Department of Lands

RECONNAISSANCE and MAINTENANCE REPORT

This Trig. Station has been:-

Note: Cross out word or words which do not apply

1. Completely cleared to permit 360° vision to surrounding Trigs.
2. Cleared by lanes bearing..... from Trig. Mast
3. Trig. Mast & Vanes have been painted white & black respectively.
4. The Trig. was unpiled/not unpiled, dimensions now being: ~~.....~~ should be explicit, e.g. Steel plug, Brass plug, Bolt, G.I. Pipe

Description of mark..... m above rock/concrete..... m below G.L.

Height of Top Vanes to Top Mark..... m. Diameter of Vanes (vertical)..... m.

Height of Cairn..... m. Diameter of Cairn..... m.

Length of Mast..... m. (approximate if not unpiled)

5. A..... set in conc/rock has been placed..... m. bearing.....°M from Trig. Mast

6. A..... set in conc/soil has been placed..... m. bearing.....°M from Trig. Mast

7. A..... set in conc/soil has been placed..... m. bearing.....°M from Trig. Mast

8. A..... set in conc/rock has been placed..... m. bearing.....°M from Trig. Mast

9. Connection..... to..... m. bearing.....°M

10. Connection..... to..... m. bearing.....°M

11. Connection..... to..... m. bearing.....°M

12. Connection..... to..... m. bearing.....°M

13. Diff. Ht. is..... m. above/below

14. Diff. Ht. is..... m. above/below

15. Diff. Ht. is..... m. above/below

16. Diff. Ht. is..... m. above/below

Prepared by:

Checked:

Noted on U.T.M. Card

Checked

STATION COWS HEAD TS 6828

Co: Home Ph: Buckaringach

Map Sheet: Halbrook No: 8326-N

Inspected by: G. Hanna Date: 23/9/76

Authority: Field Book:

Betoon Diagram Not to Scale

Date


Record of Station

STATION COWS HEAD TS-6828

Owners Name.....
 Current Occupant.....
 Address.....
 Address.....

Access 23-9-1976

Survey mark RASC H166 found
 360° Vision with removal of one tree
 For access see Henty 1:25,000 8326-N-N

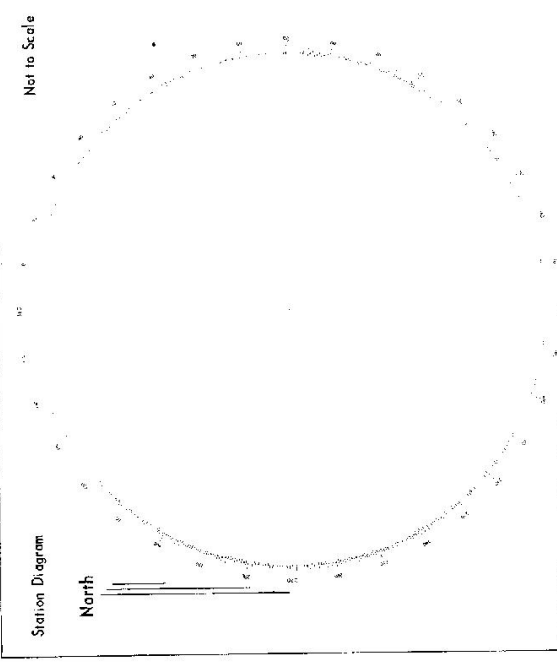

List of Observed Directions:-

Standpoint:	
Station	Direction
Standpoint:	
Station	Direction

