

STATION BATLOW T.S. 785 6829

Current Occupant:


Address:

Owners Name:

Address:

4th June 1977

Access FROM BATLOW POST OFFICE DRIVE 3.3 km VIA BATLOW - TUMUT ROAD AT 2.3 km ENTER PROPERTY "SPRINGVALE" VIA GATE ON LEFT. THENCE PROCEED TO TOP OF HILL (CONVENTIONAL ACCESS). FOLLOW WHEEL DRIVE IN WET WEATHER

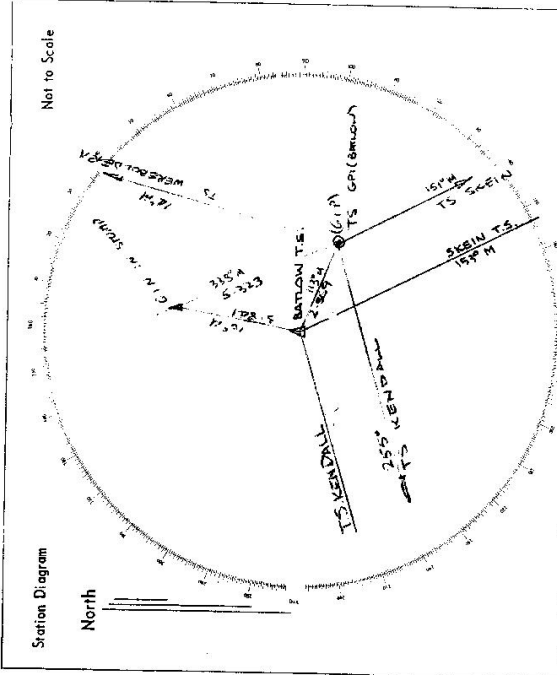


List of Observed Directions:-

Standpoint: TRC PLUG		Standpoint: TS GPI	
Station	Direction	Station	Direction
TS KENDALL	0° 00' 00"	TS SKEIN	0° 00' 00"
TS IN STUMP	115° 53' 04.5"	TS KENDALL	103° 24' 57"
TS (GPI)	215° 59' 04.5"	TS BATLOW (PLUG)	143° 28' 30"
		TS O.M.I. (G.I.N. STATION)	137° 52' 48.5"
Station	Direction	Station	Direction

CENTRAL MAPPING AUTHORITY
 GEODETIC SURVEY OF M.S.W.
 GEODETIC STATION RECONNAISSANCE and MAINTENANCE REPORT

STATION: *BATSOOR* No.: *5829 FEB*
 MAP SHEET SCALE 1:250 000
 INSPECTED BY: *R. LAMBER* DATE: *18-11-81*
 AUTHORITY: *C.M.A.* FIELD BOOK: *C170*

Description:
 1. Cleared by lanes bearing.....
 Note: Cross out word or words which do not apply
 2. Mast & Vanes have been painted white & black respectively.
 3. The station/pillar was unpiled/not unpiled/constructed on.....
 Note: dimensions now being:
 Description of mark.....
 Height of mark.....m. above rock/concrete; Mark is.....m. above/below G.L.
 Height of Top Vanes to Top Mark/Pillar plate.....m. Diameter of Vanes (vertical).....m.
 Height of Cairn.....m. Diameter of Cairn.....m. Name Plate found/not found/placed.
 Length of Mast.....m. (approximately not unpiled)
 4. A.....set in conc/rock has been placed/found, bearing.....°M from Mast/Plug/Pillar
 5. A.....set in conc/rock has been placed/found, bearing.....°M from Mast/Plug/Pillar
 6. A.....set in conc/rock has been placed/found, bearing.....°M from Mast/Plug/Pillar
 7. A.....set in conc/rock has been placed/found, bearing.....°M from Mast/Plug/Pillar
 8. Action required: *CONC. PILLAR TO BE CONSTRUCTED, LANES TO BE CLEARED*

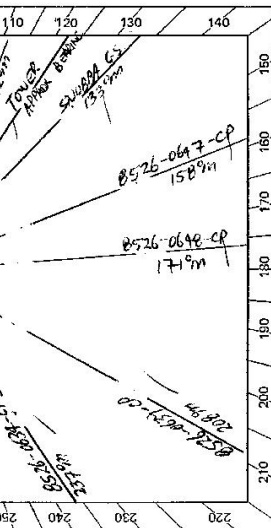

STANDPOINT:

Mark	Direction	Horiz. Distance	Height Difference	Mark	Direction	Horiz. Distance	Height Difference
			above standpt.				above standpt.
			below				below
			above standpt.				above standpt.
			below				below
Prepared by: *R. LAMBER 18-11-81* Checked: *J. Jamming 25 July 81* Noted on U.T.M. Card
 S: 2733-1

STATION
BATZOW CS / 6829

Owner's Name: GREG MURAT & ANNA WILSON
 Address: PO Box 35, Batzow
 Phone: [Redacted]

Current Occupant: [Redacted]
 Address: [Redacted]
 Phone: [Redacted]

ACCESS

Access Report of 18/11/1981 via found suitable

PERMITS

0.00 AT BATZOW RD. HEAD NORTH ALONG REEVEY ST (BECOMES TUNNIT RD) #
 GO TOWARDS TUNNIT.
 3.37 TURN LEFT INTO "SPRINGWATER", OWNER OF CS PRESENT LIKE WERE - MAKE-
 QUARTERS CALL.
 3.44 VEER RIGHT & GO THROUGH IRON GATE WEST TO LEARNAN ROAD. FOLLOW
 TRACK AROUND 2 H.S. OF TRACTOR SHED.
 3.52 GO THROUGH SAVER NEW GATE ON L.H.S. GO STRAIGHT AROUND ALONG
 FENCELINE PASSING BARR ON L.H.S.
 3.64 AT CORNER POST TURN RIGHT & MAKE WAY NORTH.
 3.72 BYPASS CONCRETE TRAP ON L.H.S.
 3.87 TURN LEFT & GO THROUGH IRON GATE
 3.95 FOLLOW TRACK AROUND TO LEFT
 4.59 GO THROUGH IRON GATE
 4.62 TURN RIGHT OFF TRACK - MAKE WAY UP TOWARDS TOP OF HULL -
 OLD FENCELINE RISE AT ENDED APPROX 50m FROM CS. VEER
 LEFT TO GO OVER THIS FENCELINE.
 4.85 (APPROX 1m) AT BATZOW CS

* CLEARING REQUIREMENTS *

Record of Station
 CLEAR TO APPROX 150m → 50m LEAVE BIG TREES
 WITHIN 50m → 70m IF POSSIBLE CLEAR TO SEE CLAMP CS
 & TRAILING CS. TRY TO CLEAR TO SWAMP CS - BUT NO
 BIG TREES TO BE CUT. CUT DOWN TREES NEAR PANE - CUT LARGE
 TREES INTO STRIPPERS.

St. 2735 - 2 D. West, Government Printer

Beacon Diagram	Not to Scale
FED CONTACT	
(1) GREG MURAT (WORKING HOURS) TUNNIT AFB STAKES PO #77311	
(2) ANNA WILSON - FORESTRY COMMISSION WORKER PO: BATZOW 224 (MORNING HOURS)	
* CONTACT GREG MURAT DURING CLEARANCE	

This section to be completed by officer constructing pillar.
 Original station mark found/not found.
 Description of mark:
 Original beacon found/not found.
 Description of beacon:
 Height Top of Vanes to Top Markm.
 Height of markm. above G.L. below
 Diameter of Vanesm. Height of Cairnm.
 Original Beacon has/has not been destroyed by ma.

CENTRAL MAPPING AUTHORITY

GEODETIC SURVEY OF N.S.W.

GEODETIC STATION RECONNAISSANCE and MAINTENANCE REPORT

Description:

1. Cleared by lanes bearing 155 m to 34 m, 392 m to 57 m, 10 m to 118 m from Trig. Mast

2. Mast & Vanes have been painted white & black respectively.

3. The ~~station~~/pillar was ~~replaced/reconstructed~~/constructed on 27th Jan 1982, dimensions now being:

Description of mark 3/4 brass base should be explicit, e.g., S/Steel Pillar Plate, Steel plug, Brass plug, Bolt, G.I. Pipe

Height of mark 1.375 m. above rock/concrete; Mark is 1.495 m. above G.L.

Height of Top Vanes to Top Mast/Pillar plate 1.46 m. Diameter of Vanes (vertical) 0.755 m.

Height of Cairn.....m. Diameter of Cairn.....m. Name Plate found/not found/placed.

Length of Mast.....m. (approximate if not unplied)

4. A. G.I. Pipe set in conc/rock has been placed/found, bearing 97 ° M from Mast/Pillar/Pillar

5. A. set in conc/rock has been placed/found, bearing..... ° M from Mast/Plug/Pillar

6. A. set in conc/rock has been placed/found, bearing..... ° M from Mast/Plug/Pillar

7. A. set in conc/rock has been placed/found, bearing..... ° M from Mast/Plug/Pillar

8. Action required.....

STANDPOINT: Cave Obs Pillar

STANDPOINT: Brass Trig Ruc


STATION: BAYDON (ESD) No: 6329

MAP SHEET SCALE 1:250 000 NAASA NAASA

INSPECTED BY: P.Bors DATE: 3-2-82

AUTHORITY: C.M.A FIELD BOOK: 01925

Station Diagram

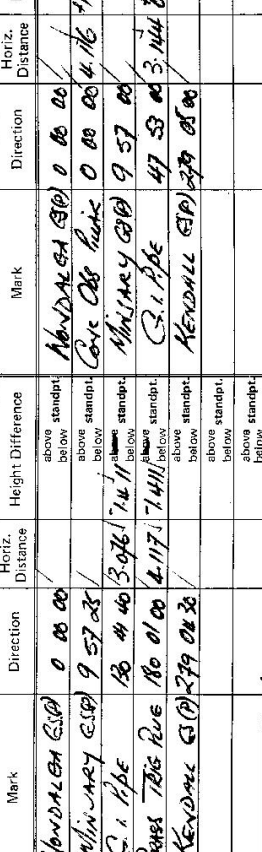

Prepared by: P.Bors 9-2-82

Checked: P.Bors Noted on U.T.M. Card

SR 2733-1

ST 2733 - 2 D. West, Government Printer

STATION **BATZON (S.P.)** * **6829**

Owner's Name: **Mr G. Mott & R. Nilson**
 Address: **18 Box 33 Batzon 824**
 Phone: **824**

Current Occupant:
 Address:
 Phone:

ACCESS

Access Report of 13/11/19. **RAKES** found suitable/unsuitable.

REFERENCE
 KM 0.00 **KEY OFFICE BATZON HEAD TOWARDS TURNUT.**
 3.34 **TURN LEFT INTO "SPRINGHOLE"**
 3.43 **GO THROUGH 1ST GATE TO THE RIGHT OF SAKA**
 3.49 **TURN LEFT THROUGH WHITE IRON GATE**
 3.62 **TURN RIGHT AROUND FENCE CROSSER**
 3.82 **THROUGH IRON GATE & FOLLOW TRACK UP RIDGE**
 4.51 **1ST GATE**
 4.51 **TURN RIGHT INTO BUSH TRACK**
 4.85 **CROSS OVER FENCE**
 4.92 **BATZON (S.P.)**

Beacon Diagram

This section to be completed by officer constructing pillar.

Original station mark found/~~not found~~.

Description of mark: **Bones TIC RUG**

Original beacon found/~~not found~~.

Description of beacon: **Convex Rec's Disc**

Height Top of Vanes to Top Mark: **3.650** m.
 above G.L. below

Height of mark: **0.105** m. above rock/stone below

Diameter of Vanes: **1.015** m. Height of Cairn: m.

Original Beacon has/~~has not~~ been destroyed by me.

Date

Record of Station