

TS-6880

STATION: ECHHARENA G3 No: 1995

MAP SHEET SCALE 1:250 000 Subb.

INSPECTED BY: P. B. T. S. DATE: 26th May 1981

AUTHORITY: C.M.A FIELD BOOK: 1408

Station Diagram

CENTRAL MAPPING AUTHORITY
 GEODETIC SURVEY OF N.S.W.
 GEODETIC STATION RECONNAISSANCE and MAINTENANCE REPORT

Description:
 Note: Cross out word or words which do not apply

1. Cleared by lanes bearing LINE to AUCKERNA G3 at 1981 from Trig. Mast

2. Mast & Vanes have been painted white & black respectively. ✓

3. The station ~~marker~~ was ~~unpiled/not unpiled~~ on 26th May 1981, dimensions now being:
 Description of mark..... should be explicit, e.g., S/Steel Pillar Plate, Steel plug, Brass plug, Bolt, G.I. Pipe
 Height of mark.....m. ^{above} rock/concrete; Mark is.....m. ^{above} G.L.

Height of Top Vanes to Top Mark/Pillar plate.....m. Diameter of Vanes (vertical) 0.85

Height of Cairn.....m. Diameter of Cairn.....m. Name Plate ~~found~~/not found/placed.

Length of Mast.....m. (approximate if not unpiled)

4. A.....set in conc./rock has been placed/found, bearing.....° M from Mast/Plug/Pillar

5. A.....set in conc./rock has been placed/found, bearing.....° M from Mast/Plug/Pillar

6. A.....set in conc./rock has been placed/found, bearing.....° M from Mast/Plug/Pillar

7. A.....set in conc./rock has been placed/found, bearing.....° M from Mast/Plug/Pillar

8. Action required: Place concrete base & clear line MISSING Given 28/81

STANDPOINT:

Mark	Direction	Horiz. Distance	Height Difference	Mark	Direction	Horiz. Distance	Height Difference
			above standpt.				above standpt.
			below				below
			above standpt.				above standpt.
			below				below
Prepared by: P.B.T.S. 29th May 1981 Checked: J. Williams 18/9/81

Noted on U.T.M. Card


STATION **EICHAREENA G. TS 6880**

Owner's Name: **Mr. Richard Clayton**
 Address: **EICHAREENA**
 Phone: **06 3 6510 613**
 Current Occupant:
 Address:
 Phone:

ACCESS

Access Report of 15/11/1981 was found suitable/unsuitable.
FEATURE
 0.00 TO EICHAREENA HEAD TOWARDS ORANGE
 0.45 TURN LEFT SIGN "STREET TOWN" & "BURENDONG DAM"
 0.60 CROSS RAILWAY LINE "RUSSIAN TIP"
 0.65 TURN RIGHT SIGN "RUSSIAN TIP"
 1.70 PASS TIP ON LEFT
 1.80 HIGH GATE
 2.00 HIGH GATE THEN KEEP RIGHT & ALONG RIDGE
 3.55 GEODETIC STATION EICHAREENA

Sr. 2733-2.D. West Government Printer
 Beacon Diagram

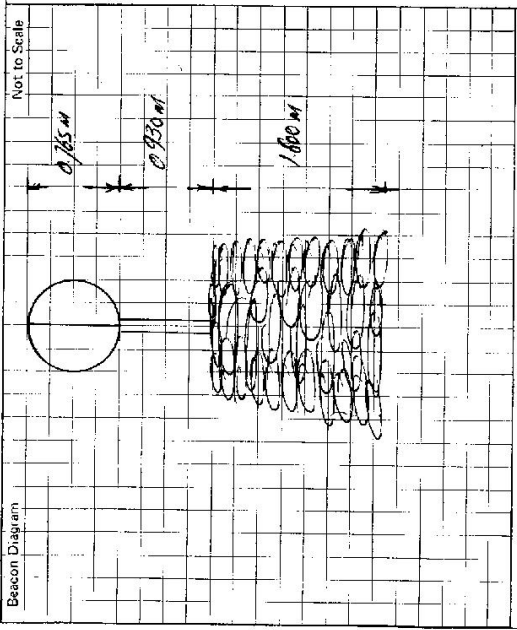

This section to be completed by officer constructing pillar.

Original station mark found/not found.

Description of mark:

Original beacon found/not found.

Description of beacon:

Height Top of Vanees to Top Mark:m.

Height of mark:m. above rock/cont. below G.L.

Diameter of Vanees:m. Height of Cairn:m.

Original Beacon has/has not been destroyed by me.

Date	Record of Station

<p>51-2733--2 D. West, Government Printer</p> <p>Beacon Diagram</p> <p style="text-align: right;">Not to Scale</p> <p style="text-align: center;">MUST NOT UPRIGAT VANES NOT COMPLETE & DAMAGED CAIRN INTACT</p>	<p style="text-align: center;">STATION EUCHAREENA TS 6880</p> <p>Access Owner's Name: MR. R. CLAYTON Address: N MACDONALD ST CEMETERY ROAD, EUCHAREENA Phone: (0863) Euchareena 7551 641043</p> <p>Owner: TR 38369 Current Occupant: TR 38369 Address: Phone:</p> <p>Access Report of 15/7/1988 was found suitable/unsuitable.</p> <table border="1" style="width:100%; border-collapse: collapse;"> <thead> <tr> <th style="text-align: left;">Km</th> <th style="text-align: left;">Feature</th> </tr> </thead> <tbody> <tr> <td>0.0</td> <td>P.O. EUCHAREENA - HEAD EAST TOWARDS MAIN RAILWAY</td> </tr> <tr> <td>0.42</td> <td>TURN LEFT - SIGN 'STUART TOWN'</td> </tr> <tr> <td>0.56</td> <td>RAILWAY CROSSING</td> </tr> <tr> <td>0.59</td> <td>TURN RIGHT - FOLLOW GRAVEL TRACK</td> </tr> <tr> <td>1.60</td> <td>VEER RIGHT AROUND ENTRANCE TO GARAGE DUMP KEEP DUMP ON LEFT</td> </tr> <tr> <td>1.68</td> <td>IRON GATE - TURN LEFT AFTER GATE - FOLLOW FENCE</td> </tr> <tr> <td>1.91</td> <td>IRON GATE - VEER RIGHT AND UP RIDGE</td> </tr> <tr> <td>2.44</td> <td>'EUCHAREENA' TRG.</td> </tr> </tbody> </table> <p>NOTE: GATE ON ACCESS MAY BE LOCKED - KEY OBTAINABLE FROM OWNER. SB MAY BE LOCATED UNDER A PIECE OF TIN AT BASE OF CORNER POST 15 metres TO RIGHT (WEST) OF GATE.</p>	Km	Feature	0.0	P.O. EUCHAREENA - HEAD EAST TOWARDS MAIN RAILWAY	0.42	TURN LEFT - SIGN 'STUART TOWN'	0.56	RAILWAY CROSSING	0.59	TURN RIGHT - FOLLOW GRAVEL TRACK	1.60	VEER RIGHT AROUND ENTRANCE TO GARAGE DUMP KEEP DUMP ON LEFT	1.68	IRON GATE - TURN LEFT AFTER GATE - FOLLOW FENCE	1.91	IRON GATE - VEER RIGHT AND UP RIDGE	2.44	'EUCHAREENA' TRG.
Km	Feature																		
0.0	P.O. EUCHAREENA - HEAD EAST TOWARDS MAIN RAILWAY																		
0.42	TURN LEFT - SIGN 'STUART TOWN'																		
0.56	RAILWAY CROSSING																		
0.59	TURN RIGHT - FOLLOW GRAVEL TRACK																		
1.60	VEER RIGHT AROUND ENTRANCE TO GARAGE DUMP KEEP DUMP ON LEFT																		
1.68	IRON GATE - TURN LEFT AFTER GATE - FOLLOW FENCE																		
1.91	IRON GATE - VEER RIGHT AND UP RIDGE																		
2.44	'EUCHAREENA' TRG.																		

This section to be completed by officer constructing pillar.

Original station mark found/not found.

Description of mark:

Original beacon found/not found.

Description of beacon:

Height Top of Vanes to Top Mark m.

Height of mark m. above rock/conc. m. below G.L.

Diameter of Vanes m. Height of Cairn m.

Original Beacon has/has not been destroyed by me.

Date	Record of Station

GEODETTIC SURVEY OF NS&K

CENTRAL MAPPING AUTHORITY


GEODETTIC STATION RECONNAISSANCE and MAINTENANCE REPORT

STATION: *MOCKERNA (50)* No: *6880*

MAP SHEET SCALE 1:250 000

INSPECTED BY: *G. Ford* DATE: *6-5-82*

AUTHORITY: *CMA* FIELD BOOK: *01930*

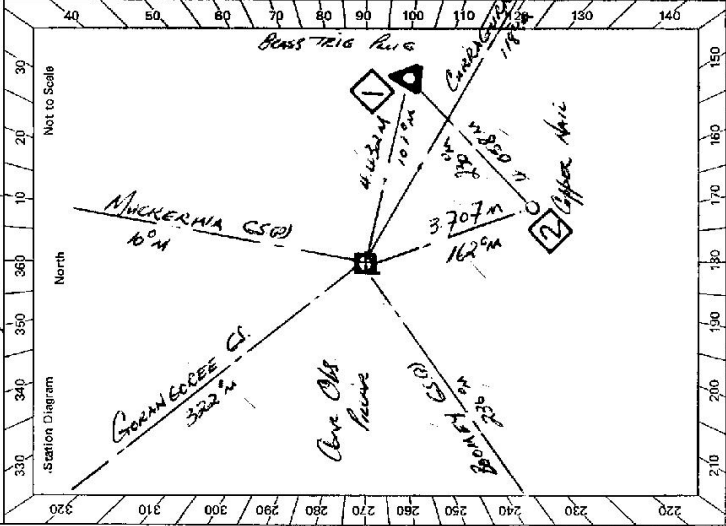

Description: *365m* Note: *Cross out word or words which do not apply*

1. Cleared by lanes bearing *365m* from Trig. Mast
2. Mast & Vanes have been painted white & black respectively. ✓
3. The ~~station~~/pillar was ~~unaffected~~/constructed on *SK MAY* 19*82*, dimensions now being: Description of mark: *36 Pines* should be explicit, e.g., S/Steel Pillar Plate, Steel plug, Brass plug, Bolt, G.I. Pipe Height of mark: *1.365* above ~~below~~ *CONC*/concrete; Mark is *1.535* above ~~below~~ G.I. Diameter of Vanes (vertical) *0.750* m. Height of Top Vanes to Top ~~Mark~~/Pillar plate *1.445* m. Name Plate found/not found/placed. Height of Cairn *0* m. Diameter of Cairn *0* m. Length of Mast *0* m. (approximate if not unplied)
4. A *BRASS TRIG RIG* set in ~~conc/rock~~ has been ~~placed~~/found, bearing *61*°M from ~~Mast/Plug~~/Pillar
5. A *COPPER NAIL* set in ~~conc/rock~~ has been placed/~~found~~, bearing *162*°M from ~~Mast/Plug~~/Pillar
6. A *CONCRETE PI* set in ~~conc/rock~~ has been placed/~~found~~, bearing *322*°M from Mast/~~Plug~~/Pillar
7. A *CONC OLD PILE* set in ~~conc/rock~~ has been placed/~~found~~, bearing *162*°M from Mast/~~Plug~~/Pillar
8. Action required: *CONC OLD PILE* STANDPOINT: *BRASS TRIG RIG*


Mark	Direction	Horiz. Distance	Height Difference	Mark	Direction	Horiz. Distance	Height Difference
<i>BOOMEY (50)</i>	<i>0 00 00</i>		above standpt	<i>BOOMEY (50)</i>	<i>0 00 00</i>		above standpt
<i>GORAN GORCEE (89 06 55)</i>	<i>89 06 55</i>		above standpt	<i>CONC OLD PILE</i>	<i>162 00 00</i>	<i>4.42</i>	<i>1.498</i> above standpt
<i>MUCKERNA (50) (87 32 55)</i>	<i>87 32 55</i>		above standpt	<i>CONCRETE PI</i>	<i>322 00 00</i>	<i>05 20</i>	above standpt
<i>BRASS TRIG RIG (230 58 05 4.42)</i>	<i>230 58 05 4.42</i>		above standpt	<i>MUCKERNA (50)</i>	<i>162 00 00</i>	<i>30 50</i>	above standpt
<i>CONCRETE PI (270 03 25 3.707)</i>	<i>270 03 25 3.707</i>		above standpt	<i>CONCRETE PI</i>	<i>322 00 00</i>	<i>53 00</i>	above standpt
<i>COPPER NAIL (270 03 25 3.707)</i>	<i>270 03 25 3.707</i>		above standpt	<i>COPPER NAIL</i>	<i>162 00 00</i>	<i>40 00</i>	<i>6.02</i> above standpt

Prepared by: *PHRS 16-5-82* Checked: *PHRS 11/5/82* Noted on U.T.M. Card

21: 2733 - 2 D. West, Government Printer

STATION

EUCHAREENA CSQ IS 6880

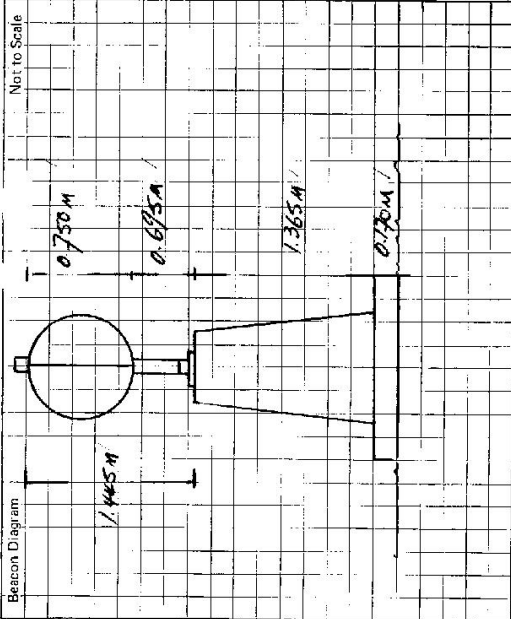

Owner's Name: TRIG RESEARCH
 Address: 38 E369
 Phone:

Current Occupant: MR R CLAYTON
 Address: MAAROM BAH - CEMETERY ROAD, EUCHAREENA
 Phone: (083) EUCHAREENA 7777

ACCESS

Access Report of 6/5/1988 was found suitable/unsuitable.

K.M. FEATURE
 0.00 GET OFFICE EUCHAREENA - HEAD EAST TOWARDS MAIN RAILWAY
 0.42 TURN LEFT - SIGN "STRAIGHT TOWN"
 0.56 RAILWAY CROSSING
 0.59 TURN RIGHT - FOLLOW CHANNEL TRACK
 1.60 KEEP LEFT AROUND ENTRANCE TO EMERALD DUMP
 1.68 KEEP DUMP ON LEFT
 1.91 TURN LEFT AFTER GATE - FOLLOW FENCE
 2.44 NEW GATE - KEEP RIGHT UP RIDGE EUCHAREENA (SCD)

This section to be completed by officer constructing pillar.

Original station mark found/~~not found~~.

Description of mark: BRASS TRIG PEGS

Original beacon found/~~not found~~.

Description of beacon: CAIRN PILE OF DISC

Height Top of Vanes to Top Mark: 1.365 m.

Height of mark: 0.695 m. above rock/~~base~~ below G.L.

Diameter of Vanes: 0.765 m. Height of Cairn: 1.000 m.

Original Beacon has/~~has not~~ been destroyed by me.

SEE OWNER FOR KEY TO LOCKED GATE
 CMTA LOCK 16/9/88

Date	Record of Station