

CENTRAL MAPPING AUTHORITY

Department of Lands

Trigonometrical Survey of N.S.W.

RECONNAISSANCE and MAINTENANCE REPORT

This Trig. Station has been:-

Note: Cross out word or words which do not apply

1. Completely cleared to permit 360° vision to surrounding Trig.

2. Cleared by lanes bearing..... from Trig. Mast

3. Trig. Mast & Vanes have been painted white & black respectively.

4. The Trig. was unpainted, not unpainted, dimensions now being: (.....) should be explicit, e.g. Steel plug, Brass plug, Bolt, Gal. Pipe

Description of mark..... m above below rock/concrete..... m above below G.L.

Height of Top Vanes to Top Mark..... m. Diameter of Vanes (vertical)..... m.

Height of Cairn..... m. Diameter of Cairn..... m.

Length of Mast..... m. (approximate if not unpainted)

5. A..... set in conc/rock has been placed..... m. bearing..... °M from Trig. Mast

6. A..... set in conc/soil has been placed..... m. bearing..... °M from Trig. Mast

7. A..... set in conc/soil has been placed..... m. bearing..... °M from Trig. Mast

8. A..... set in conc/rock has been placed..... m. bearing..... °M from Trig. Mast

9. Connection..... to..... m. bearing..... °M 360° View if isolated Trees

10. Connection..... to..... m. bearing..... °M cleared. Within historic site area.

11. Connection..... to..... m. bearing..... °M Need NPWS permission before

12. Connection..... to..... m. bearing..... °M even starting chainsaw.

13. Diff. Ht. is..... m. above below Ideal for pillar. Vehicle access

14. Diff. Ht. is..... m. above below on good road right to Trig.

15. Diff. Ht. is..... m. above below

16. Diff. Ht. is..... m. above below

Prepared by: I.W. Robins

Checked: Noted on U.T.M. Card

STATION HILL END TS. 6881

Co: Wellington | Ph: Tembarooa

Map Sheet: Hill End

Inspected by: I.W. Robins

Authority: CMA

Beacon Diagram

No: 8731-N

Date: 4/12/77

Field Book: Hill End

Not to Scale



cairn only.

Date

Record of Station

Checked

TS 6881

GEODETTIC SURVEY OF M.S.W.

CENTRAL MAPPING AUTHORITY

GEODETTIC STATION RECONNAISSANCE and MAINTENANCE REPORT

STATION: HILL END

No.: 2485

MAP SHEET
SCALE 1:250 000 BATHURST

INSPECTED BY: R. ELLIS DATE: 02-07-81

AUTHORITY: C.M.A. FIELD BOOK: 01917

Description:

Note: Cross out word or words which do not apply

- Cleared by lanes bearing... $48^{\circ}M \sim 78^{\circ}M$, $88^{\circ}M \sim 105^{\circ}M$, $117^{\circ}M \sim 140^{\circ}M$, $155^{\circ} \sim 163^{\circ}$ from Trig. Must $205^{\circ}M \sim 225^{\circ}M$; $300^{\circ}M \sim 310^{\circ}M$.
- Mast & Vane have been painted white & black respectively.
- The station/altar was ~~erected~~/not unplied/constructed on 19 dimensions now being:
CAIRN ONLY FOUND
Description of mark should be explicit, e.g., S/Steel Pillar Plate, Steel plug, Brass plug, Bolt, G.I. Pipe
Height of mark... N/A m. above below rock/concrete; Mark is... N/A m. above below G.L.
Height of Top Vane to Top Mark/Pillar plate... N/A m. Diameter of Vane (vertical)... N/A m.
Height of Cairn... N/A m. Diameter of Cairn... N/A m. Name Plate found/not found/placed.
Length of Mast m. (approximate if not unplied)
- A set in conc/rock has been placed/found, bearing... $^{\circ}M$ from Mast/Plug/Pillar
- A set in conc/rock has been placed/found, bearing... $^{\circ}M$ from Mast/Plug/Pillar
- A set in conc/rock has been placed/found, bearing... $^{\circ}M$ from Mast/Plug/Pillar
- A set in conc/rock has been placed/found, bearing... $^{\circ}M$ from Mast/Plug/Pillar
- Action required... CONCRETE PILLAR CONSTRUCTION AND CLEARING OF SCATTERED TIMBER

STANDPOINT:

STANDPOINT:

Mark	Direction	Horiz. Distance	Height Difference	Mark	Direction	Horiz. Distance	Height Difference
			above standpt				above standpt
			below standpt				below standpt
			above standpt				above standpt
			below standpt				below standpt
Prepared by:

Piller: 06-07-81

Noted on U.T.M. Card

Checked

ST 2733-1

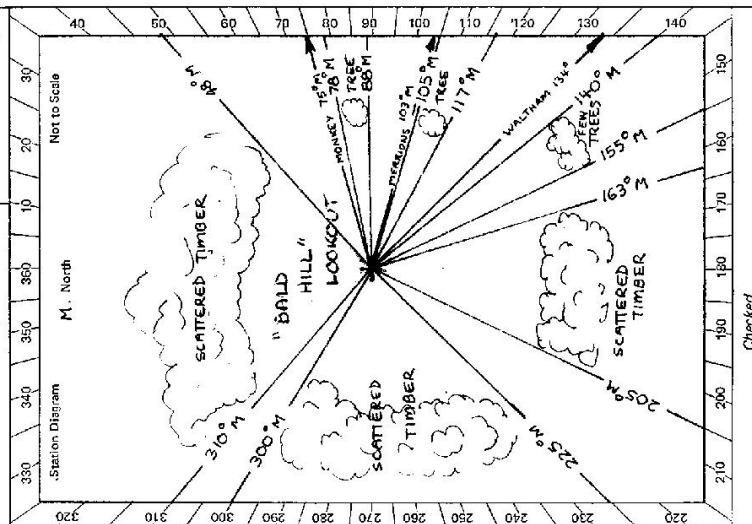

STATION

HILL END TS 6881

Owner's Name: TR 344-04

Address: 93 Ha Reserve stn

current @ 25/1/82

Phone:

Current Occupant:

Address:

Phone:

ACCESS

Access Report of 2/7/1981 was found unsuitable.

Feature

Km

HILL END P.O. - HEAD N.E. ALONG ROAD PAST POLICE STATION

0.0 "ROYAL HOTEL" AND GENERAL STORE

0.5 TURN LEFT

0.8 TURN LEFT - SIGN "BALD HILL LOOKOUT"

1.9 PASS TRACK ON RIGHT

2.9 "HILL END" TRIG

3.9

Date	Record of Station

Beacon Diagram

Not to Scale

CAIRN ONLY FOUND

EAST OF

SUGGESTED LOCATION FOR PILLAR IS ROCK

THINKING TO WEST OF PAVEN LIMITED PLANTING

FROM THIS LOCATION

PHONE CALL TO MPWS BRANCHES 26-01-82

REVEALED THEY AGREE THAT CONSTRUCTION OF A

PILLAR IS NECESSARY ALONG WITH CLEARING.

This section to be completed by officer constructing pillar.

Original station mark found/not found.

Description of mark:

Original beacon found/not found.

Description of beacon:

Height Top of Vane to Top Mark.....m.

Height of mark.....m. above rock/cont.....m. below G.L.

Diameter of Vane.....m. Height of Cairn.....m.

Original Beacon has/not been destroyed by me.

STATION: *4112 ENA (ESP)* / No.: *6881*

Description:

- MAP SHEET
SCALE 1:250,000
Barman

3. Action required:.....

200m
150m


Bak Gid

LONG OBS HOUSE
(PENCE)

200m
150m

Checked: 10/5/82 Noted on U.T.M. Card

En 2733 - 2 D. West, Government Printer

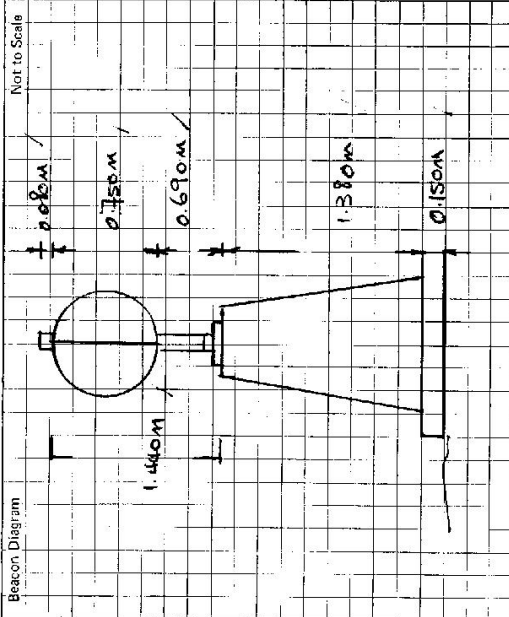

This section to be completed by officer constructing pillar.

Original station mark found/~~not found~~.

Description of mark: BRICK PILE

Original beacon ~~found~~/not found.

Description of beacon: PAVED

Height Top of Varies to Top Mark:m.

Height of mark: PAVED above rock/level below G.L.

Diameter of Variesm. Height of Cairnm.

Original Beacon has/not been destroyed by sea.

STATION Hill End (SEA) TS 6881

Owner's Name: TRIC Reserve

Address: 3440 L

Phone:

Current Occupant:

Address:

Phone:

ACCESS

Access Report of 15/1982 was found suitable/unsuitable.

FEATURE
 K4 164 OFFICE Hill End Head North East.
 000 163 164 OFFICE Hill End Head North East.
 047 163 164 OFFICE Hill End Head North East.
 080 163 164 OFFICE Hill End Head North East.
 189 163 164 OFFICE Hill End Head North East.
 293 163 164 OFFICE Hill End Head North East.
 390 Hill End GS CA

Date

Record of Station

CENTRAL MAPPING AUTHORITY

GEODETTIC SURVEY OF N.S.W.

GEODETTIC STATION RECONNAISSANCE and MAINTENANCE REPORT

Description:

Note: Cross out word or words which do not apply

1. Cleared by lanes bearing..... from Trig, Mast
2. Mast & Vans have been painted white & black respectively.
3. The station/pillar was unpiled/not unpiled/constructed on....., dimensions now being:
Description of mark..... should be explicit, e.g., S/Steel Pillar Plate, Steel plug, Brass plug, Bolt, G.I. Pipe
Height of mark.....m, above, below rock/concrete; Mark is.....m, above, below G.L.
4. A..... set in conc/rock has been placed/found, bearing.....°M from Mast/Plug/Pillar
5. A..... set in conc/rock has been placed/found, bearing.....°M from Mast/Plug/Pillar
6. A..... set in conc/rock has been placed/found, bearing.....°M from Mast/Plug/Pillar
7. A..... set in conc/rock has been placed/found, bearing.....°M from Mast/Plug/Pillar
8. Action required:.....

STANDPOINT:

STANDPOINT:

Mark	Direction	Horiz. Distance	Height Difference	Mark	Direction	Horiz. Distance	Height Difference
			above below standpt.				above below standpt.
			above below standpt.				above below standpt.
Prepared by: *L.H.*

Checked:


Noted on U.T.M. Card

St 2738-1

STATION: HILL ENO CS (P)	TS No: 6881
MAP SHEET SCALE 1:250 000	
INSPECTED BY: L.HITCHINS	DATE: 24 2 88
AUTHORITY: C.M.A.	FIELD BOOK:

GS 24

SI 2733-2 D. Vias, Government Printer

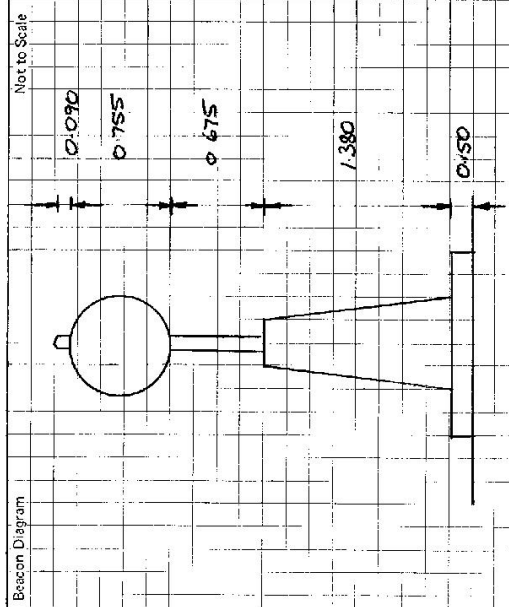STATION <u>HILL END GS (P) TS 6881</u>											
<p>Owner's Name: <u>THE RESERVE</u></p> <p>Address: <u>24404</u></p> <p>Current: <u>256188</u> ORANGE LRD</p> <p>Phone:</p>	<p>Current Occupant:</p> <p>Address:</p> <p>Phone:</p> <p style="text-align: center;"><u>ACCESS</u></p> <p>Access Report of 24/2/1988 was found suitable/unsuitable.</p> <p><u>FEATURE</u></p> <p>0.0. PAS OFFICE HILL END HEAD NORTH EAST</p> <p>0.47 PAS ROYAL HOTEL ON RIGHT GENERAL STORE ON LEFT.</p> <p>0.80 TURN LEFT SKIN BALD HILL LOOKOUT</p> <p>1.89 TURN LEFT SIGN BALD HILL LOOKOUT</p> <p>2.93 PAS TRACK ON RIGHT</p> <p>3.90 HILL END GS (P)</p>										
<p>Beacon Diagram</p>  <p style="text-align: right;">Not to Scale</p>	<p>This section to be completed by officer constructing pillar.</p> <p>Original station mark found/not found.</p> <p>Description of mark:</p> <p>Original beacon found/not found.</p> <p>Description of beacon:</p> <p>Height Top of Vane to Top Mark:m.</p> <p>Height of mark:m. above G.L. below</p> <p>Diameter of Vane:m. Height of Cairn:m.</p> <p>Original Beacon has/not been destroyed by me.</p>										
<table border="1" style="width: 100%; border-collapse: collapse;"> <thead> <tr> <th style="width: 50%;">Date</th> <th style="width: 50%;">Record of Station</th> </tr> </thead> <tbody> <tr> <td style="text-align: center;">24/2/88</td> <td style="text-align: center;">New Mast + Vane Placed</td> </tr> <tr> <td> </td> <td> </td> </tr> <tr> <td> </td> <td> </td> </tr> <tr> <td> </td> <td> </td> </tr> </tbody> </table>		Date	Record of Station	24/2/88	New Mast + Vane Placed						
Date	Record of Station										
24/2/88	New Mast + Vane Placed										