




SI: 2733-2 D. West, Government Printer

STATION (PROPOSED) **WALBERTON (TS 6882)**

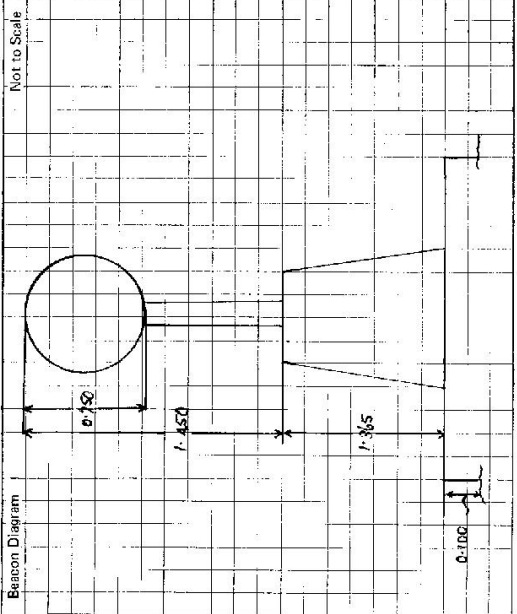

Owner's Name: **K. J. PEARCE**  
 Address: **WYOMING, ILFORD**  
**(ACCESS ROAD FROM SERVICE STATION ILFORD)**  
 Phone: **ILFORD 27**

Current Occupant:  
 Address:  
 Phone:

**ACCESS**

Access Report of **5.4/1988** was found suitable/unsuitable.

- 0.00 **SOPALA P.O. HEAD WEST**
- 0.18 **TURN RIGHT TOWARDS MUDGEES (BRANIST ABEN MUDGEES)**
- 3.97 **AND CROSS TURON RIVER BRIDGE**
- 15.58 **FOUR MILE CREEK (GRAVEL ROAD)**
- 20.13 **BITUMEN ROAD**
- 22.40 **TURN RIGHT (WOOL SHED ON LEFT) FOLLOW TRACK**
- 23.24 **TURN RIGHT JUST BEFORE GATE**
- 23.58 **GRID HEAD TOWARDS GATE BETWEEN SHEARING SHED AND WHITE TANK (PASTING HOUSE ON RIGHT)**
- 23.82 **GATE (WHITE TANK)**
- 23.90 **GATE THEN IMMEDIATELY RIGHT HEAD UP ON TO TOP OF HILL**
- 24.19 **G.S.**

This section to be completed by officer constructing pillar.

Original station mark found/not found.

Description of mark: **NEW STATION**

Original beacon found/not found.

Description of beacon:

Height Top of Vanes to Top Mark: .....m.

Height of mark: .....m. above rock/conc. ....m. below G.L.

Diameter of Vanes .....m. Height of Cairn .....m.

Original Beacon has/has not been destroyed by ms.

Date	Record of Station

**LAND INFORMATION CENTRE**

GEODETIC SURVEY OF N.S.W.

**GEODETIC STATION RECONNAISSANCE and MAINTENANCE REPORT**

STATION: **WALBERTON (P)** No.: **6882**

MAP SHEET  
SCALE 1:250 000

**BATHURST**

INSPECTED BY: **C. FORD** DATE: **23-10-92**

AUTHORITY: **L.I.C.** FIELD BOOK: **—**

Description:

1. Cleared by vanes bearing **CLEAR FOR C.P.S.** Note: Cross out word or words which do not apply

2. Mast & Vanes have been painted white & black respectively.

3. The station/pillar was unpiled/not unpiled/constructed on..... 19....., dimensions now being:

Description of mark..... should be explicit, e.g., S/Steel Pillar Plate, Steel plug, Brass plug, Bolt, G.I. Pipe

Height of mark.....m. <sup>above</sup> rock/concrete; Mark is.....m. <sup>above</sup> G.L. <sub>below</sub>

Height of Top Vanes to Top Mark/Pillar plate .....m. Diameter of Vanes (vertical).....m.

Height of Cairn.....m. Diameter of Cairn.....m. Name Plate found/not found/placed.

Length of Mast .....m. (approximate if not unpiled)

4. A.....set in conc/rock has been placed/found; bearing.....°M from Mast/Plug/Pillar

5. A.....set in conc/rock has been placed/found; bearing.....°M from Mast/Plug/Pillar

6. A.....set in conc/rock has been placed/found; bearing.....°M from Mast/Plug/Pillar

7. A.....set in conc/rock has been placed/found; bearing.....°M from Mast/Plug/Pillar

8. Action required:.....

**STANDPOINT:**

**STANDPOINT:**

Mark	Direction	Horiz. Distance	Height Difference	Mark	Direction	Horiz. Distance	Height Difference
			above standpt.				above standpt.
			below				below
			above standpt.				above standpt.
			below				below
Prepared by: **S. Ford 26/10/92**

Checked:

Noted on U.T.M. Card

Checked

