

TS 6892  
No.: 4059

STATION: **SENTRY BOX**  
MAP SHEET  
SCALE 1:250 000  
INSPECTED BY: **D. MOSS**  
AUTHORITY: **C.M.A**

MANILLA  
DATE: **19-3-82**  
FIELD BOOK: **2000**

CENTRAL MAPPING AUTHORITY  
GEODETTIC SURVEY OF NSW.  
GEODETTIC STATION RECONNAISSANCE and MAINTENANCE REPORT

Description:  
Note: Cross out word or words which do not apply

- Cleared by Vanes bearing  $356^{\circ} - 22'$   $45^{\circ} - 356'$  from Trig. Mast
- Mast & Vanes have been painted white & black respectively.
- The station/~~marker~~ was ~~erected~~/not uplied/~~constructed~~ on  $19^{\text{th}}$  March 19  $82$ , dimensions now being:  
Description of mark..... should be explicit, e.g., S/Steel Pillar Plate, Steel plug, Brass plug, Bolt, G.I. Pipe  
Height of mark..... m. above rock/concrete; Mark is..... m. above below G.L.  
Height of Top Vanes to Top Mark/Pillar plate..... m. Diameter of Vanes (vertical)..... m.  
Height of Cairn..... m. Diameter of Cairn..... m. Name Plate found/not found/placed.  
Length of Mast..... m. (approximate if not uplied)
- A..... S.S.M..... set in conc/~~rock~~ has been ~~placed~~/found, bearing  $181^{\circ}$  M from Mast/~~Plug/Pillar~~
- A..... G.I.P..... set in ~~concrete~~/~~rock~~ has been ~~placed~~/found, bearing  $251^{\circ}$  M from Mast/~~Plug/Pillar~~
- A..... set in conc/rock has been placed/found, bearing..... M from Mast/Plug/Pillar
- A..... set in conc/rock has been placed/found, bearing..... M from Mast/Plug/Pillar

8. Action required: CONSTRUCT CONCRETE PILLAR 1 Ha Clearing investigate the impedes mentioned

STANDPOINT:		STANDPOINT:		STANDPOINT:		STANDPOINT:	
Mark	Direction	Horiz. Distance	Height Difference	Mark	Direction	Horiz. Distance	Height Difference
DRUMMOND	$299^{\circ} 33'$	9.3	above standpt.	BRADLEY	$134^{\circ} 52'$	16.3	above standpt.
HAYSTACK	$170^{\circ} 38'$	12.1	below				below
GEORGES MTN	$86^{\circ} 49'$	20.5	above standpt.				below
CLENAIRE	$346^{\circ}$	17.6	below				above standpt.
TINKHA	$53^{\circ} 03'$	25.0	above standpt.				below
BRADLEY	$111^{\circ} 30'$	29.0	below				above standpt.
RANKIN	$135^{\circ} 11'$	29.5	above standpt.				below

Prepared by: *[Signature]* Checked: *[Signature]* Noted on U.T.M. Card



Station Diagram  
Not to Scale  
M.A.C. North

Checked

Sr 2733-1





G


STATION **SENTRY Box G.S. (P)** TS 6892

Owner's Name: **R. FOUST**  
 Address: **MOONPAR**  
 Phone: **BANDARAO 16H**

Current Occupant: .....  
 Address: .....  
 Phone: .....

ACCESS **13-5-1982**

Access Report of **19/3/1982** was found suitable/unsuitable.  
**BONDARAO PO HEAD SOUTH.**  
 0 0 TURN RIGHT ONTO CANAL ROAD.  
 0 20 PASS ROAD ON R.H.S.  
 0 69 CROSS GRID  
 0 52 PASS ROAD ON R.H.S TO OWNERS HOUSE SIGN 'MOONPAR'  
 0 79 TURN LEFT THROUGH IRON GATE. FOLLOW TRACK  
 0 92 THROUGH WHITE WOODEN GATE+TURN RIGHT OFF TRACK FOLLOW FENCE.  
 0 95 CROSS GULLY  
 0 03 PASS WIRE GATE ON RIGHT.  
 0 20 THROUGH WIRE GATE, THEN TURN LEFT+ FOLLOW FAINT TRACK UP HILL.  
 0 87 VEER HARD RIGHT.  
 0 87 VEER SLIGHTLY LEFT.  
 0 96 VEER HARD LEFT AROUND SWAMP  
 0 11 VEER RIGHT.  
 0 13 VEER HARD LEFT AROUND ROCKS  
 0 44 SENTRY Box G.S.(P) /

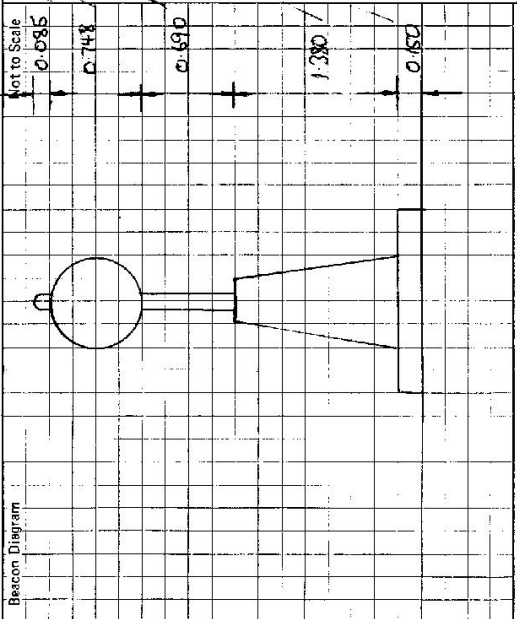

This section to be completed by officer constructing pillar.

Original station mark found/~~not found~~.

Description of mark: **BRASS TOIC PIN**

Original beacon found/~~not found~~.

Description of beacon: **CAIRN POLE + DISCS**

Height Top of Vanes to Top Mark: **3.740** m.

Height of mark: **FLUSH** m. **about** WITH **about** G.L.  
 below **rock/conc** 0.200 m. below

Diameter of Vanes: **1.010** m. Height of Cairn: **1.800** m.

Original Beacon has/~~has not~~ been destroyed by me.

Date	Record of Station



