








2735-2 D. West, Government Printer

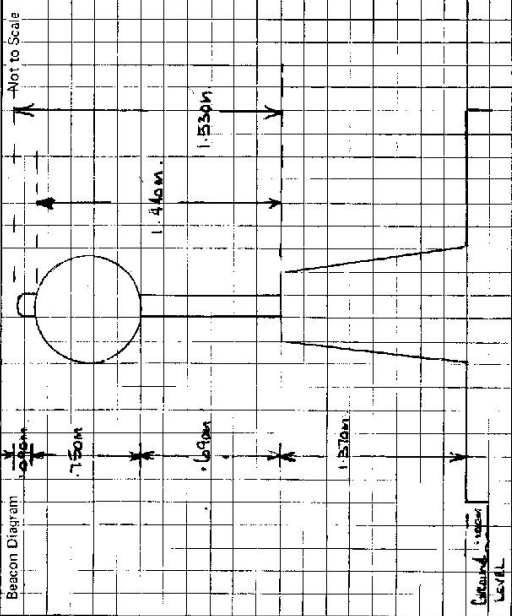

This section to be completed by officer constructing pillar.

Original station mark found/~~not found~~.

Description of mark: Carriage bolt

Original beacon found/~~not found~~.

Description of beacon: Pole

Height Top of Vane to Top Mark: 3.89 m.

Height of mark: 1.60 m. above 1.50 m. ~~below~~ G.L.

Diameter of Vane: 1.05 m. Height of Cairn: 1.05 m.

Original Beacon has/~~has not~~ been destroyed by me.

STATION <u>Sulace Carr. obs. pillar TS 6893</u>	
Owner's Name: <u>MR. Nick Bennett</u>	Current Occupant: .....
Address: <u>Kooyana, Murrumbidgee</u>	Address: .....
Phone: <u>(047) 49 55094</u>	Phone: .....
ACCESS	
Access Report of <u>23/10/86</u> was found suitable/ <del>unsuitable</del> . With My additions.	
FEATURE	
<u>0.00</u> <u>Mungah Hotel, Travel North Toward Manilla.</u>	
<u>6.30</u> <u>Cross Browns Springs Creek.</u>	
<u>10.23</u> <u>Turn Right off Main Road. (Left over road for 3.5 Kms.</u>	
<u>10.45</u> <u>Through Iron Gate at Yards (Key to this lock is hanging to owners house.)</u>	
<u>11.49</u> <u>on Piece of wire on R.H.S. (Gate Post.)</u>	
<u>11.78</u> <u>Through Iron Gate.</u>	
<u>11.86</u> <u>Past Wind Pump on the L.H.S.</u>	
<u>11.93</u> <u>Through Iron Gate - head down along bottom side of sheep yards.</u>	
<u>12.03</u> <u>Through Iron Gate - Track heads over to the left.</u>	
<u>12.34</u> <u>Cross Gully</u>	
<u>12.76</u> <u>Track Vane Left at Top of Ridge.</u>	
<u>13.00</u> <u>Vane Left and head along ridge.</u>	
<u>13.00</u> <u>Through Iron Gate in fence on your left.</u>	
<u>13.16</u> <u>Sulace concrete observation pillar on Northern side of Netting fence.</u>	
In Dry weather a conventional type vehicle could be driven to this station	
Date	Record of Station