

GEODETTIC SURVEY OF N.S.W.

CENTRAL MAPPING AUTHORITY


GEODETTIC STATION RECONNAISSANCE and MAINTENANCE REPORT

STATION: BELFIELD No: 6894-8925

MAPSHEET SCALE 1:250 000 DORRICO

INSPECTED BY: D. KINLYSIDE DATE: 16.3.82

AUTHORITY: C.M.A. FIELD BOOK: 1994 FILE 5511783

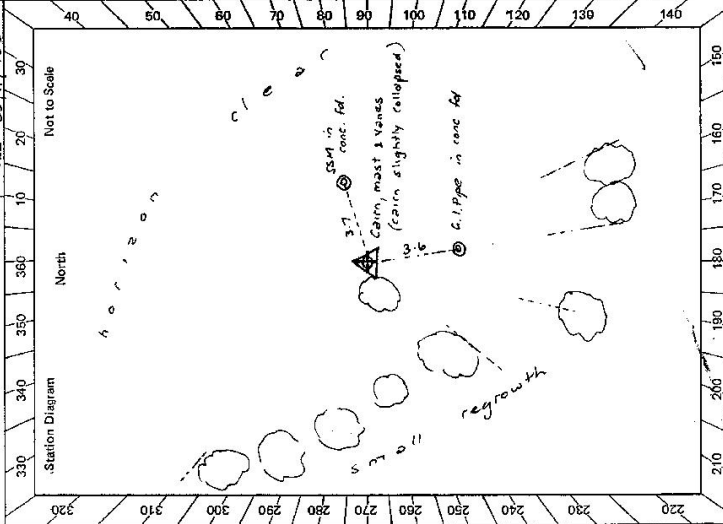

- Description: Note: Cross out word or words which do not apply
- Cleared by lanes bearing..... from Trig. Mast
 - Mast & Vanees have been painted white & black respectively.....
 - The station/pillar was unpiled/not unpiled..... dimensions now being: 10.....
- Description of mark..... should be explicit, e.g., S/Steel Pillar Plate, Steel plug, Brass plug, Bolt, G.I. Pipe
- Height of mark..... m. above below rock/concrete, Mark is..... m. above below G.I.
- Height of Top Vanees to Top Mark/Pillar plate..... m. Diameter of Vanes (vertical)..... m.
- Height of Cairn..... m. Diameter of Cairn..... m. Name Plate found/not found/pileed-
- Length of Mast..... m. (approximate if not unpiled)
- A..... set in conc/rock has been placed/found, bearing.....° M from Mast/Pillar/Pillar
 - A..... set in conc/rock has been placed/found, bearing.....° M from Mast/Pillar/Pillar
 - A..... set in conc/rock has been placed/found, bearing.....° M from Mast/Pillar/Pillar
 - A..... set in conc/rock has been placed/found, bearing.....° M from Mast/Pillar/Pillar
- Action required.....

Mark	Direction and bearing	Horiz. Distance	Height Difference above/below	Mark	Direction	Horiz. Distance	Height Difference above/below
TREVELLIE	55° 13'	7.5	above Pillar				above standpt.
LITTLE DUNAL	32 55'	6.9	above Pillar				above standpt.
LONG FORD	3 16 53'	14.2	above C.M.M.P.				above standpt.
HARNHAM HILL	191° 12'	34.4	above hill				above standpt.
YARROWYCK	240° 12'	16.7	above hill				above standpt.
COLDSNORTH	218° 48'	22.4	above hill				above standpt.

STANDPOINT: NEAR PLUG

Prepared by: D. Kinlyside Checked: Noted on U.T.M. Card

CENTRAL MAPPING AUTHORITY

GEODETIC SURVEY OF N.S.W.
 GEODETTIC STATION RECONNAISSANCE and MAINTENANCE REPORT

STATION: BELFIELD (P) No: 6894

MAP SHEET SCALE 1:250 000 D0621610

INSPECTED BY: C. PARULES DATE: 3/6/22

AUTHORITY: C.M.A. FIELD BOOK: 1872

Description: *Note: Cross out word or words which do not apply*

1. Cleared by lanes bearing..... from Trig. Mast

2. Mast & Vanes have been painted white & black respectively. ✓

3. The station/pillar was ~~unplaced~~ constructed on..... 19.02m, dimensions now being: S/STEEL

Description of mark..... should be explicit, e.g., S/Steel Pillar Plate, Steel plug, Brass plug, Bolt, G.I. Pipe

Height of mark..... m. ^{above} ~~below~~ ~~concrete~~ Mark is..... m. ^{above} G.L.

Height of Top Vanes to Top Mark/Pillar plate m. Diameter of Vanes (vertical)..... 750m.

Height of Cairn..... m. Diameter of Cairn..... m. Name Plate found/not found/placed.

Length of Mast m. (approximate if not unpled)

4. A..... set in conc/rock has been placed/found, bearing.....° M from Mast/Plug/Pillar

5. A..... set in conc/rock has been placed/found, bearing.....° M from Mast/Plug/Pillar


6. A..... set in conc/rock has been placed/found, bearing.....° M from Mast/Plug/Pillar

7. A..... set in conc/rock has been placed/found, bearing.....° M from Mast/Plug/Pillar

8. Action required.....

STANDPOINT:	Mark	Direction	Horiz. Distance	Height Difference	Mark	Direction	Horiz. Distance	Height Difference
PILLAR SIGHT	CONCRETE (P)	0 00 00		above standpt	CONCRETE (P)	0 00 00		above standpt
	G.I. PIPE	17 19 15	3.323	below standpt	CONCRETE (P)	0 00 00		above standpt
	STEEL TRIG. PLUG	84 33 45	3.038	below standpt	CONCRETE (P)	0 00 00		above standpt
	S.S.M.	98 03 40		above standpt	S.S.M.	215 51 10	3.630	below standpt
	TRIDELLE (P)	160 05 10	2.815	below standpt	TOP PILLAR SIGHT	064 32 05	3.100	above standpt
		146 04 50		above standpt	TRIDELLE (P)	296 24 55		above standpt
				below standpt	G.I. PIPE	323 56 50	3.560	below standpt

 Prepared by: C. PARULES Checked: W. HARRIS Noted on U.T.M. Card



Not to Scale

Checked

81-2733-1


51-2735-2 D. West, Government Printer

STATION

ABELFIELD (B) * 6894

Beacon Diagram

Not to Scale

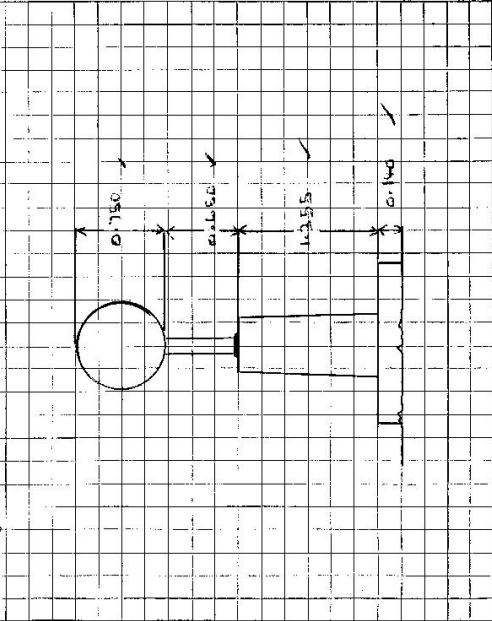

Owner's Name: THE UNIVERSITY OF NEW ENGLAND
 Address: ARMADALE, NEW SOUTH WALES OFFICE
 Phone: 72 43008 ✓
 ACCESS

Access Report of 16/3/1988 was found suitable/unsuitable

- 01.00 INTERSECTION OF BEAUFY STREET & NEW ENGLANDS HIGHWAY, ARMADALE (NEAR ROYAL HOTEL) HEADS NORTH TOWARDS CORNER.
- 01.12 TURN LEFT SIGN "UNIVERSITY OF NEW ENGLAND".
- 01.13 TAKE RIGHT FORK.
- 01.45 PASS ROAD ON L.H.S.
- 01.25 PASS ROAD ON L.H.S.
- 01.11 PASS WARRANE ROAD ON L.H.S. (CORNER OF ACCESS LINES 2.4 KM NORTH THIS ROAD ON L.H.S. AT "RUMLEY").
- 01.08 CROSS BRIDGE OVER RAILWAY LINE.
- 01.19 TURN LEFT OFF BRIDGEMAN & THROUGH WOODS NEW GATE (CORNER FITTED).
- 01.08 TURN RIGHT & HEAD ALONG FEASLE.
- 01.08 THROUGH WOODS NEW GATE - HEAD IN NEW DIRECTION TO SADDLE THROUGH LEAVE VEHICLE & 1 MINUTE WALK TO TOWER.

NUMBER OF ACCESS
 Current Count: 6894
 Address: ARMADALE
 Phone: 75114
 MANAGER: G. TAYLOR 75111

This section to be completed by officer constructing pillar.

Original station mark found/~~not found~~.
 Description of mark: SILVER T.M.C. P.O. BOX 1000, SYDNEY ✓
 Original beacon found/~~not found~~.
 Description of beacon: CONCRETE BEACON WITH 5 VANES
 Height Top of Vanes to Top Mark: 2.5128 m. ✓
 Height of mark: 2.5166 m. above G.L. ✓
 Diameter of Vanes: 1.5000 m. ✓ Height of Cairn: 1.1300 m. ✓
 Original Beacon has ~~been~~ been destroyed by me.

Date	Record of Station